


PART SECTION IN WAY OF DUCT KEEL

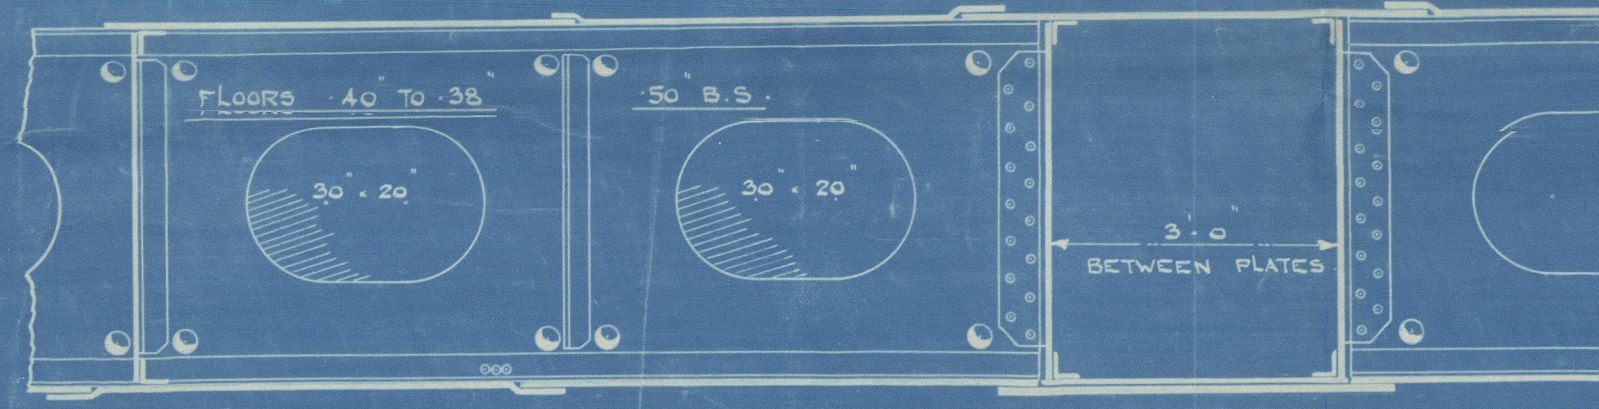

KEEL 50 . 94 WITH 50 DOUBLING
INSIDE FULL LENGTH OF DUCT KEEL (OWNERS REQUIREMENTS)
KEEL BUTTS TO HAVE 76 OUTSIDE
STRAP QUAD RIV. NO INSIDE STRAP
ON KEEL OR DOUBLING

"Lunness S.B. Co. Ltd" "Lorrain"
S.S. N° 27. S.S. "Egyptian Prince".
ex.

Midship Section. As built.

MIDDLESBROUGH Report No. 11445



© 2021

Lloyd's Register
Foundation

006668-006674-0257