



19.11.06

PROFILE AND DECK PLAN

S. S. N° 387.

SCALE 1/4" = 1 FOOT

DIMS 128'0" x 22'0" EX x 11'0" DEPTH OF HOLD.

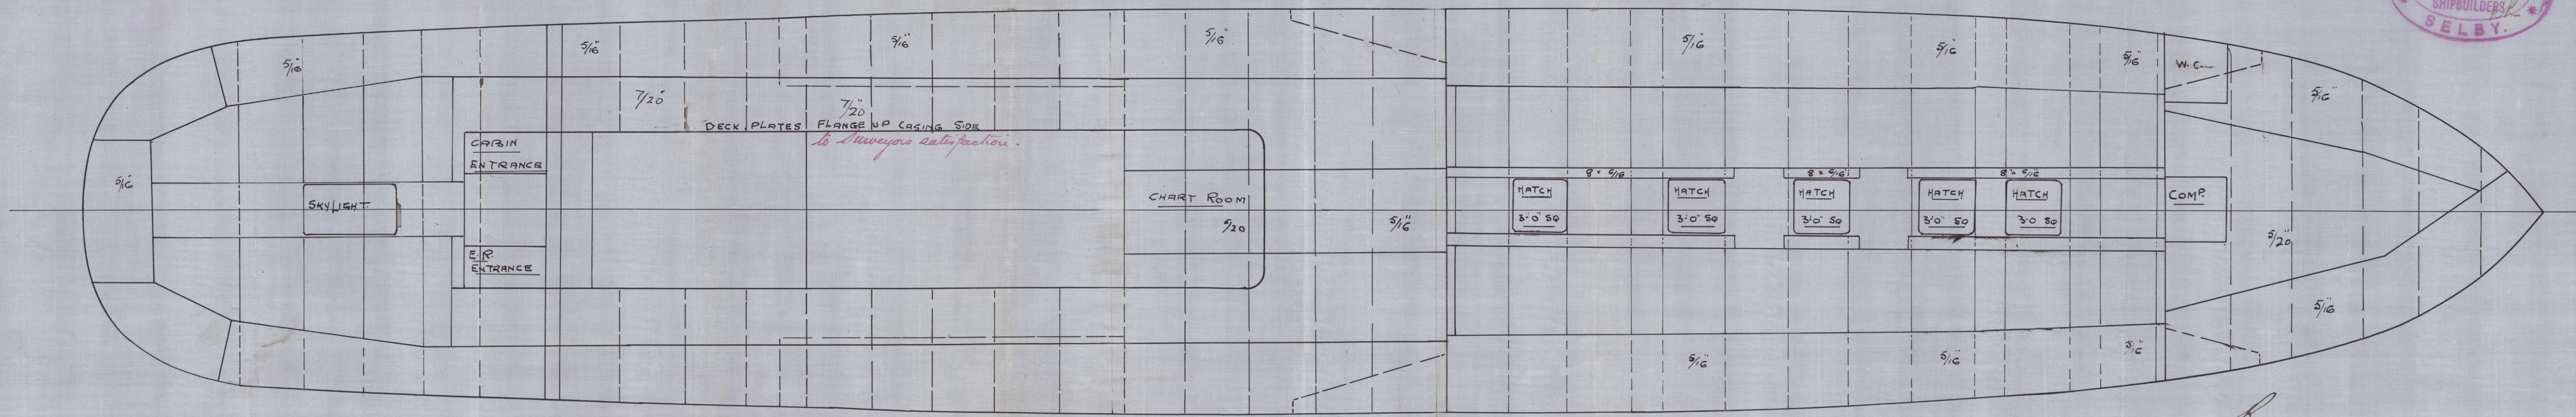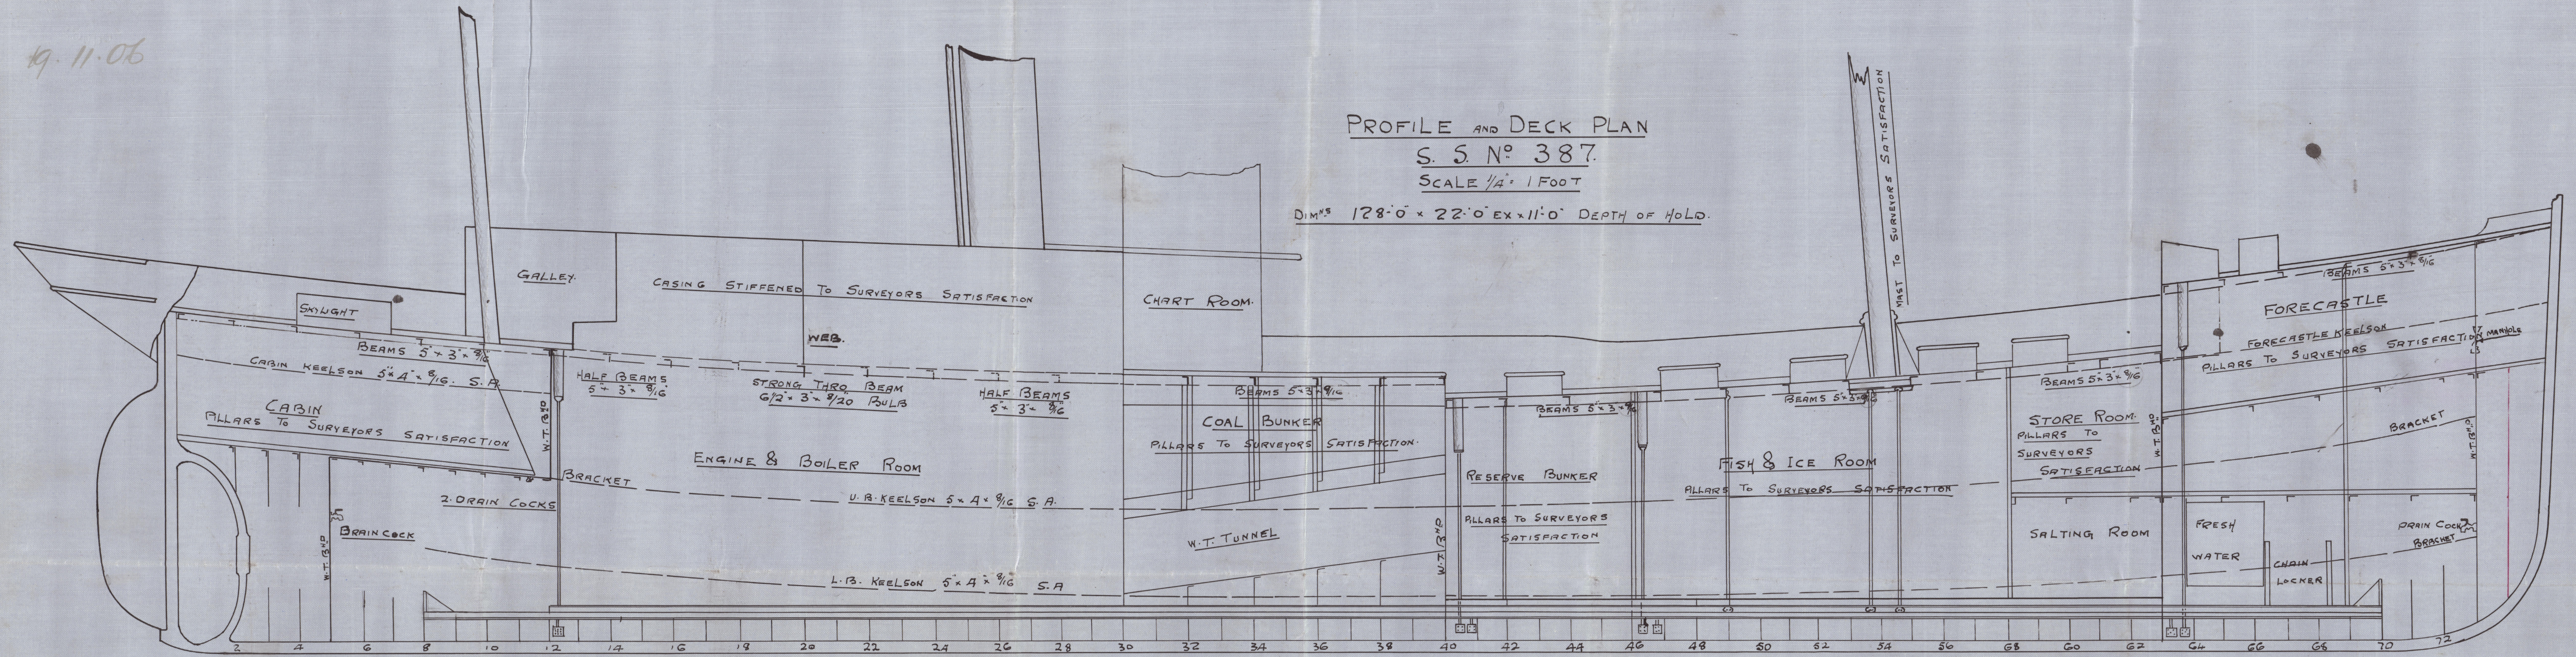

c.b.
19.11.06.

Handwritten notes in red ink at the bottom left of the page, including "1/20" and "to Surveyors satisfaction".

006680-006693-0121

