
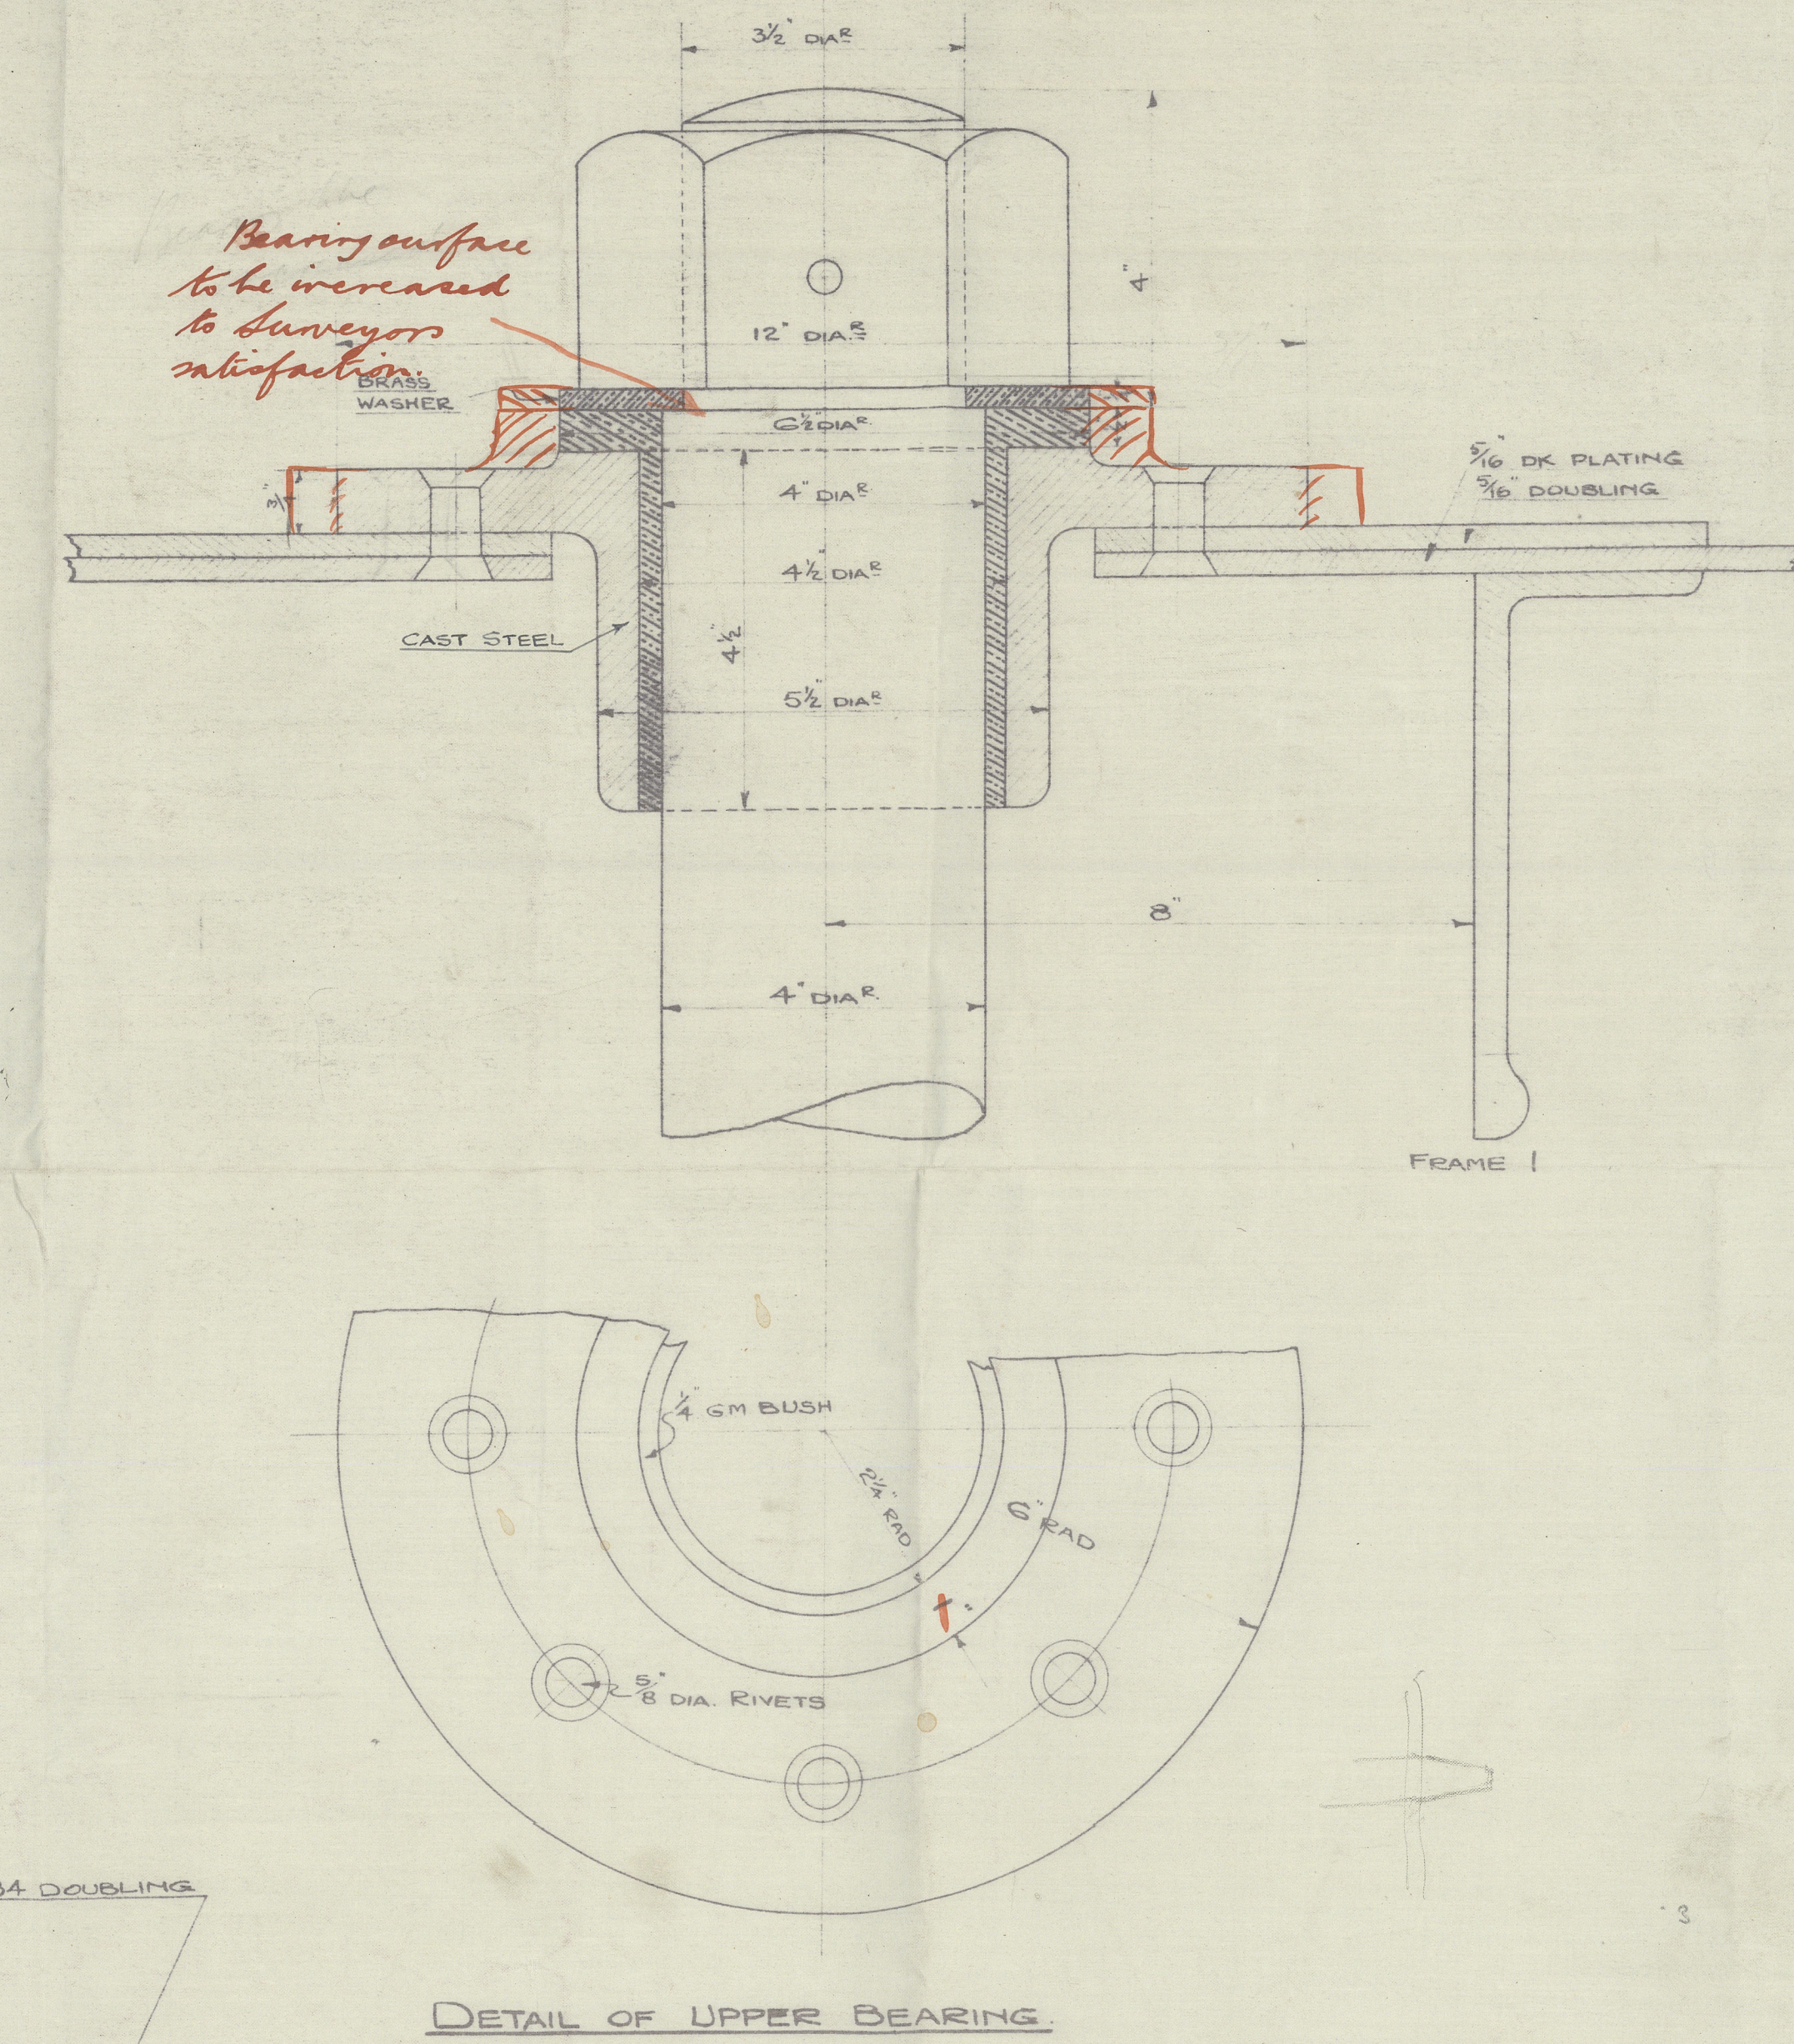
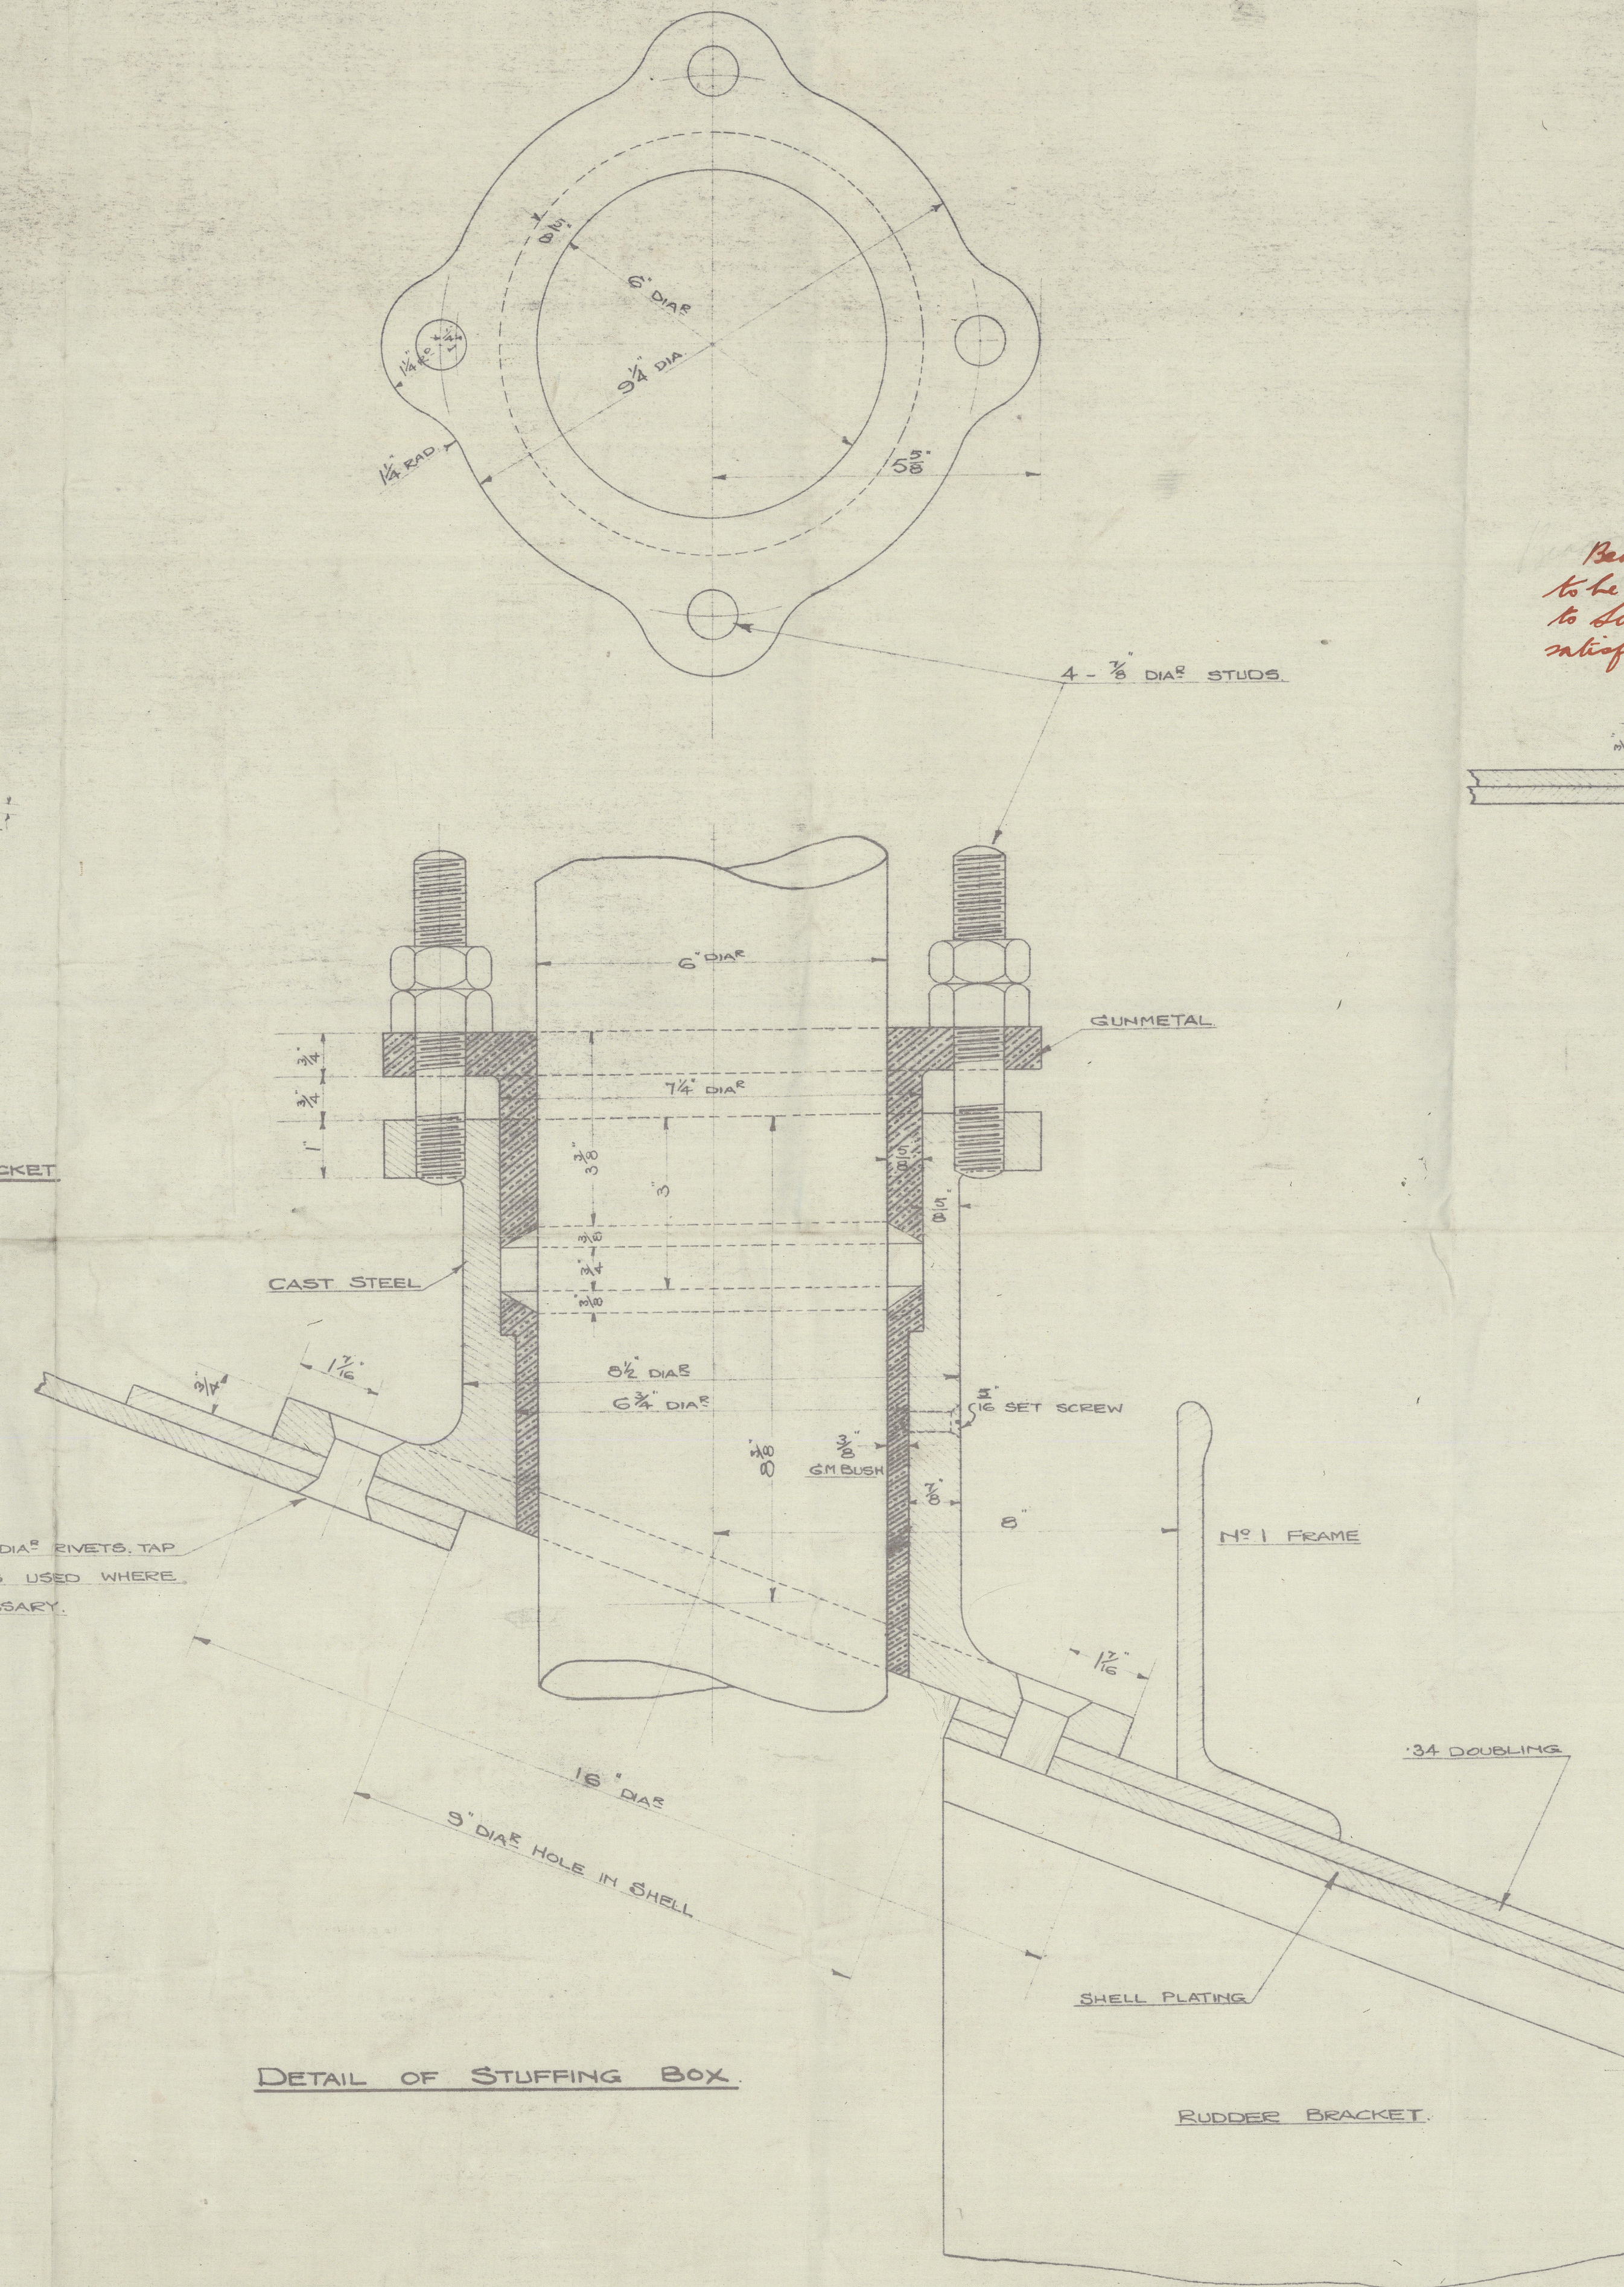
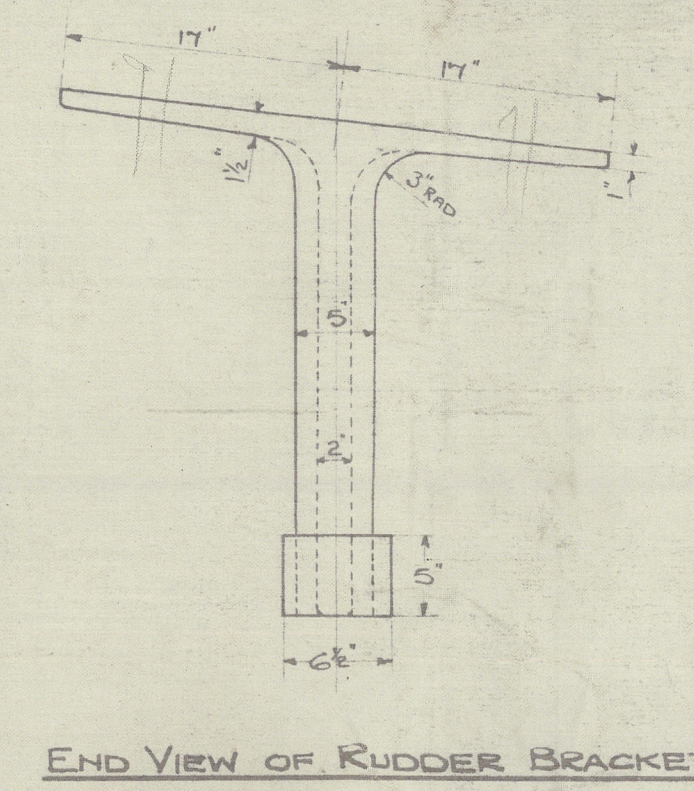
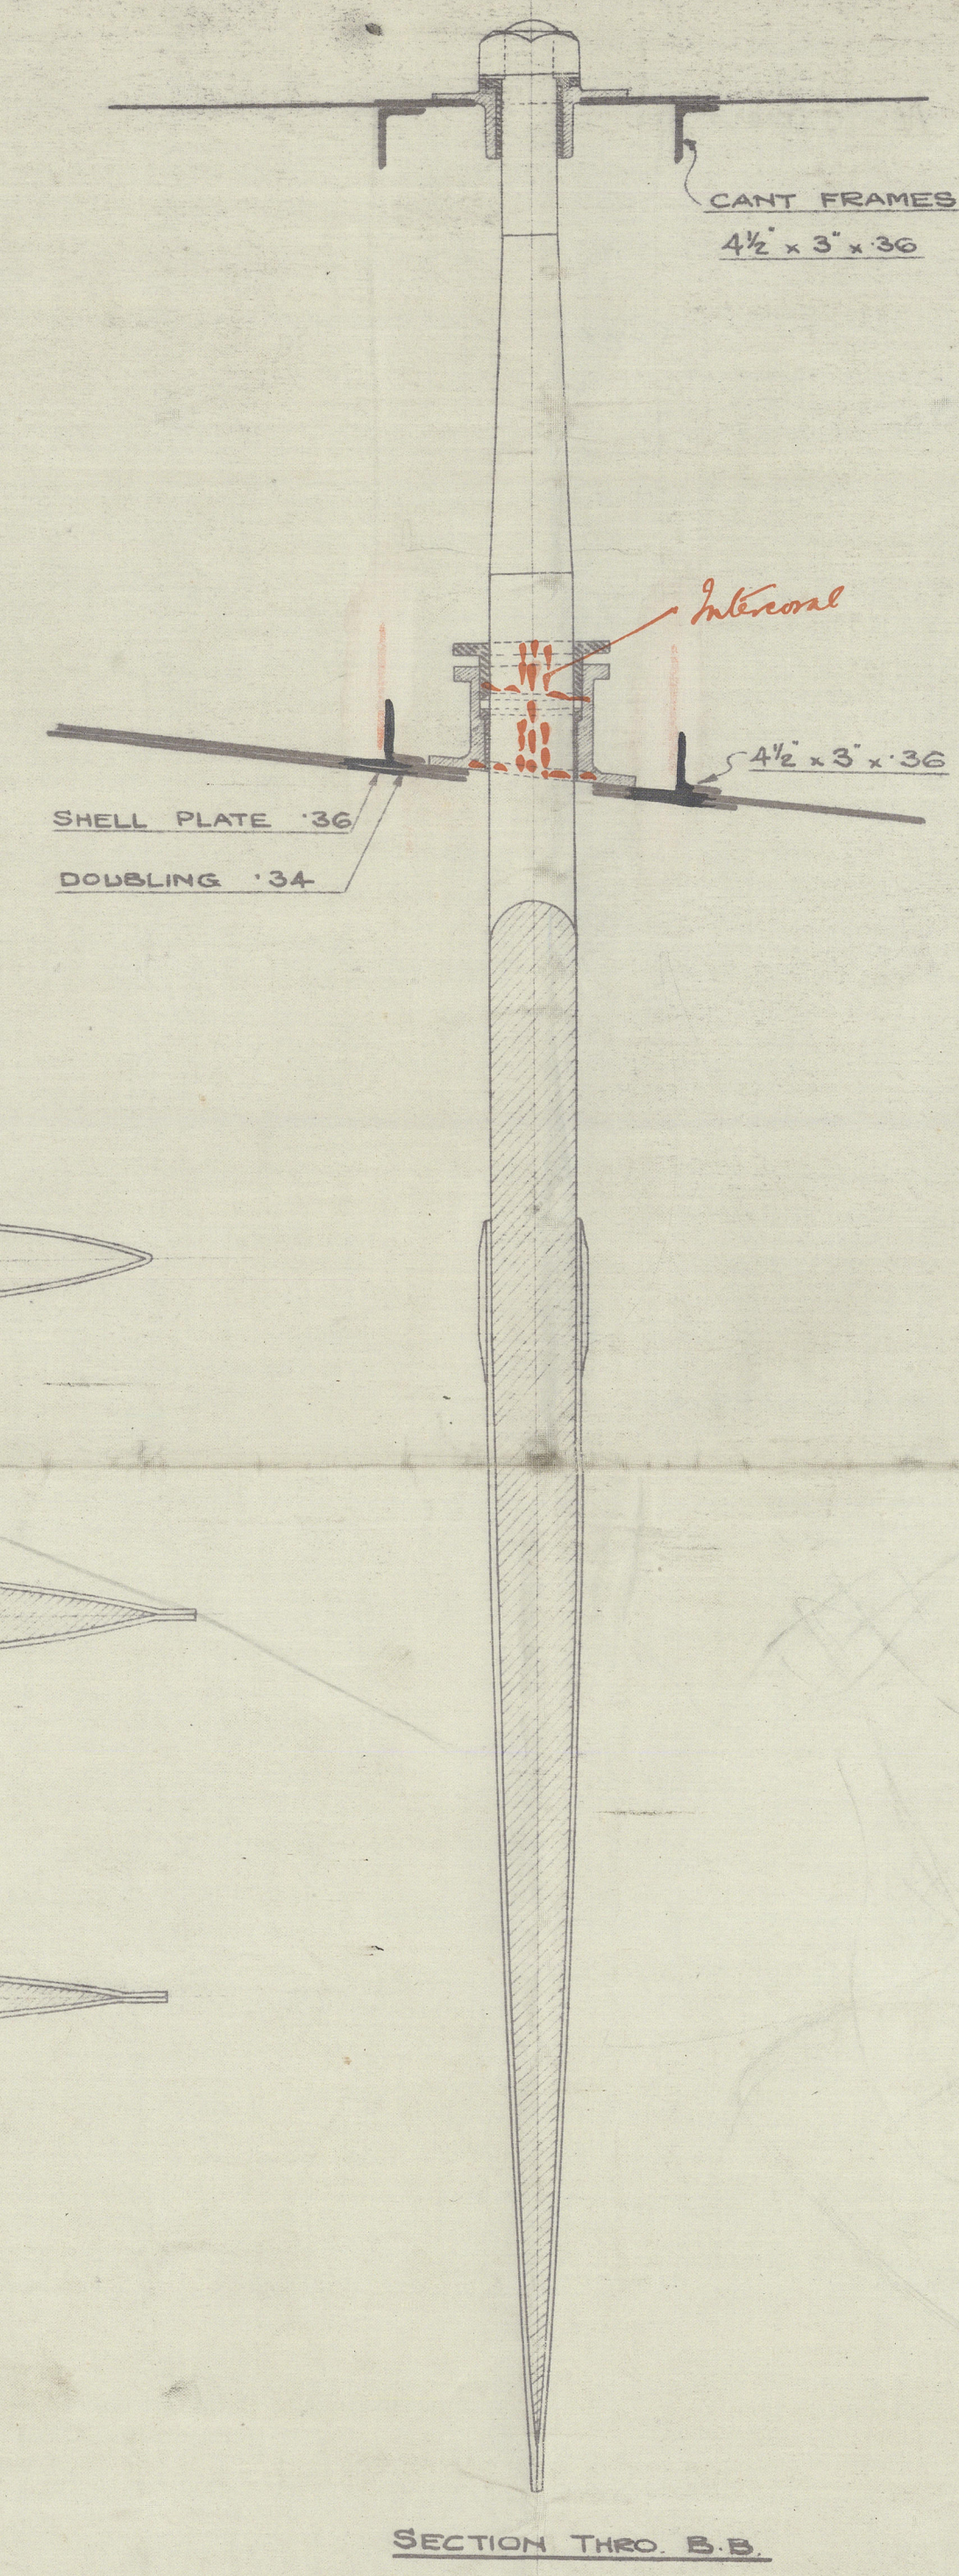
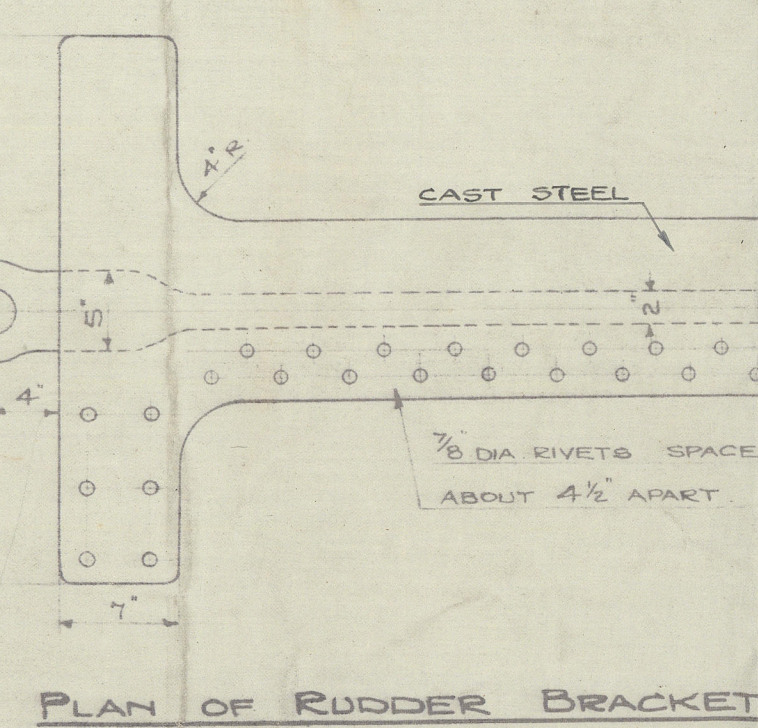


# RUDDERS & SUPPORTS.

SCALE 1" = 1 FOOT  
DETAILS 1/2 SIZE

1 OFF PORT  
1 OFF STARBOARD

29.10.20

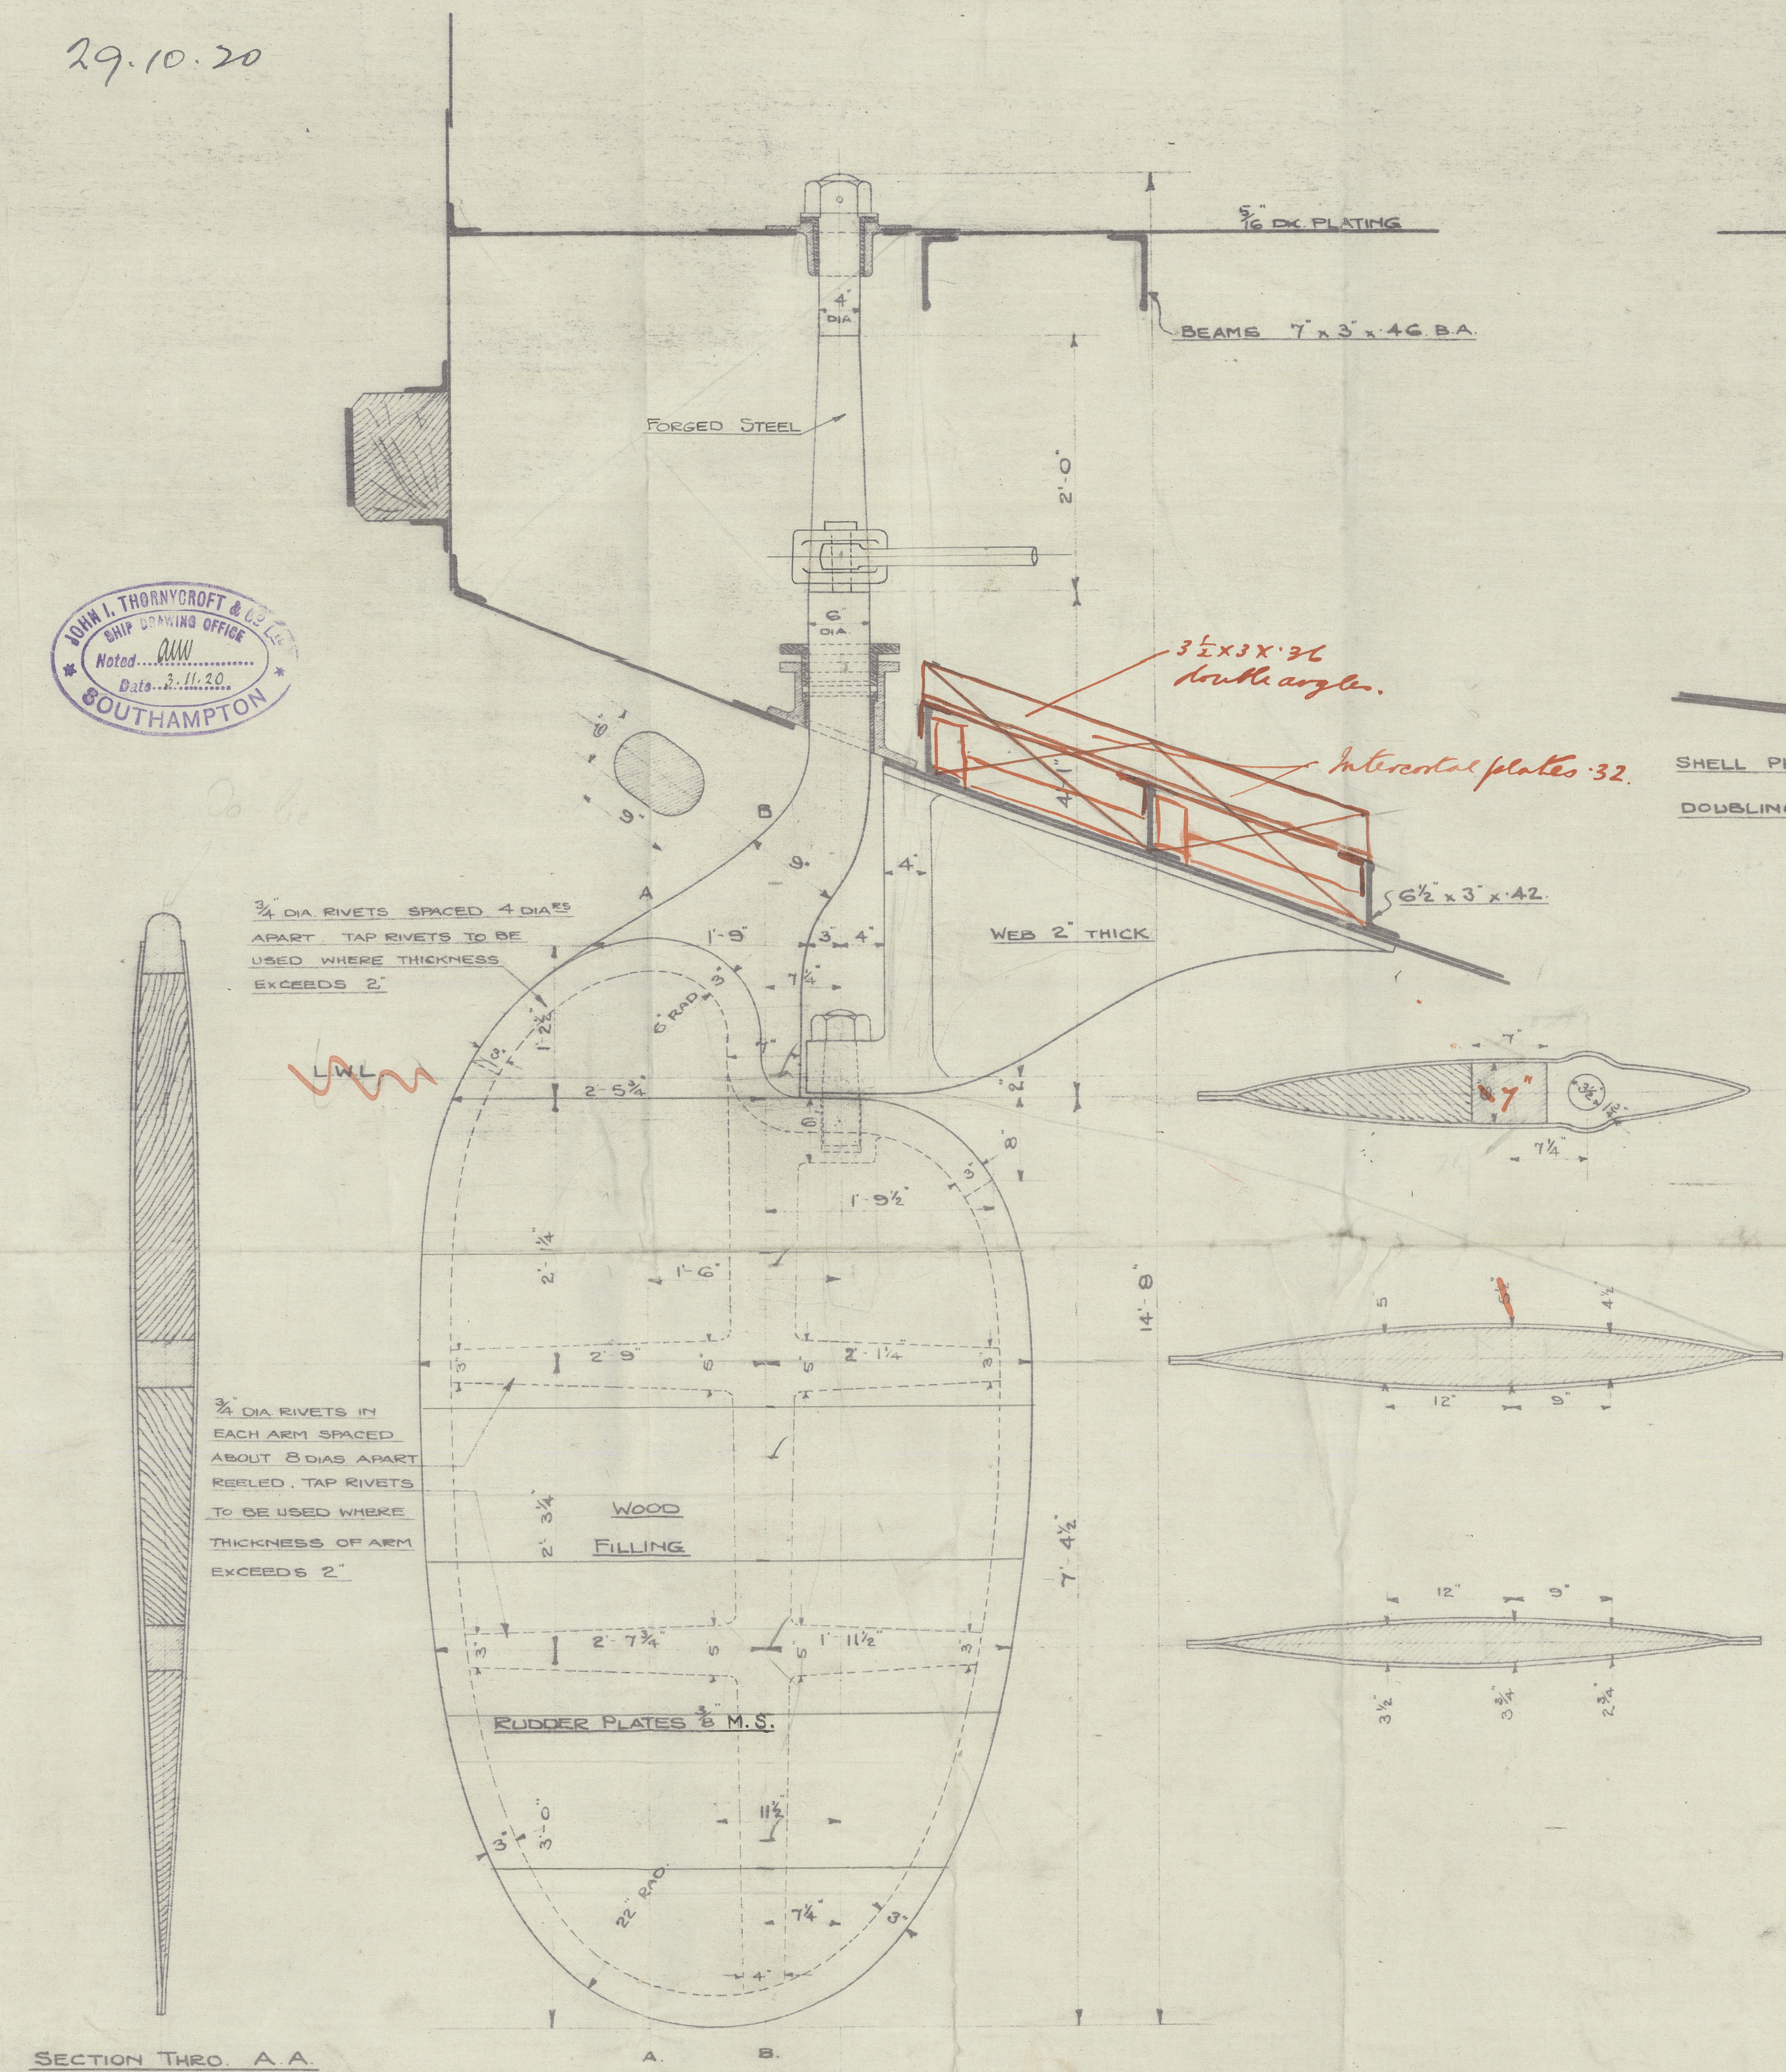

Speed not to exceed 12 knots.

29.10.20.



Messrs J. D. Thornycroft & Co. Ltd  
Southampton.

Rudder Supports for

S. B. Yano N<sup>os</sup> 1004-5.

(River Mersey Ferries)

Made by Messrs N. Somers & Co

**LISCARD.**

See 1103.



© 2021

Lloyd's Register  
Foundation

006694-006704-0163