



9/7/20

PROFILE & DECK.


SCALE 1" = 1 FT

100A1

TO CLASS ~~A-1~~ FOR FERRY PURPOSES.

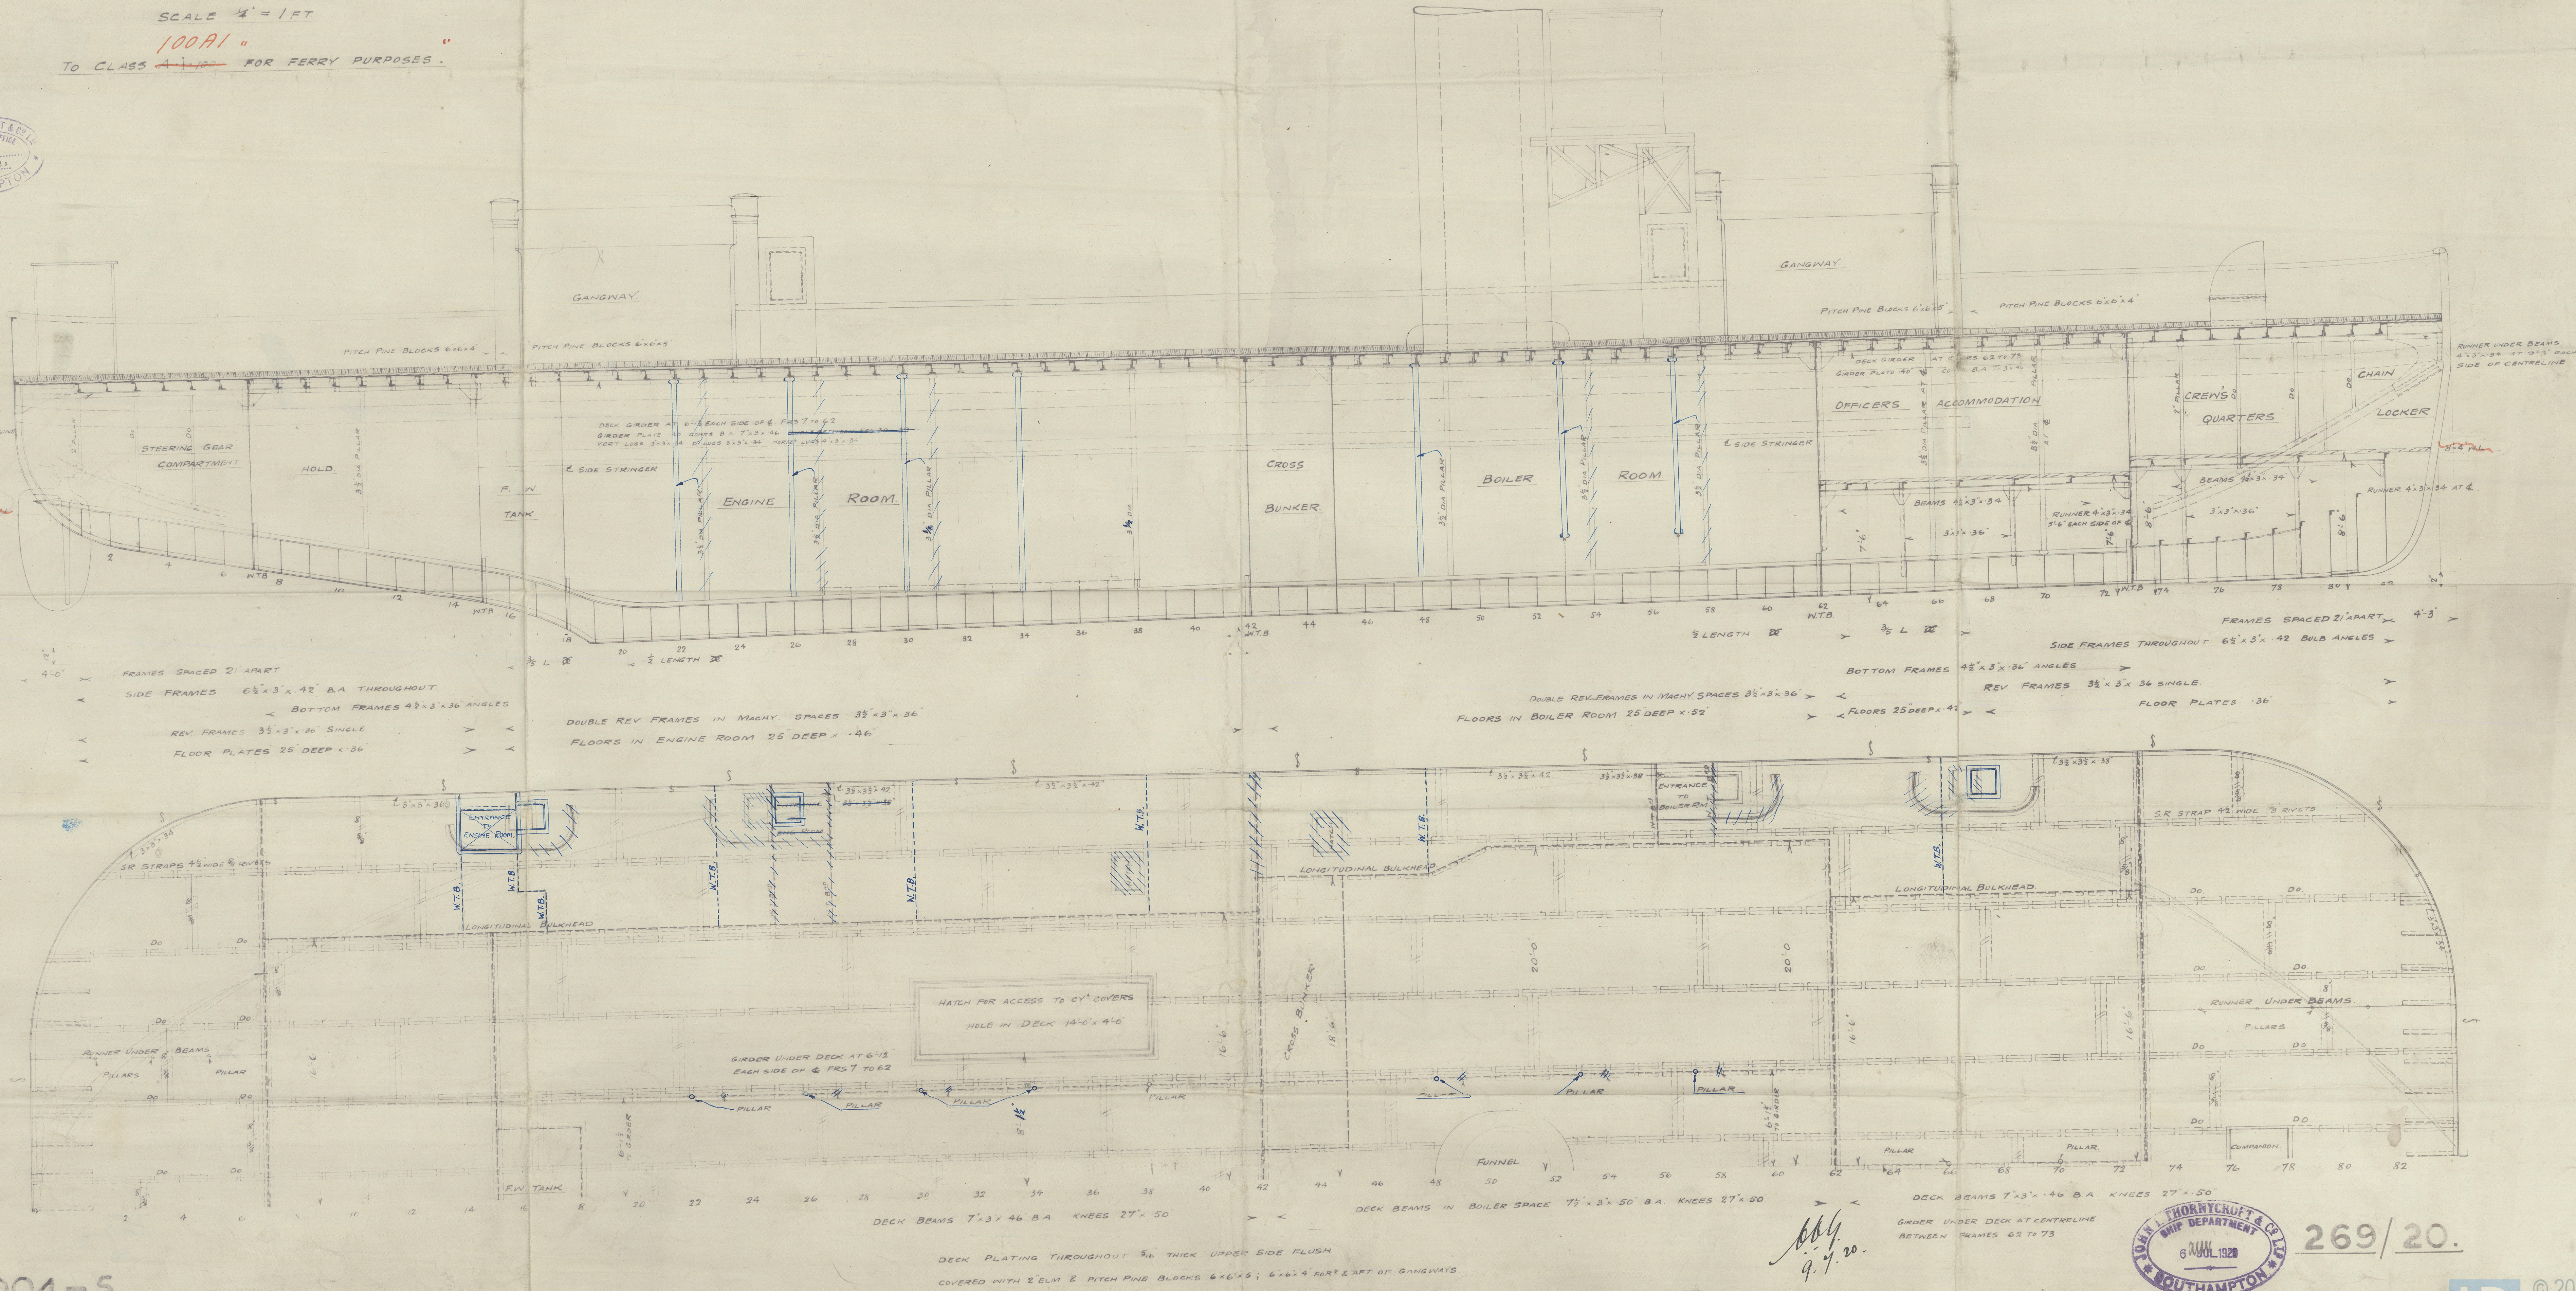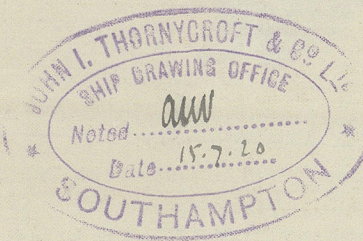

1004-5.

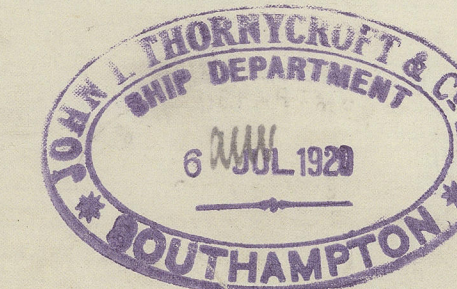

269/20.

Messrs J. S. Thornycroft

~~+~~ & Co.

Southampton.

Profile Deck Plan

for Yarn Nos 1004-5

Ferry Steamer for

River Mersey.

• LISCARD •

See 1103.



© 2021

Lloyd's Register
Foundation

006694-006704-0164