

S.S N^o 374

DIM^{NS} LENGTH 119¹ 0' BREADTH 22¹ 0' DEPTH M^{LD} 12¹ 3'

SCALE $\frac{1}{2}$ " - 1 FOOT

TO BE CLASSED 100. A.1. AT LLOYDS FOR FISHING PURPOSES.
ENGINE & BOILER CASING AS PREVIOUSLY APPROVED


DECK PLATED OVER AT SIDES OF CASING

1/2 GIRTH	19' 0"
1/2 BREADTH	10' 9 1/2"
DEPTH	12' 40"
LLOYDS 1 ST NUMERAL	42' 6 1/2"
LENGTH AS PER RULE	118' 10"
LLOYDS 2 ND NUMERAL	19943150

B to L 5.73


D to L 9.2

1 ST	BOWER ANCHOR	5 CWTs EX STOCK
2 ND	" "	4 1/2 " " "
3 RD	" "	2 1/2 " " "
90	FATHOMS	1" SHORT LINK CABLE
60	"	5 1/2" HAWSER
60	"	4 1/2 WARP

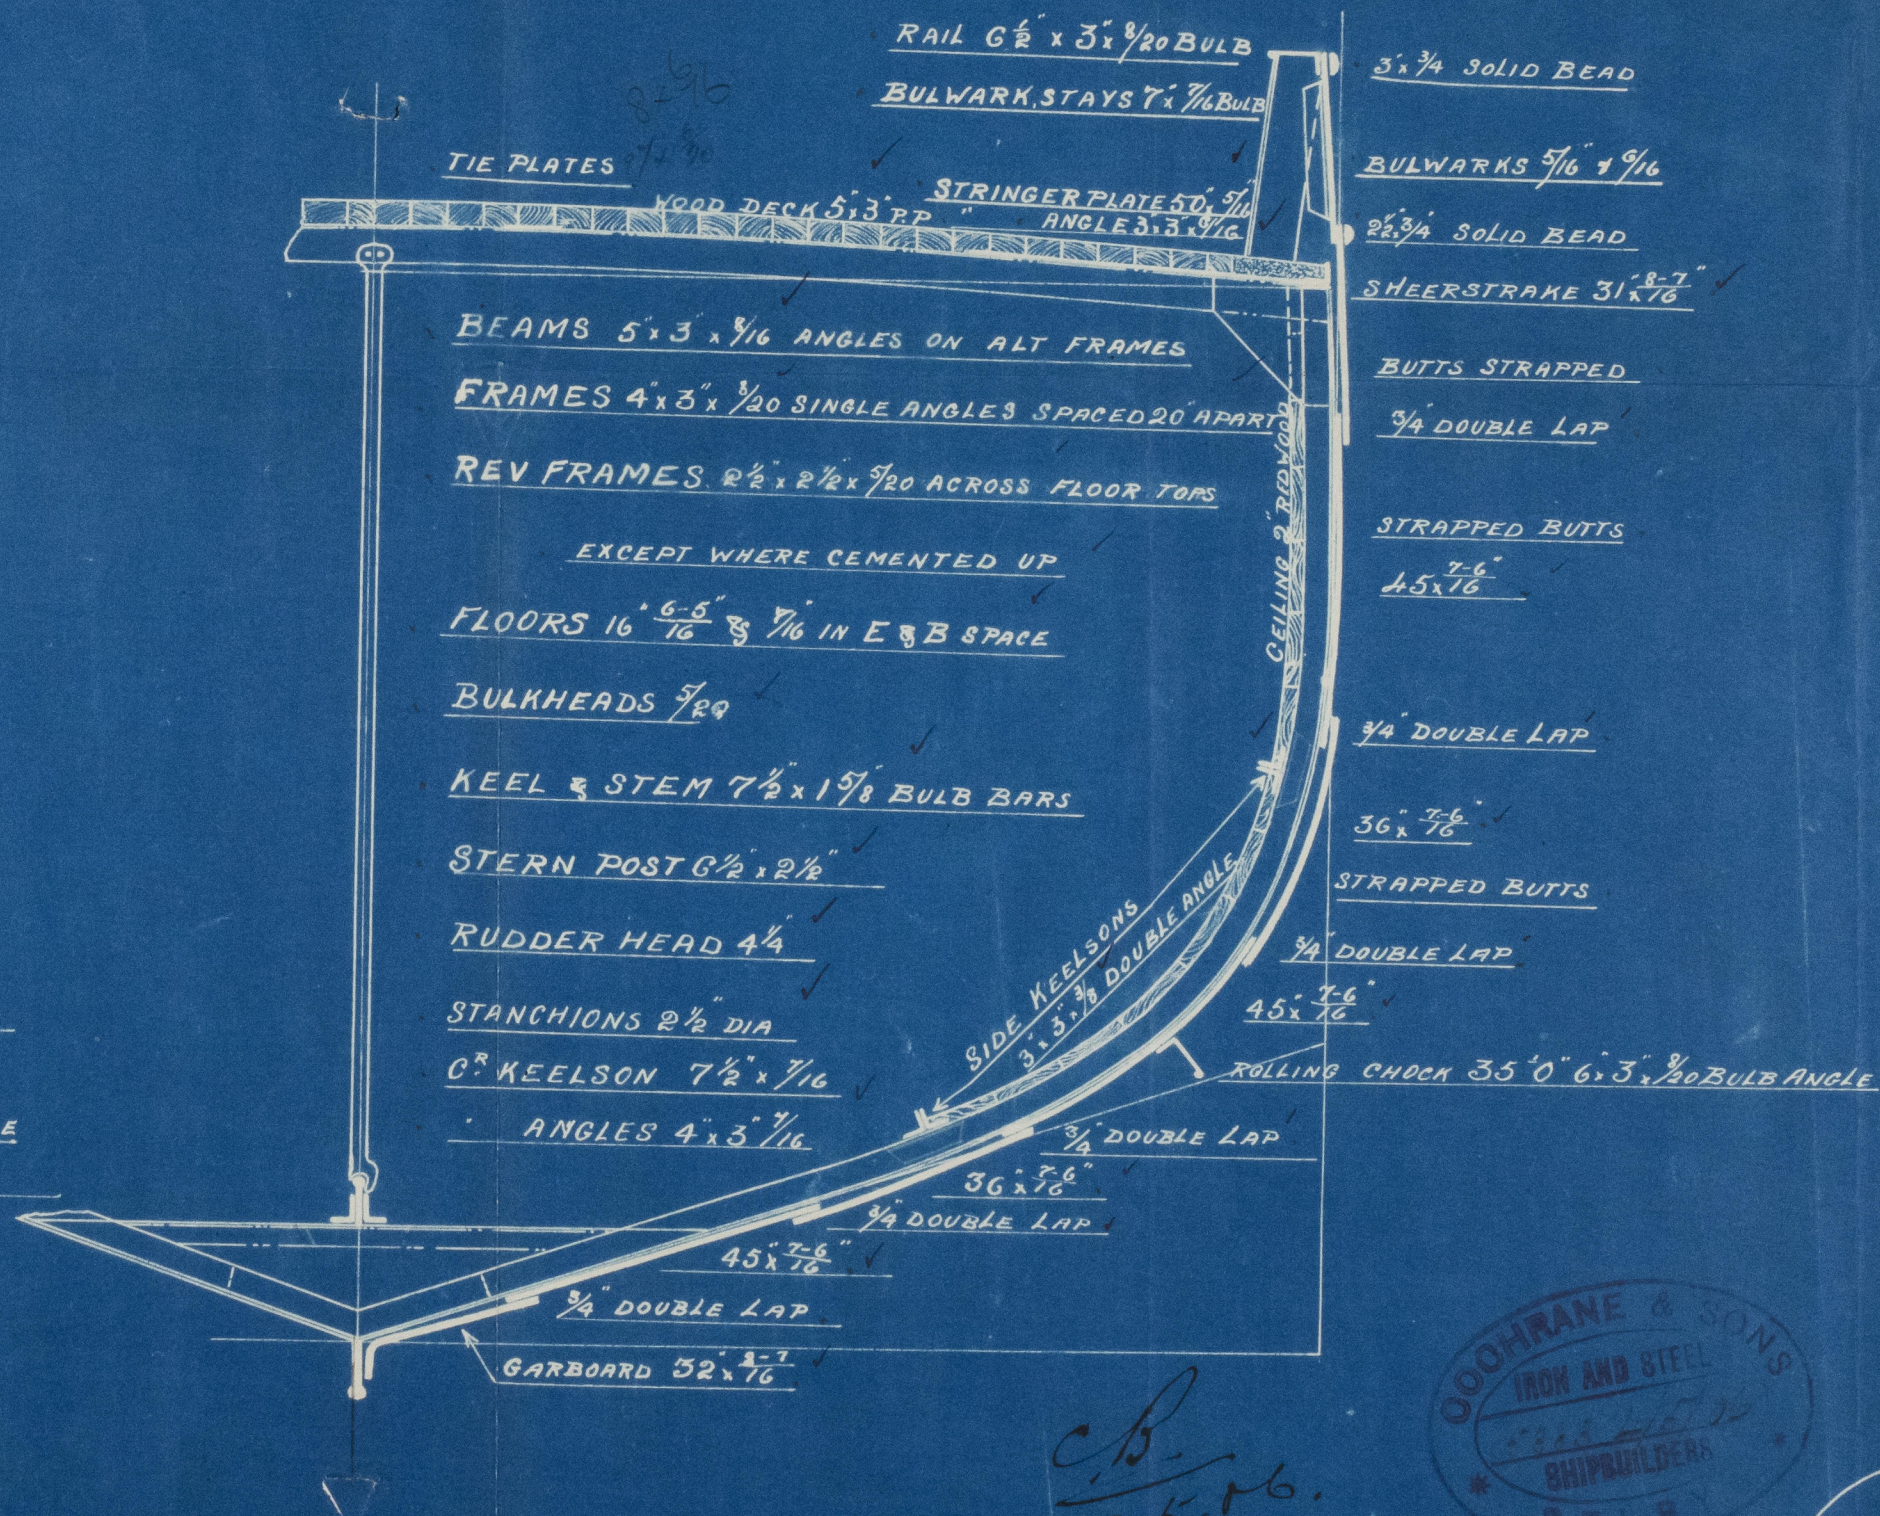

Cochrane & Sons
No. 344.

Midship Section.

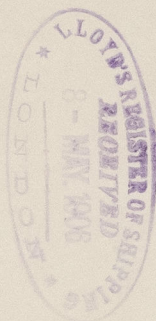

s/s "Ophir"
Hull Report No.



© 2021

Lloyd's Register
Foundation