

FREEBOARD PARTICULARS.
 LENGTH ----- 160.00
 BREADTH ----- 33.00
 DEPTH ----- 6.83.
 U. D. TONNAGE APPROX. 260 TONS.
 SHEER @ STEM ----- 3-6
 SHEER AT 1/8 FROM STEM ----- 1-11 1/4
 SHEER AT STERNPOST ----- 2-0
 SHEER AT 1/8 FROM STERNPOST ----- 1-1 1/4

30.5.10
 10.6.10
 14.6.10
 29.6.10
 11.7.10
 24.7.10
 4.8.10
 21.10.10
 8.12.10

EQUIPMENT.
 2 BOWER ANCHORS 10 1/2 CWTs STOCKLESS.
 1 STREAM ANCHOR 3 1/2 CWTs EX. STOCK.
 1 K. ANCHOR 1 1/2 CWTs EX. STOCK.
 135 FMS 1" STUD. CHAIN CABLE.
 60 FMS 2 3/4" STEEL WIRE (STREAM).
 75 FMS 2 1/2" STEEL WIRE (TOWLINE).
 90 FMS 2 1/4" STEEL WIRE (HAWSER).



SECTION THRO' TUNNEL


— N^o 461 —

— STEEL TWIN SCREW STEAMER —

— DIMENSIONS 160'-0" B.P. x 33'-0" MLD. x 7'-0" MLD. —

— TO CLASS A1 LLOYD'S —
 FOR RIVER SERVICE

— SCALE 1/2" —

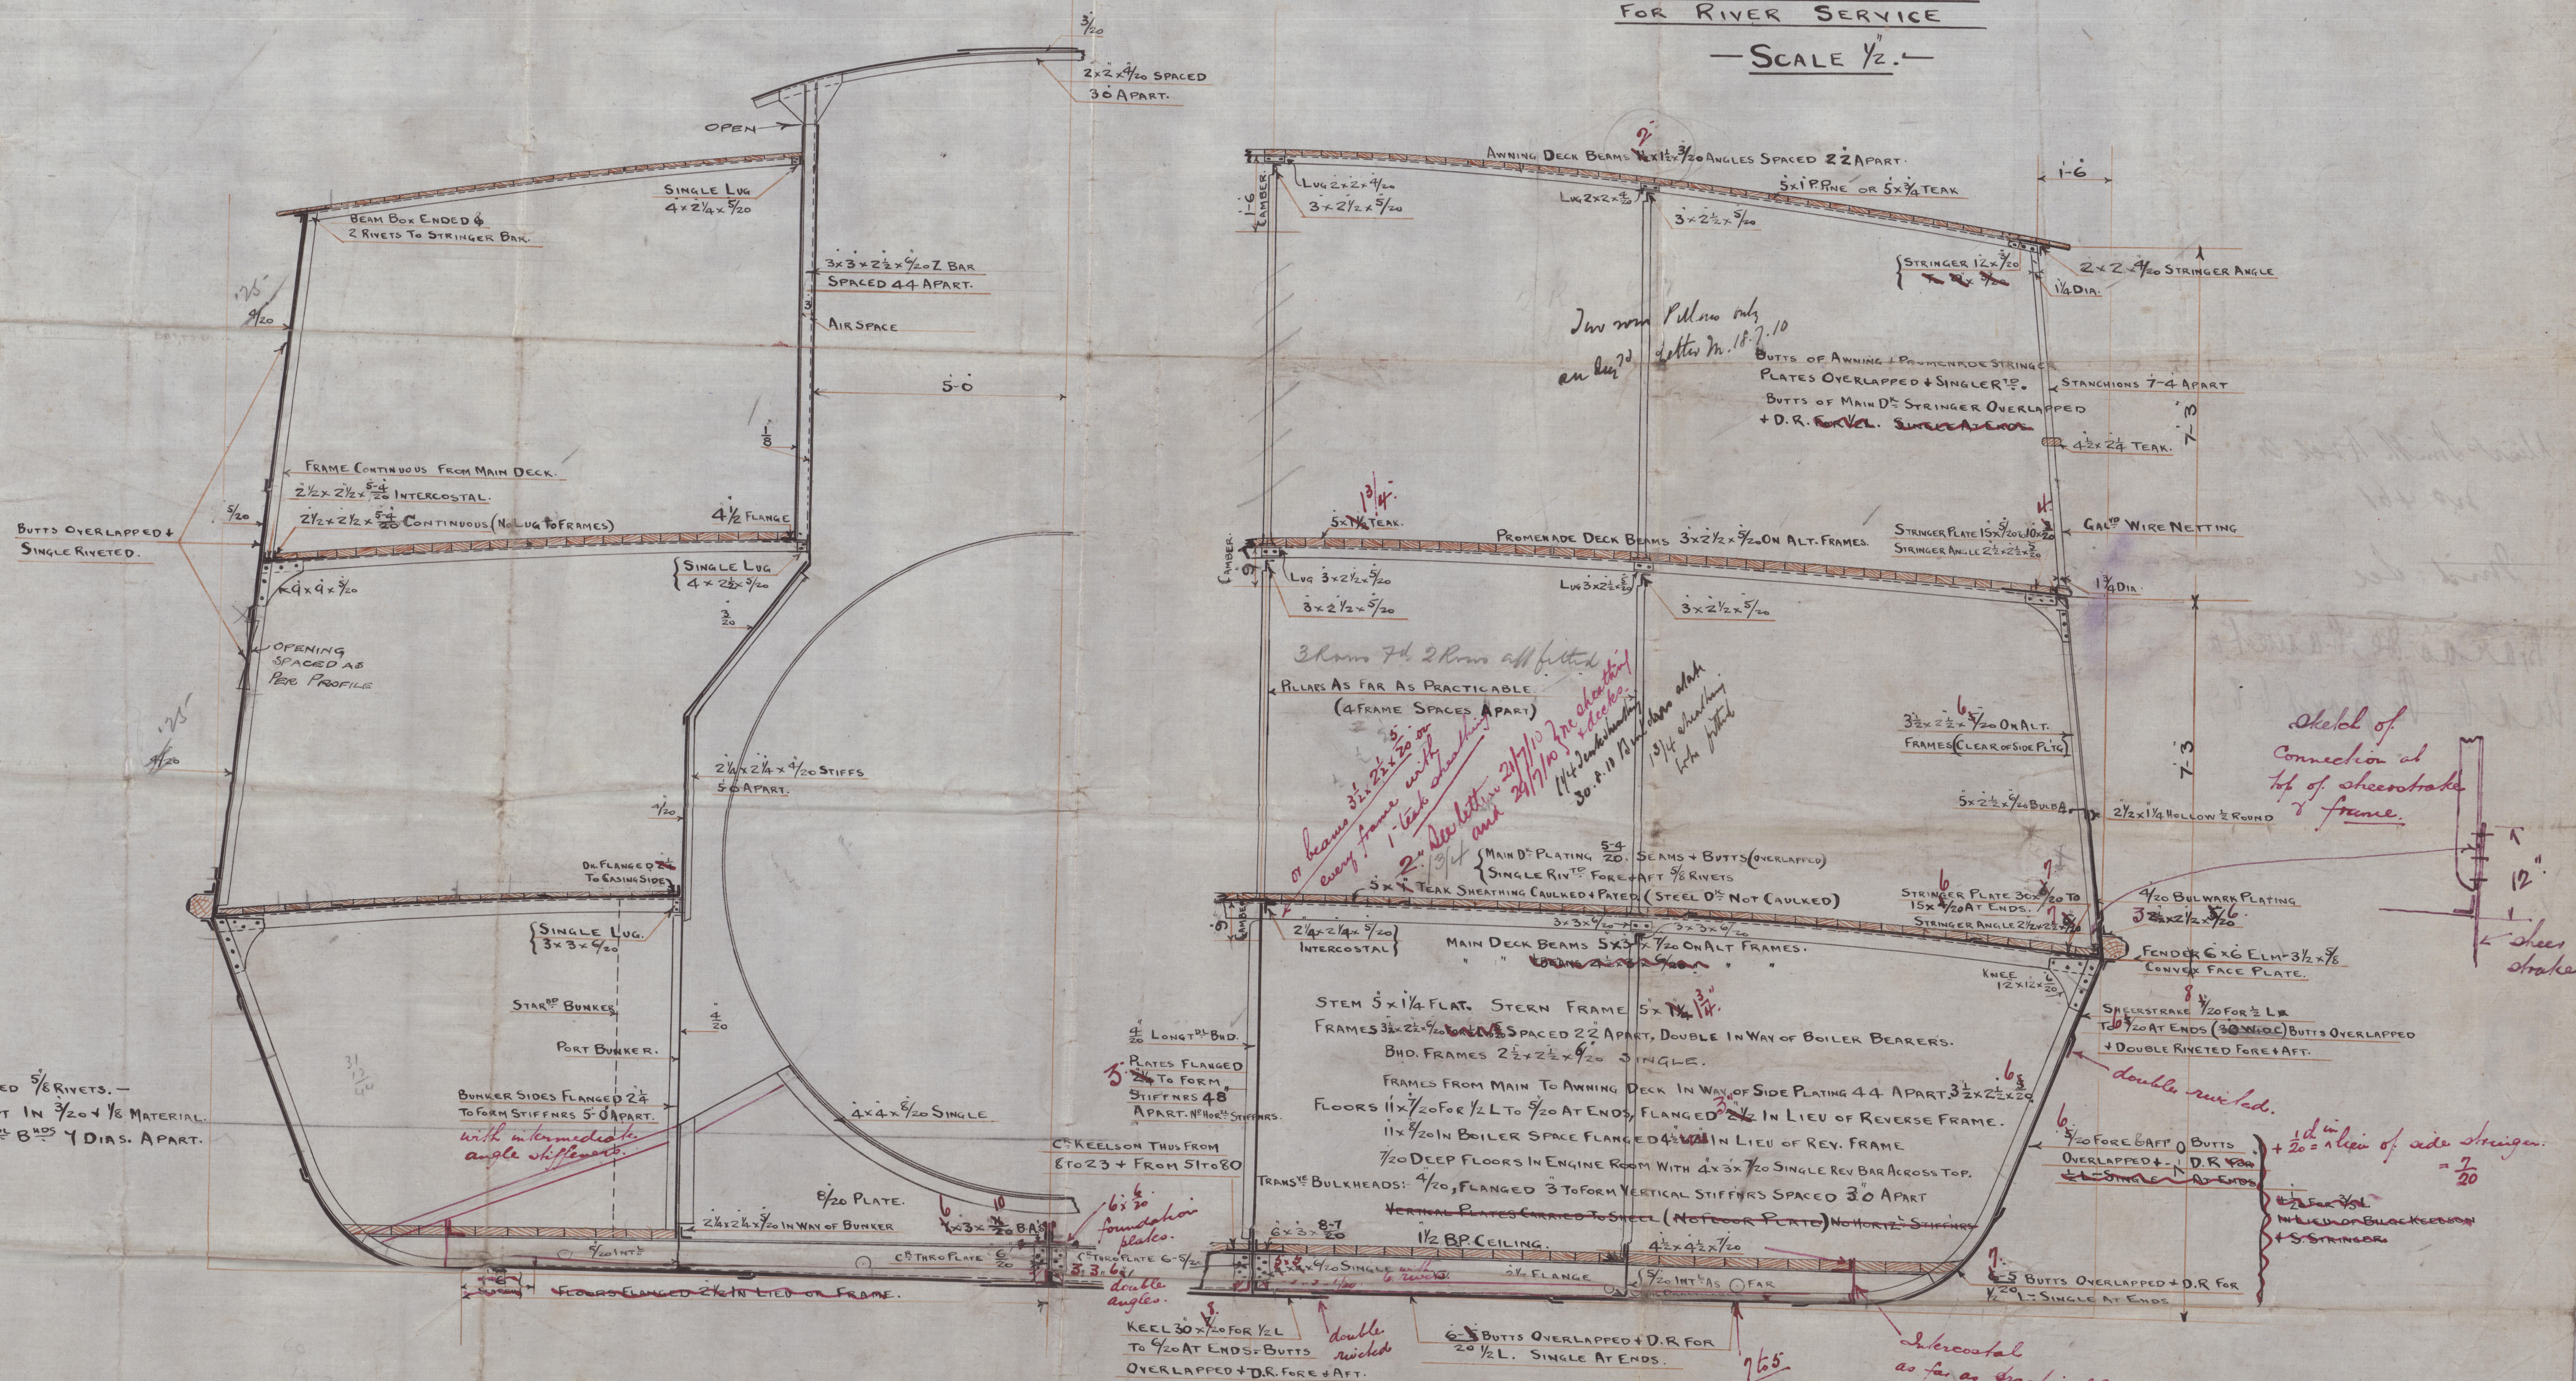

SECTION THRO' BOILER ROOM.

MIDSHIP SECTION.

RIVETING.
 SHELL SEAMS SINGLE RIVETED 5/8 RIVETS. —
 5/8 RIVETS THRO' OUT EXCEPT IN 3/20 1/2 MATERIAL.
 ALL RIVETING IN LONG T^h B^h 4 DIAS. APART.

Master Smith Book A
no 461

Mid: Lee

"Barão de Cameta"
Hist. Report 6691



© 2020

Lloyd's Register
Foundation

006723-006730-0219