
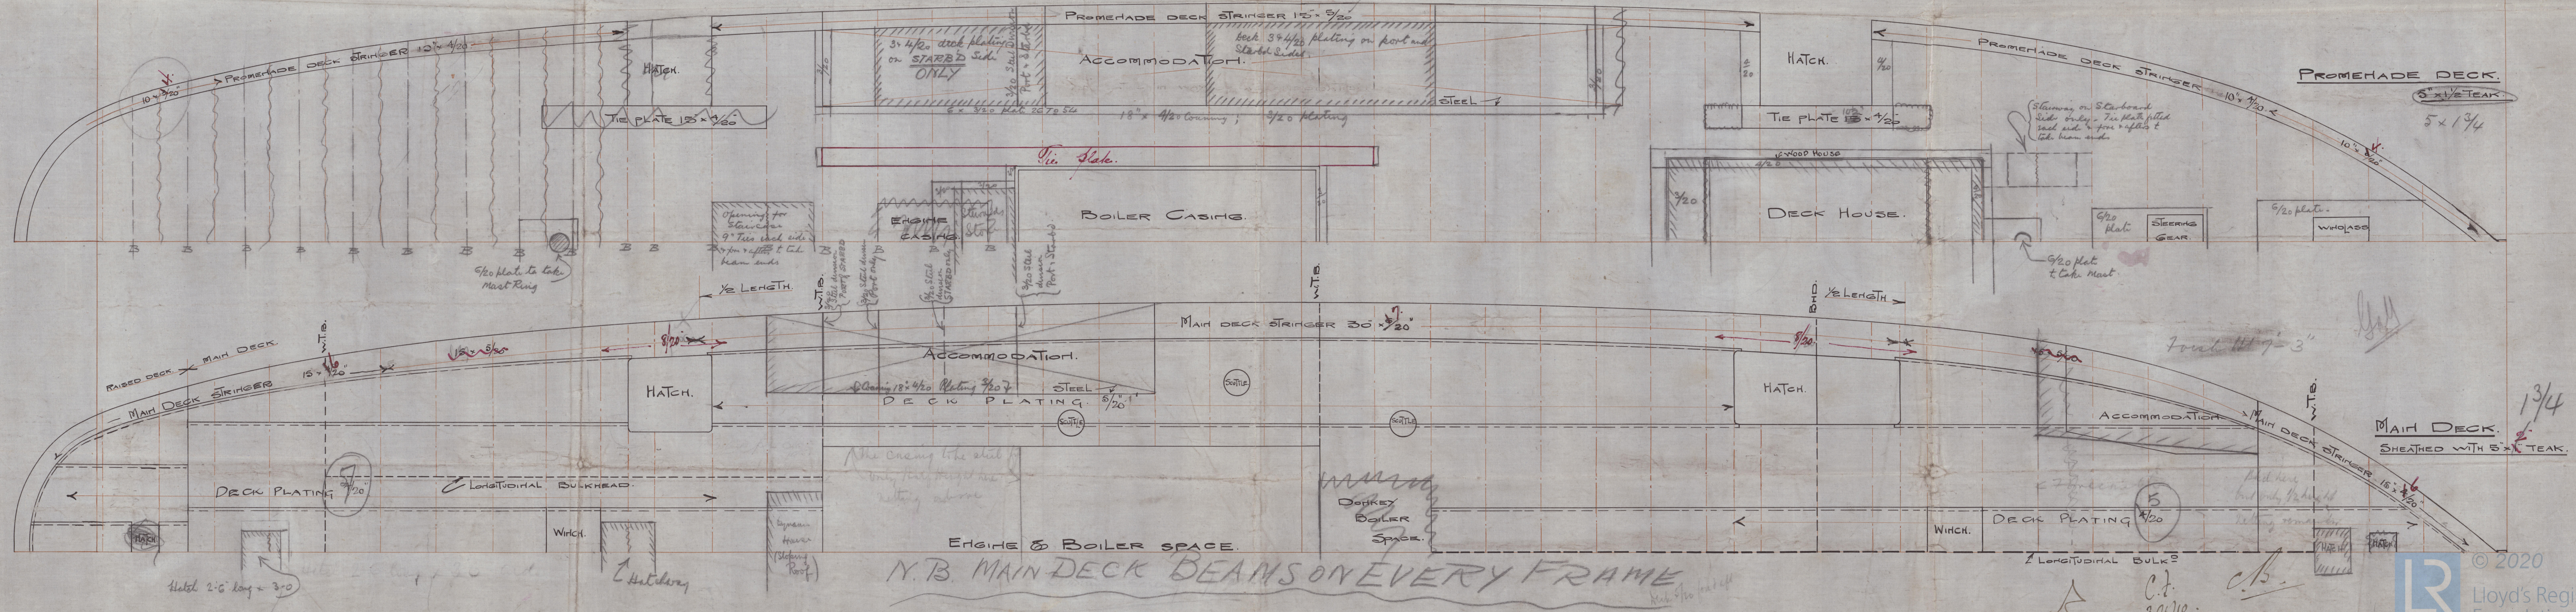


30.5.10
10.6.10
14.6.10
29.6.10
21.7.10
29.7.10
4.8.10
21.10.10
8.12.10

PROFILE & DECK PLANS.
No 461.
SCALE 1/4" = 1 FOOT.
DIMS:- 160'-0" x 33'-0" x 7'-0" MLD.

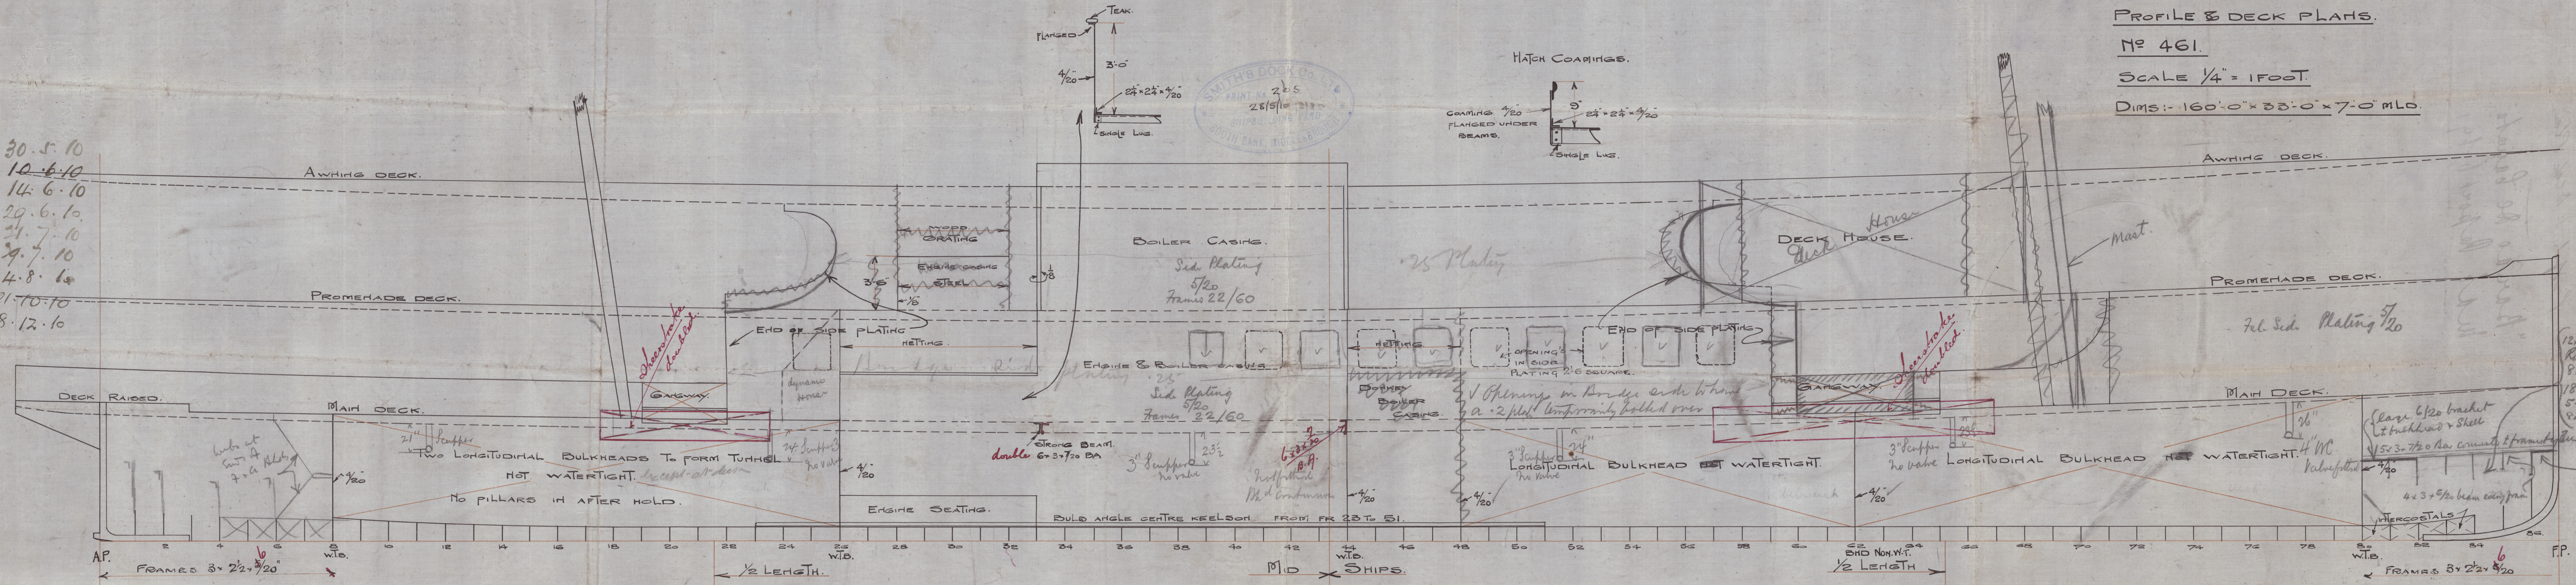

N.B. MAIN DECK BEAMS ON EVERY FRAME

Master Smith back to

No 461

Profile & Deck Plans

"Barão de Lavradio"
Ind. Report 6691

006723-006730-0280



© 2020

Lloyd's Register
Foundation