

SECTION THRO' TUNNEL.

— N^o 461 —

— STEEL TWIN SCREW STEAMER —

— DIMENSIONS 160' O.B.P. x 33' O MLD. x 7' O MLD. —


— TO CLASS A1 LLOYD'S —

FOR RIVER SERVICE.

— SCALE 1/2 —



SECTION THRO' BOILER ROOM.

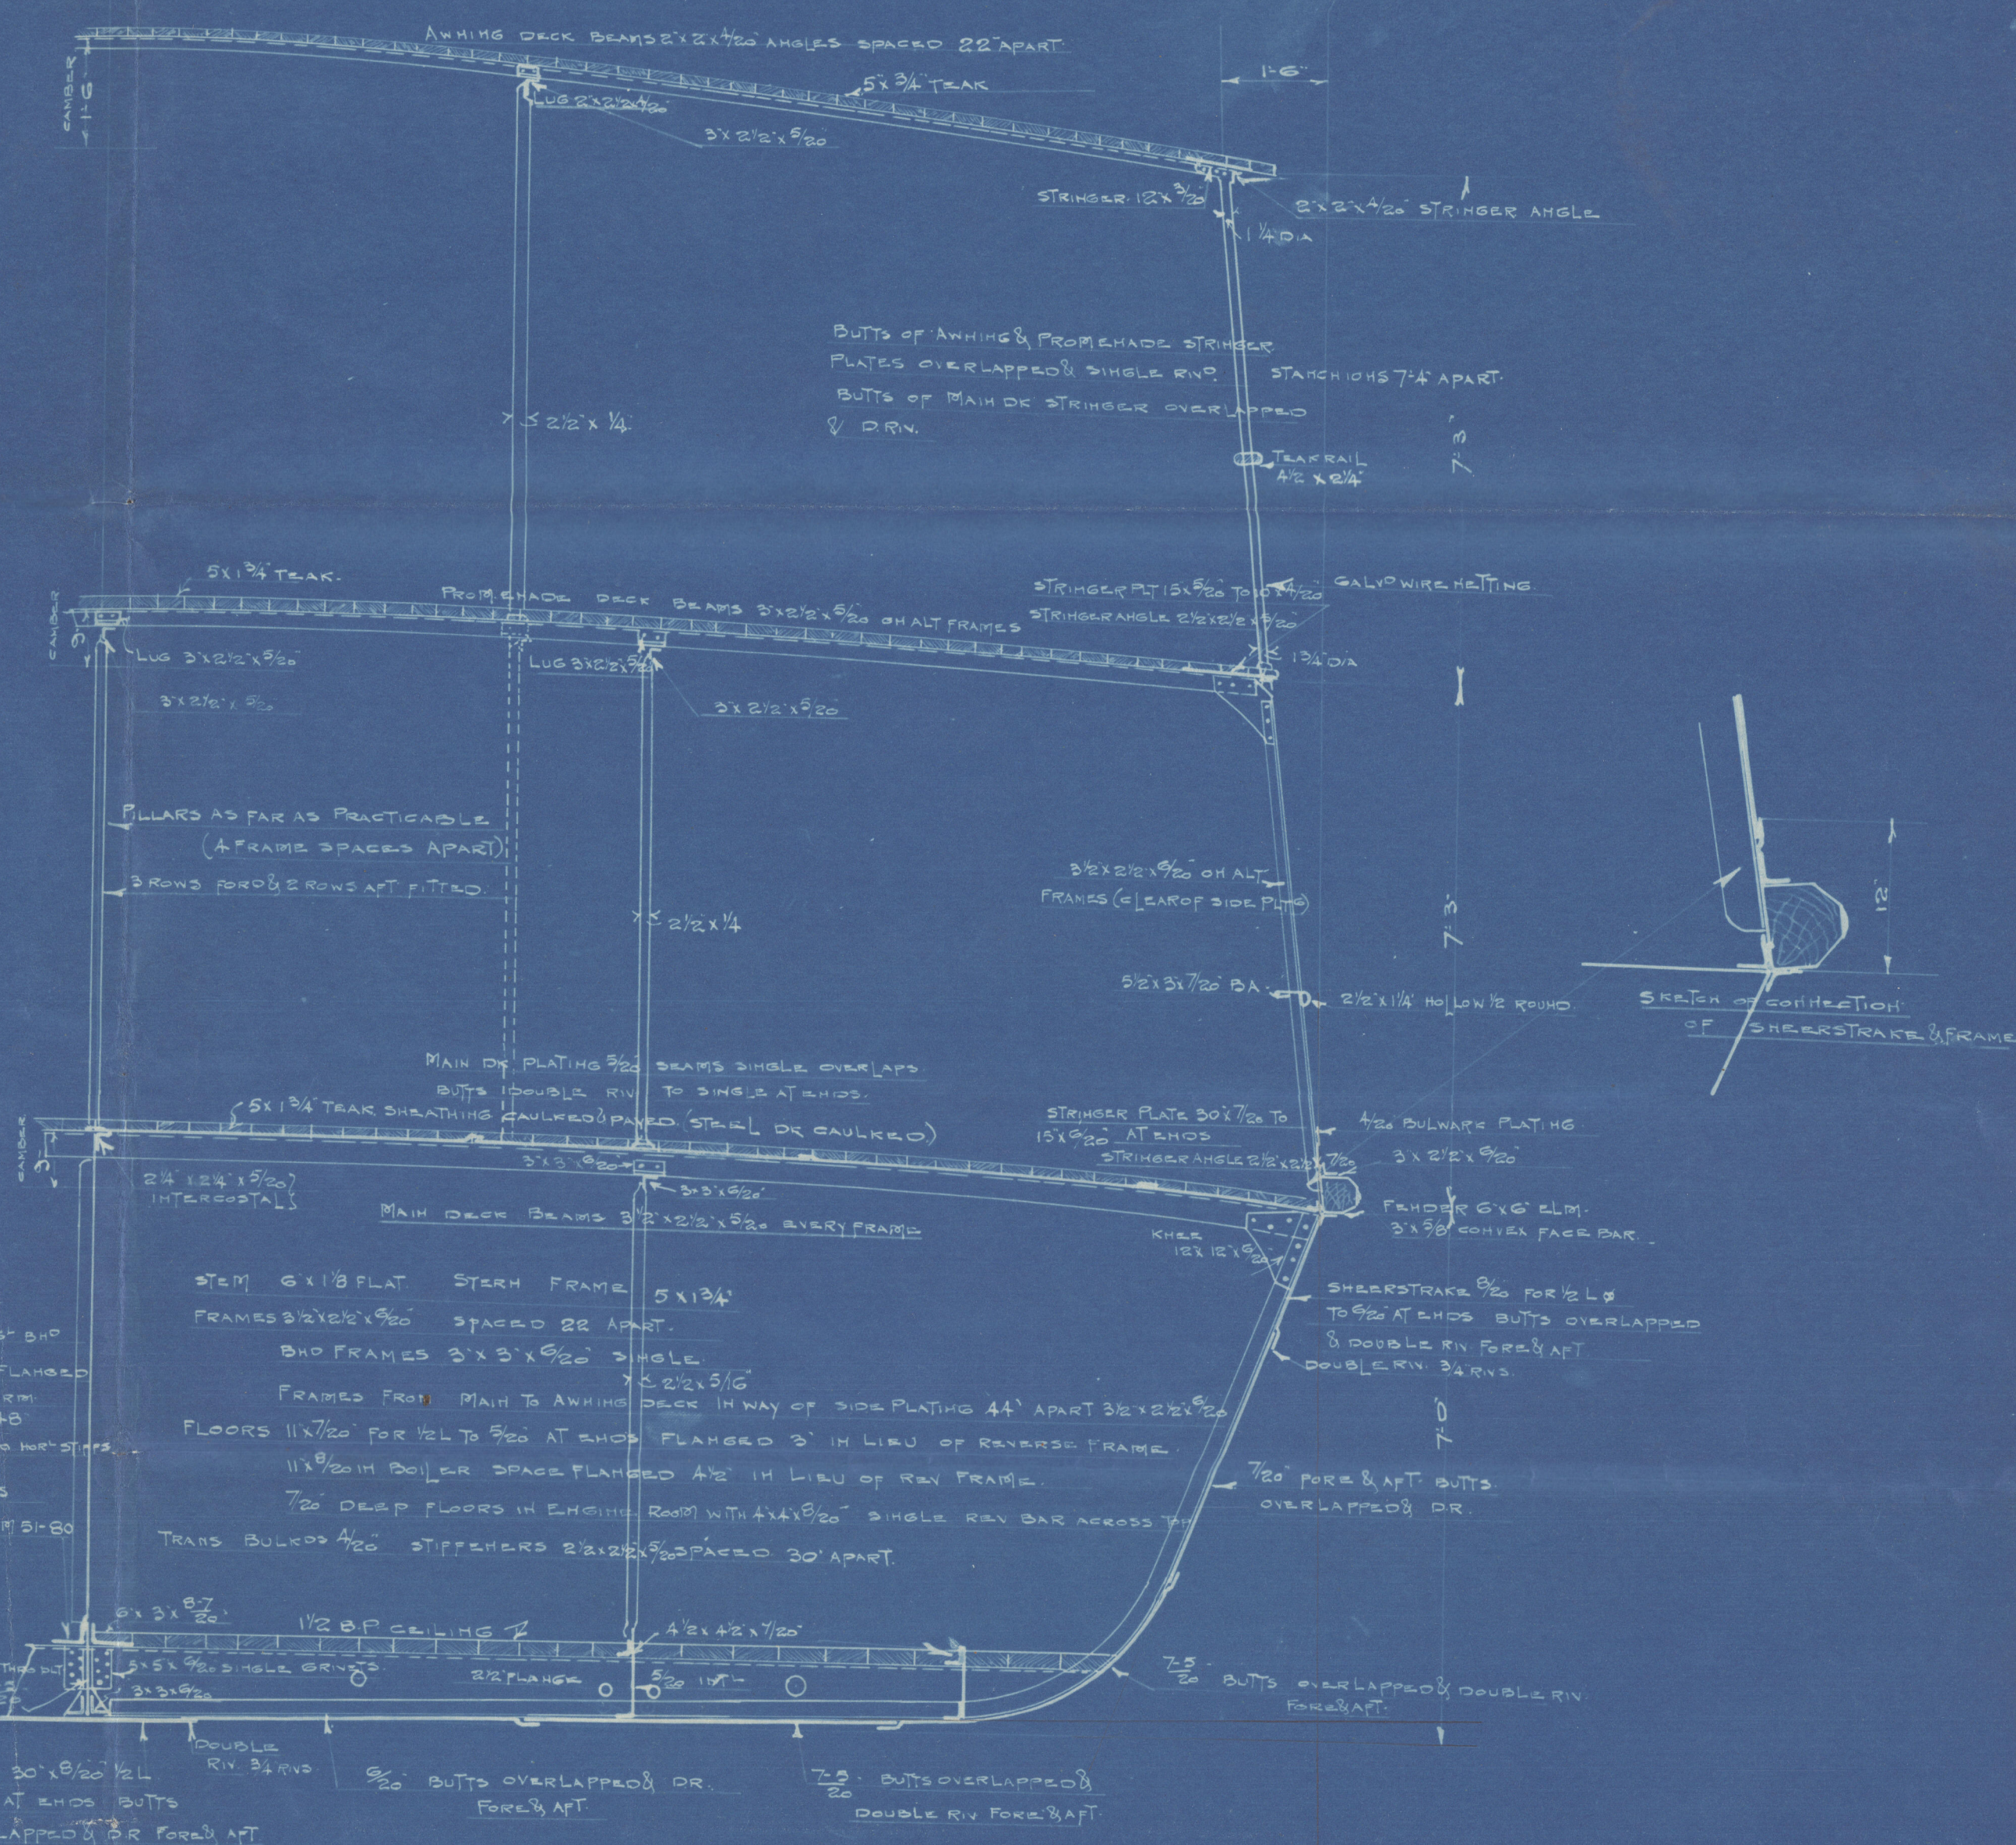

MIDSHIP SECTION.

243



© 2020
Lloyd's Register
Foundation

Must. Smiths Dock Wkd

Ev 461

Mid: See: as Bull.

2nd of Boão de Cancha

Uab. Report 6691



© 2020

Lloyd's Register
Foundation

006723-006730-0283