







Section

S. S. Arabia Maru

N<sup>o</sup> 271

Nagasaki Dept 1180

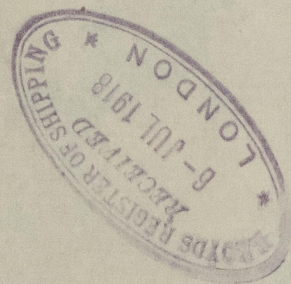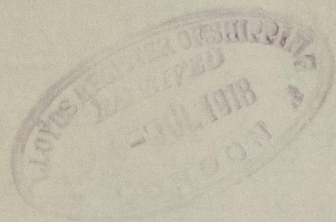

N<sup>o</sup> 271 (SS. ARABIA MARU).

MIDSHIP SECTION.  
(FINISHED PLAN).

006749-006759-0030



Lloyd's Register  
Foundation