



16.5.04

— PROFILE & DECK PLAN OF SCREW TUG N° 180 —
— SCALE 1/4" = ONE FOOT —

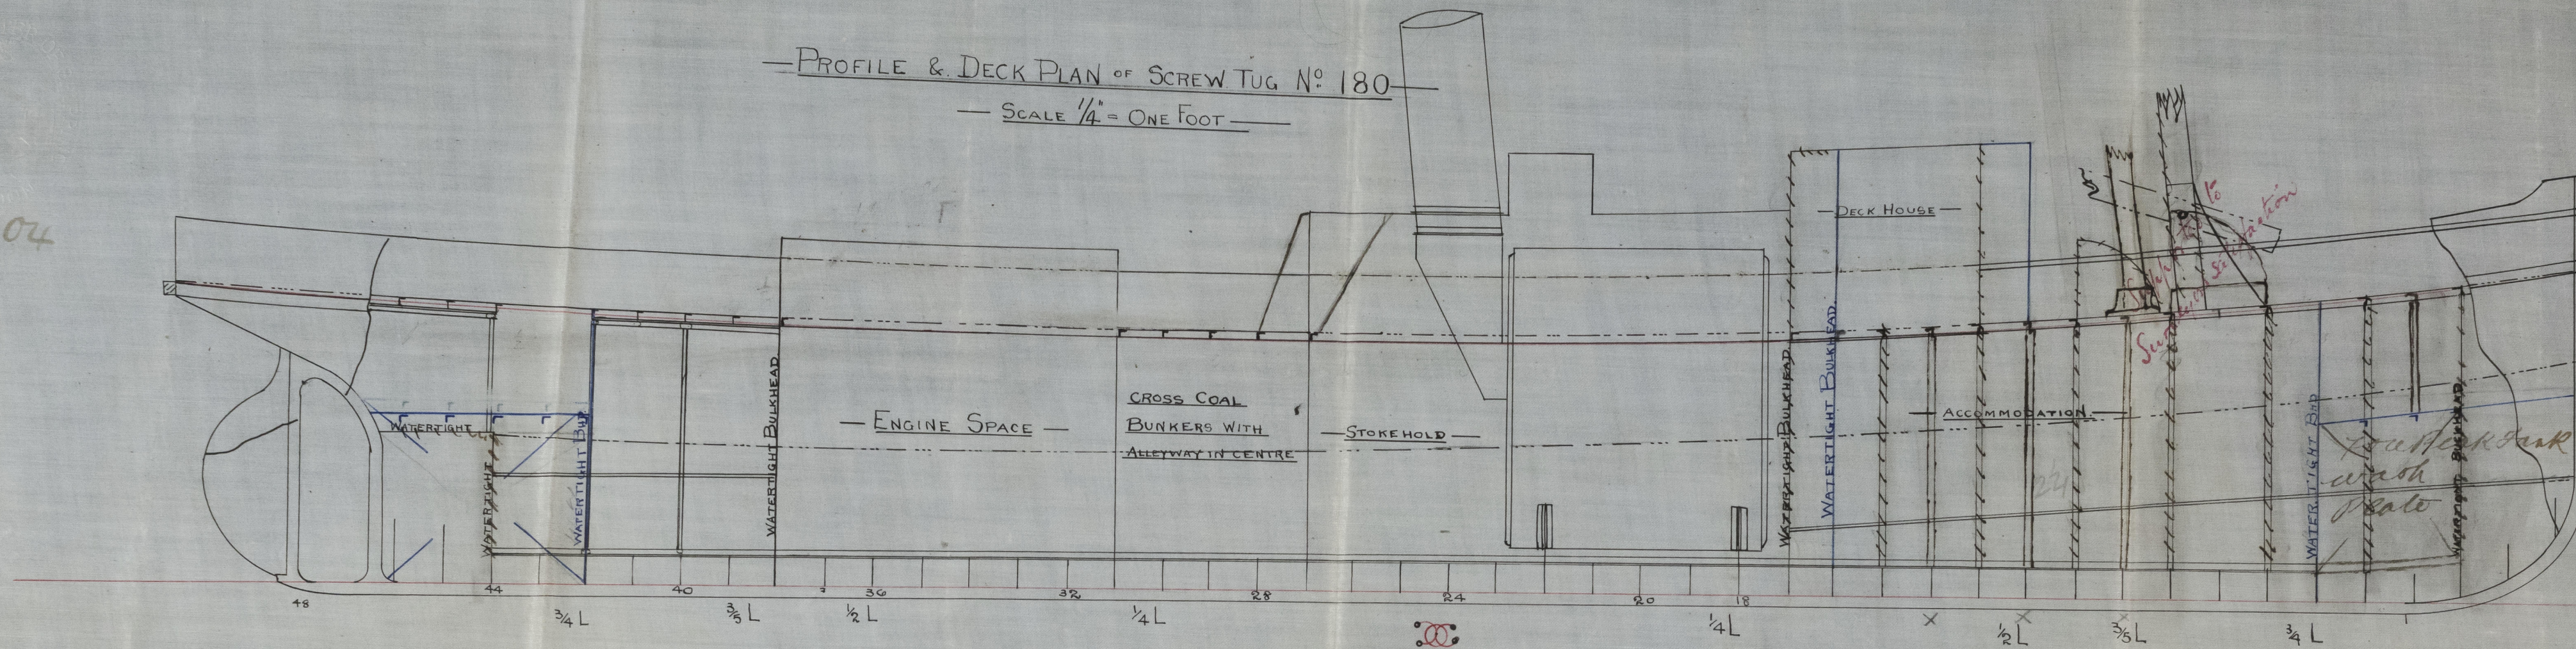

not intended
to be
used as a
reference

19.5.04

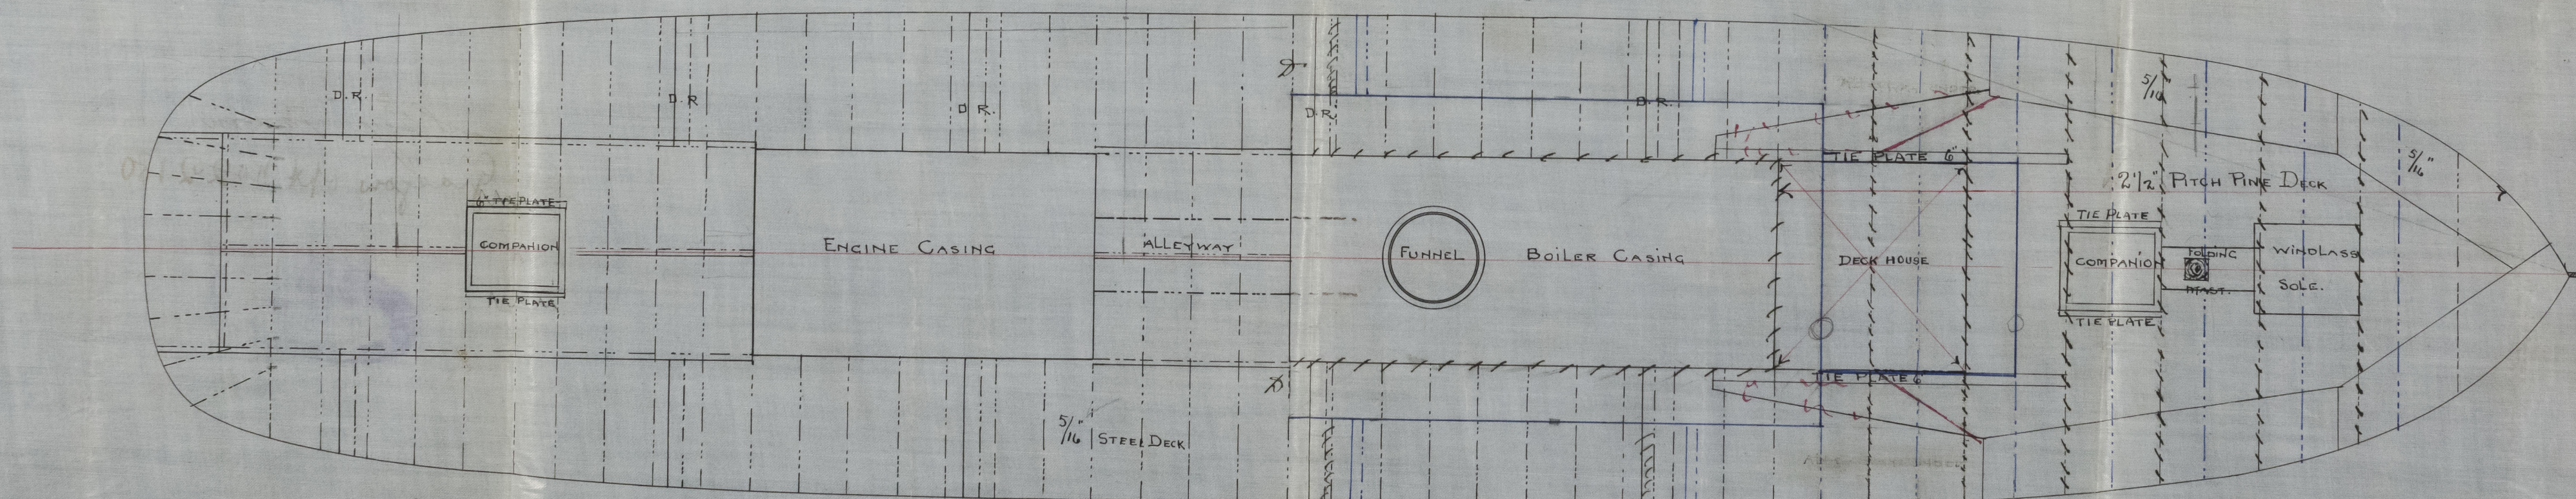

C.B.
26.5.04.

J. Fullerton & Co
No 180
Profile & Beck Plan

St. Leger "Foam"
Glasgow rpt No 22180