


S.S. ADIGE

 

2 1/2" x 4 1/2" Angle Frames  
32.3 1/2" x 34 Rev Bars  
Nos 1 & 2 For 4 1/2" x 50  
Reverse Bar to B Deck

2 1/2" x 4 1/2" Reverse 4 1/2" x 50 Rev  
Bar to B Deck Bars to C Deck  
Forming 14 1/2" Girders

BULKHEADS  
BULKHEAD FRAMES Y.Y. 50  
STIFFS 15 x 4 1/2" CHANNELS  
10 x 3 1/2" x 50 Bulk Angle  
9 x 3 1/2" x 44 " "

" PLATING 3/4" - 30  
BRACKETS 50 x 44

"N" TYPE  
DIMENSIONS 41' 6" B.P. x 55' 5 1/2" MLD x 38' 0 1/2" MLD  
PROFILE  
SCALE 1" = 1 FOOT

To class at Lloyds 100A1 SHUTTER DECK

HATCHWAYS  
HATCH SIDE COAMINGS 1/4  
END 1/4  
DECK ANGLE Y.Y. 60  
WEBS 36 ANGS 3 1/2" x 44  
18 x Y.Y. 45 Lvs I Bars

ADDITIONAL REV FRAME ON EVEN NOS 32 & 34 - 56  
Angles to B Deck

2 1/2" x 4 1/2" Angle Frames  
with 32.3 1/2" x 34 Rev Bars

FRAMES TO SHELL IN TANK Y.Y. 50 SINGLE ANGLES FROM FRAME 118 TO 142  
No Give



DRAWING NO 812  
DRAWN BY J.W.B.  
CHECKED BY G.A.W.  
DATE 13th OCT 1920  
LLOYD'S REGISTER OF SHIPPING  
006749-006759-0148




"S.S. ADIGE". -

Monmouth S.B. Co's No. 3738 Ship.

Net. 20056.

Profile Plan. Now.

MONSUN

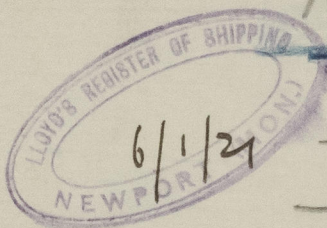

D. 64-B.



© 2021

Lloyd's Register  
Foundation