



Upper Deck.

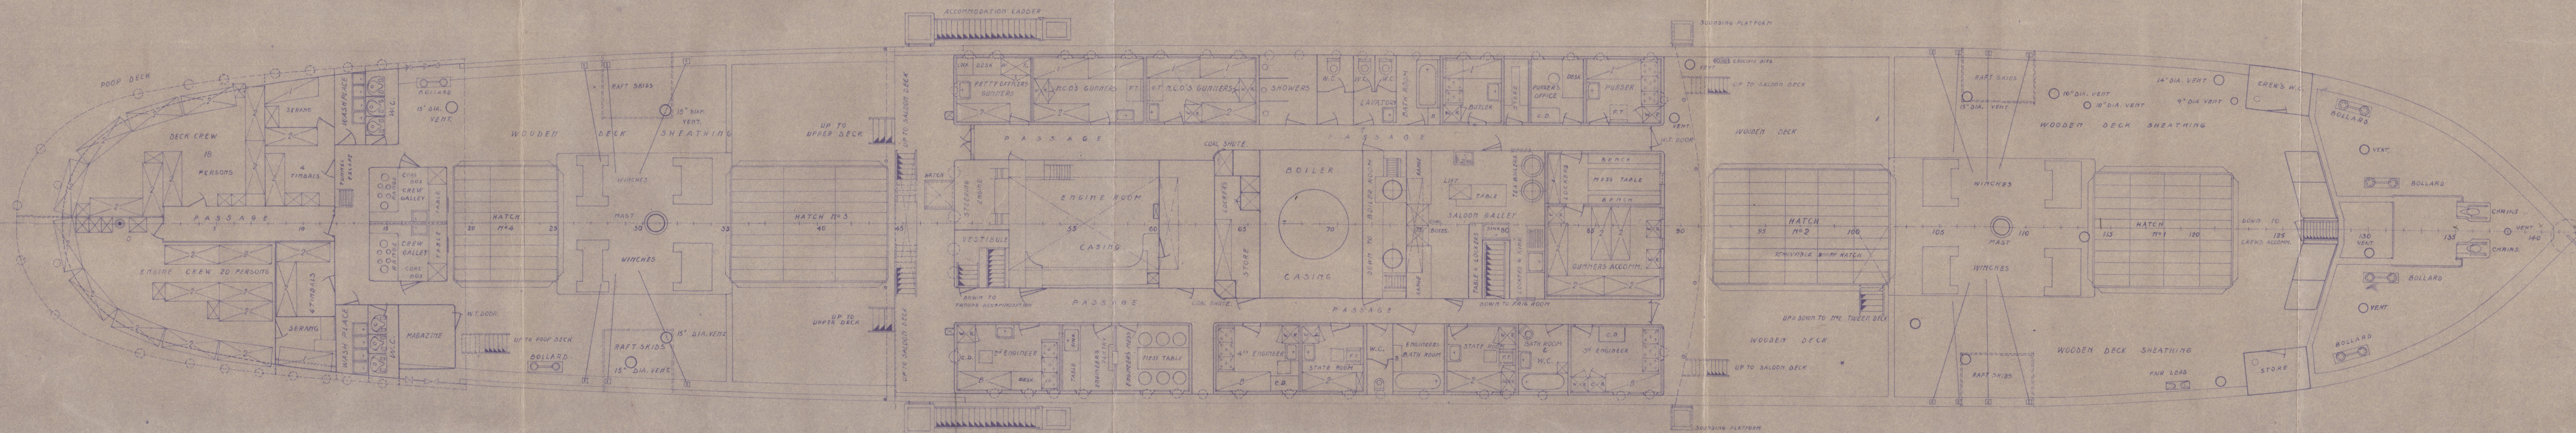

Raised Quarter Deck.


ex. Bridge Deck.

Shelter Deck.

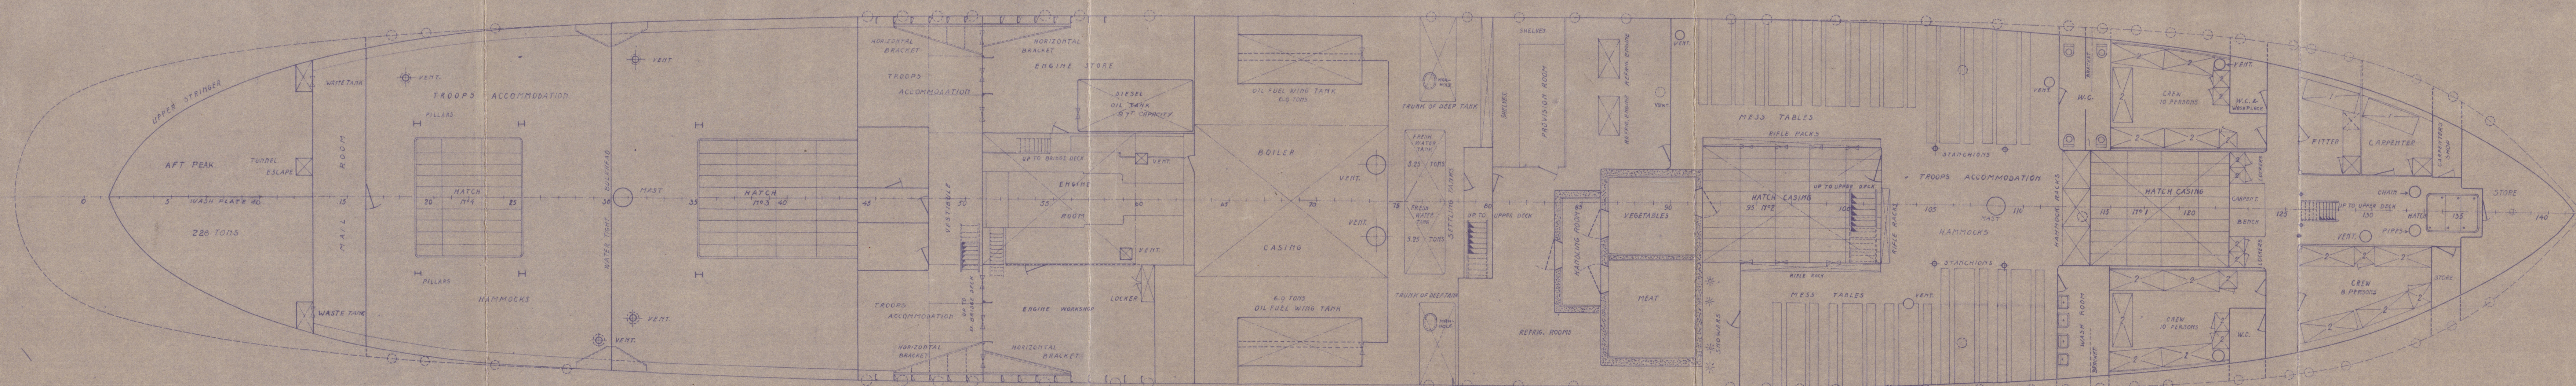

Tween Decks.

DIMENSIONS & CAPACITIES
APPROX. ONLY.

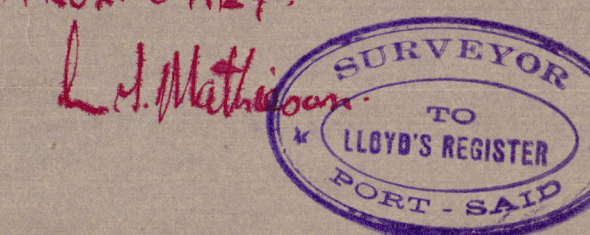

SHIPWRIGHTS & ENGINEERS
Job N°23: ss. TRIPOLITANIA
Upper & Tween Decks.
Date: 8-8-44 Scale: $\frac{1}{8}$ " = 1'-0"
Surveyed, Drawn & Traced by: **A-27**

" Tripolitania. "

upper & tween decks.

Pod rept No. 3156



© 2021

Lloyd's Register
Foundation

006749 006750 0212

"Tripolitania"



© 2021

Lloyd's Register
Foundation