

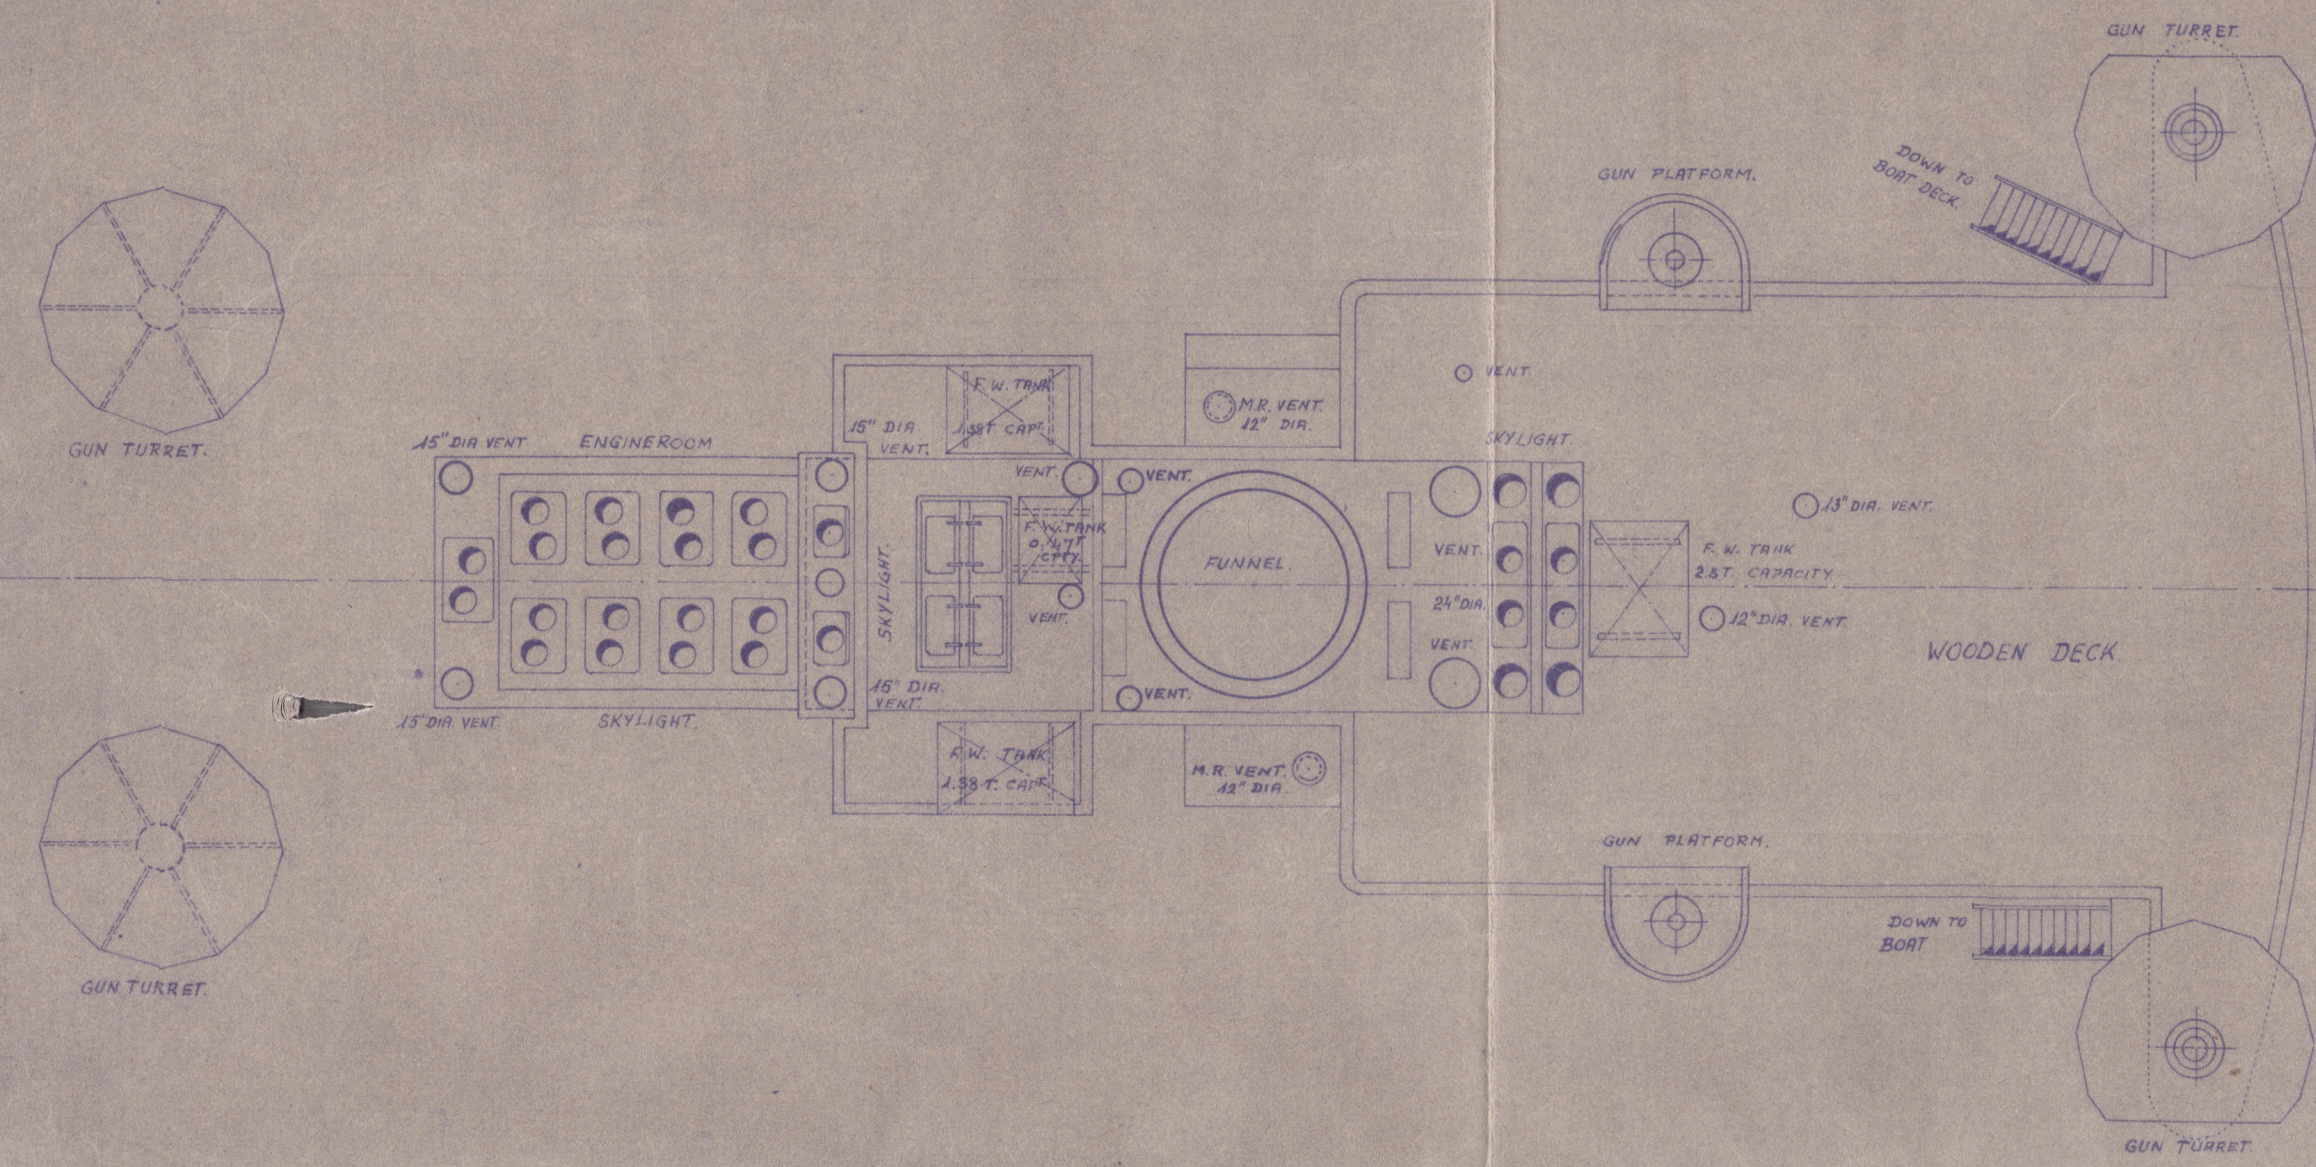


Flying Bridge.

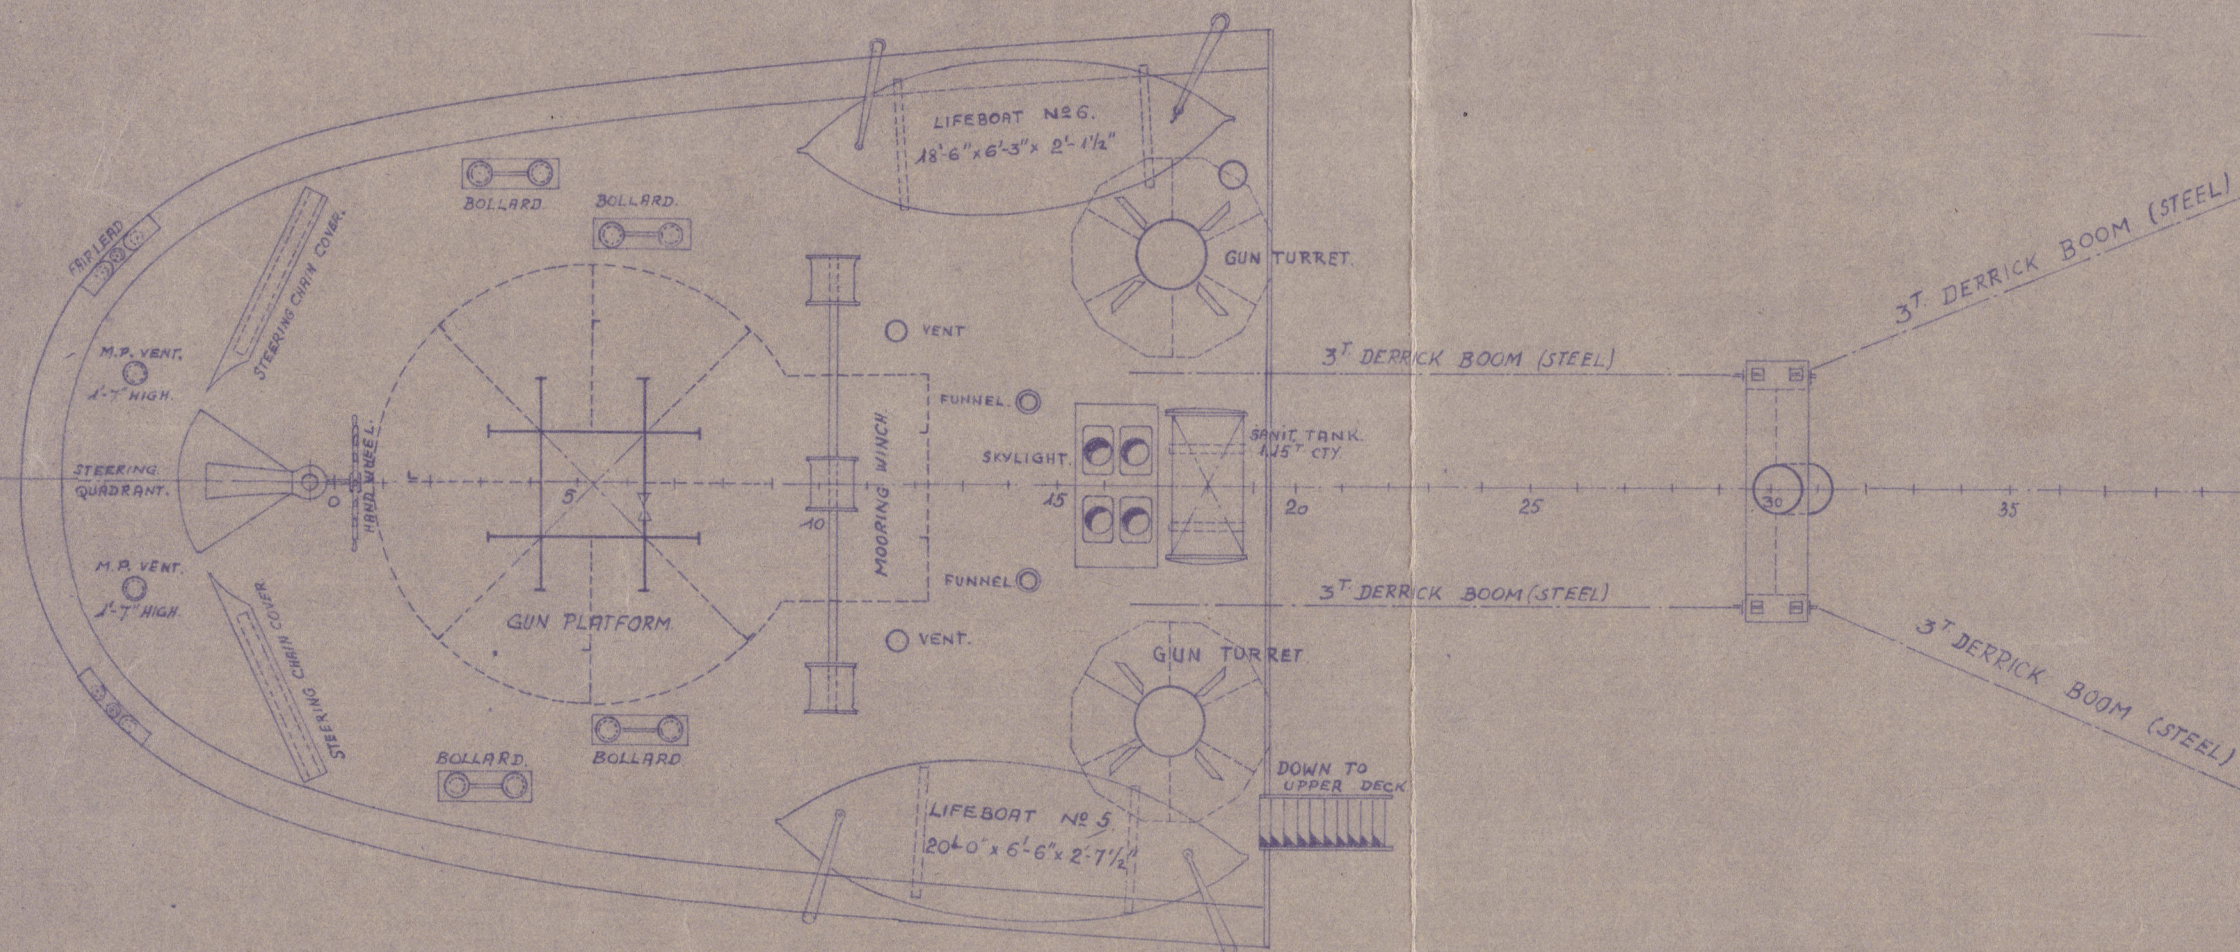


Boat Deck.

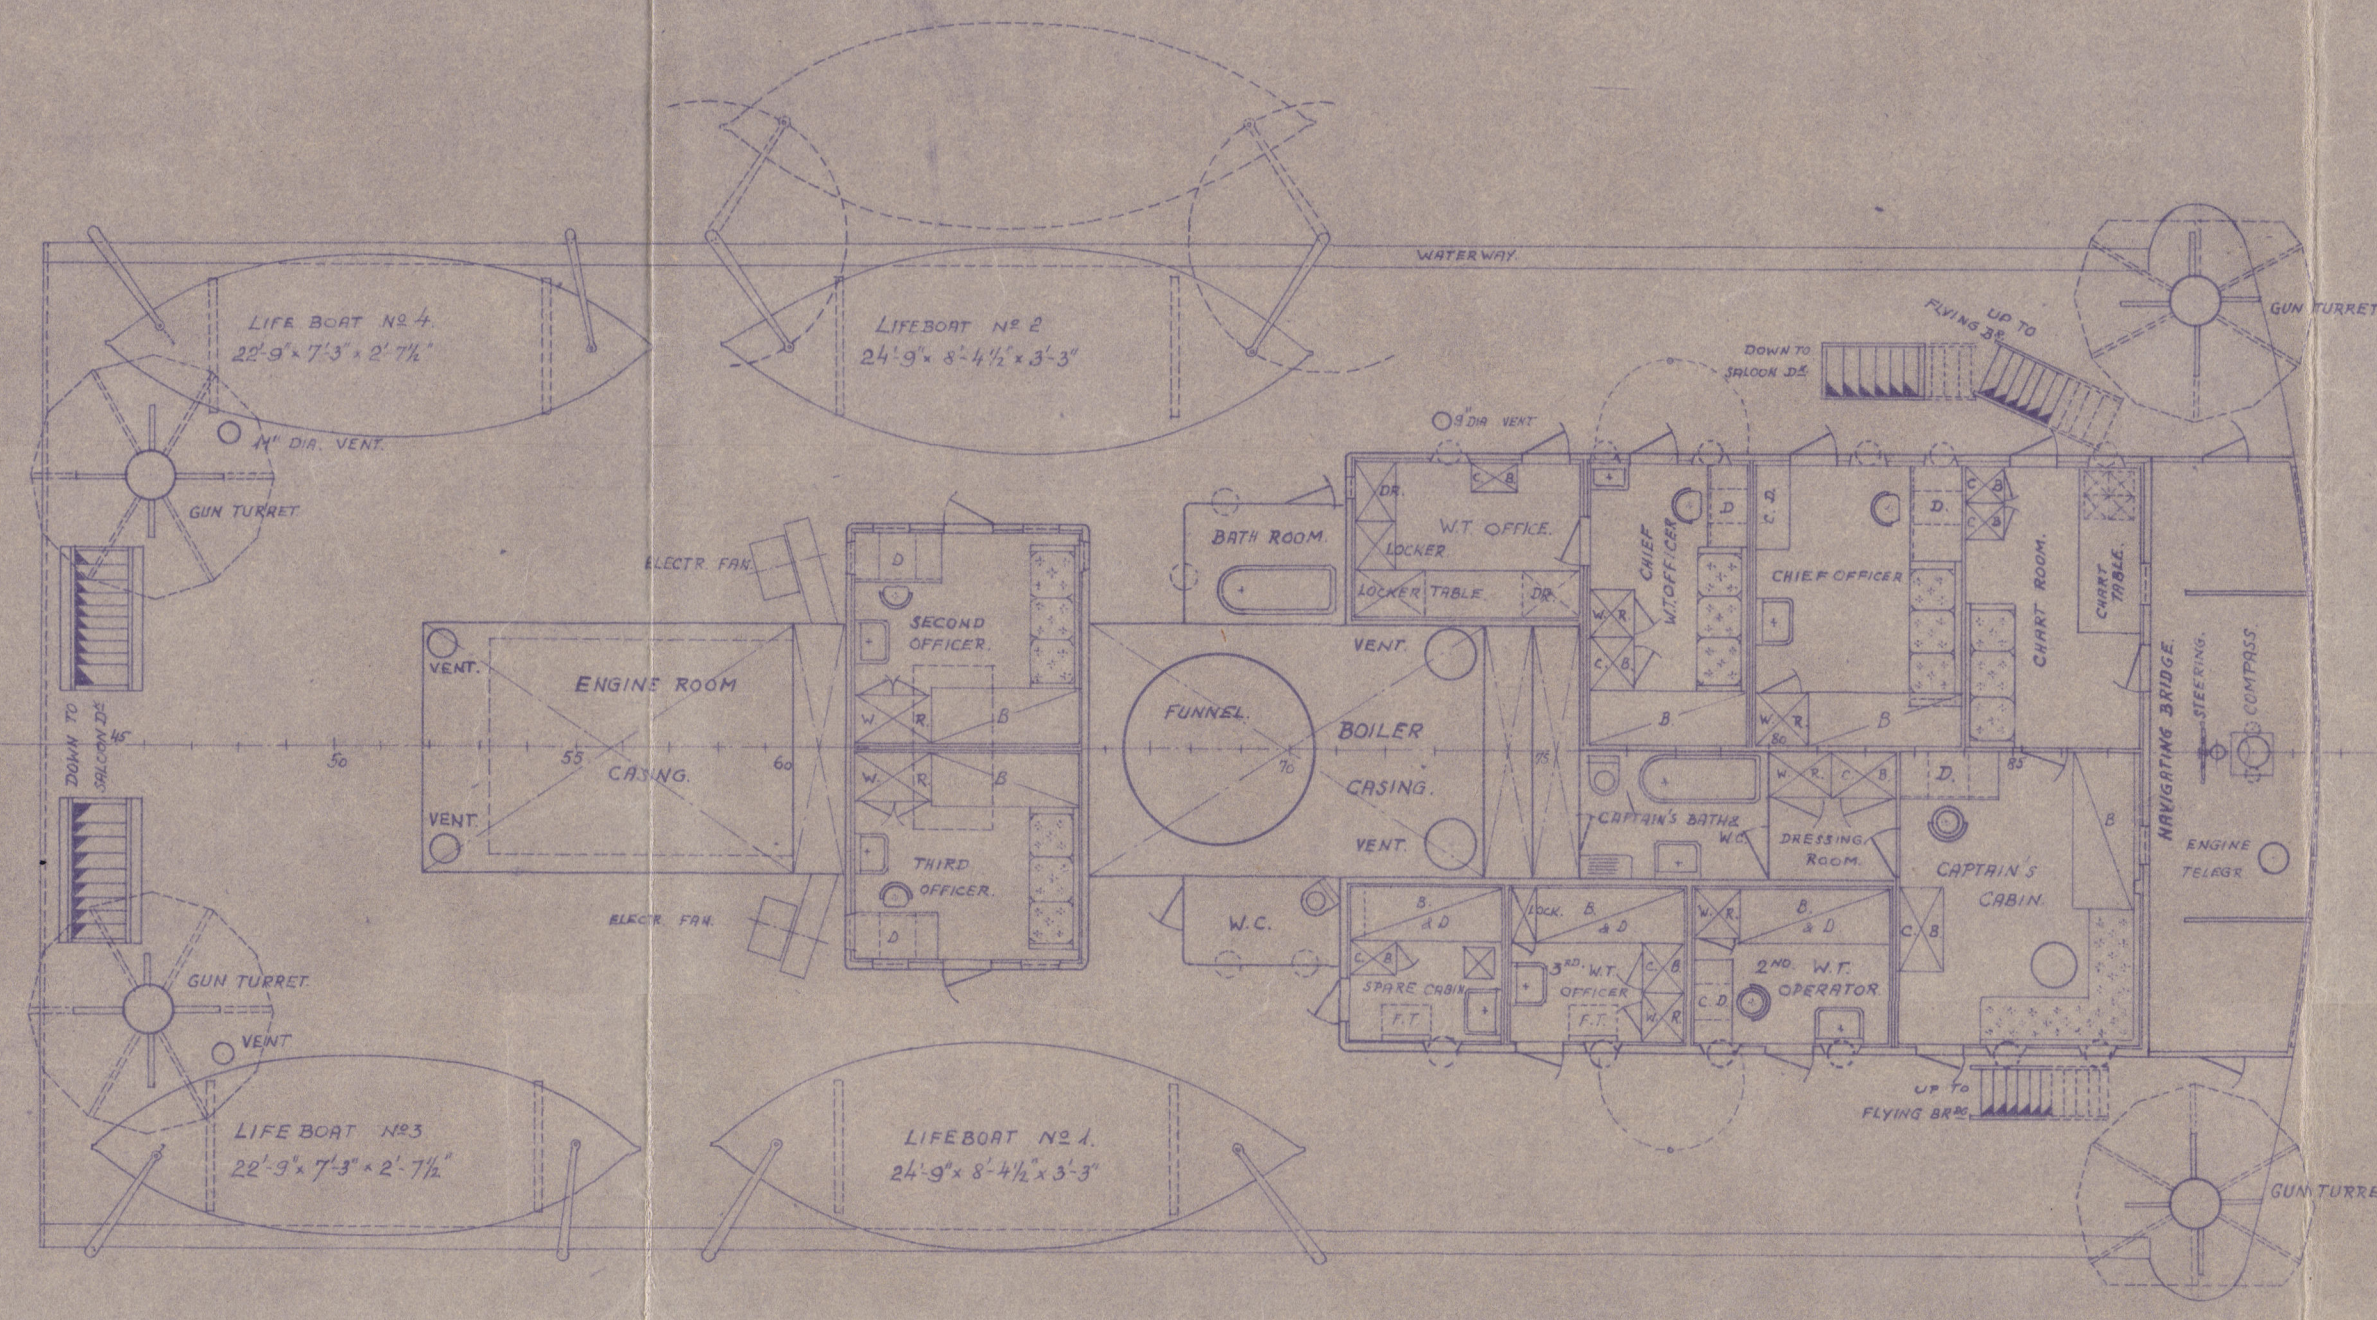


Poop Deck.

Saloon Deck.

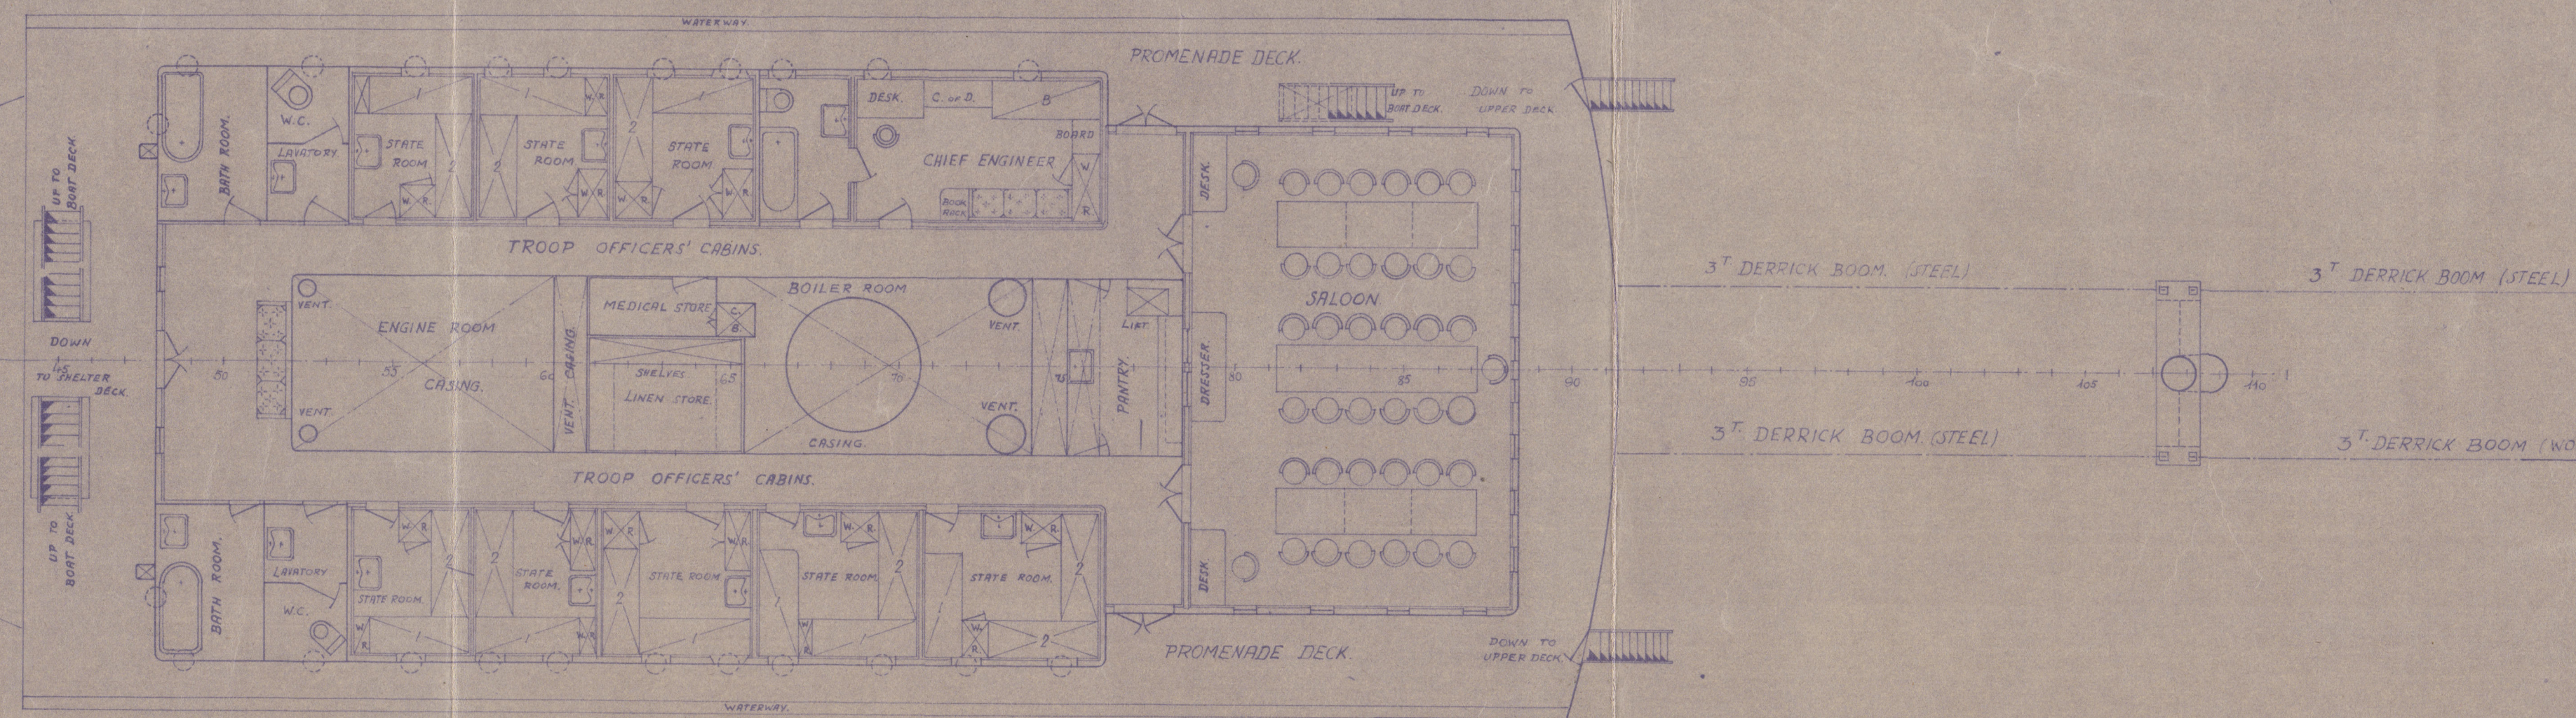

DIMENSIONS APPROX. ONLY
L. P. Mather

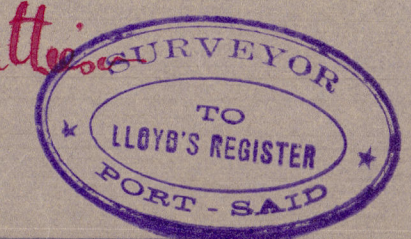

SHIPWRIGHTS & ENGINEERS
Job No 23: ss. TRIPOLITANIA
Superstructures.
Date: 11-11-44 Scale: 1/8" = 1'-0"
Surveyed, Drawn, & Traced by: A.28

"Tripolitania"

Superstructures

Prod rept No. 3156.



© 2021

Lloyd's Register
Foundation

006749-006759-0213

Tripolitania

006749-006759-0213



© 2021
Lloyd's Register
Foundation