


S.S. "ATLAS MARU."

RUDDER & STERN FRAME.

SCALE $\frac{1}{2}$ TO ONE FOOT.

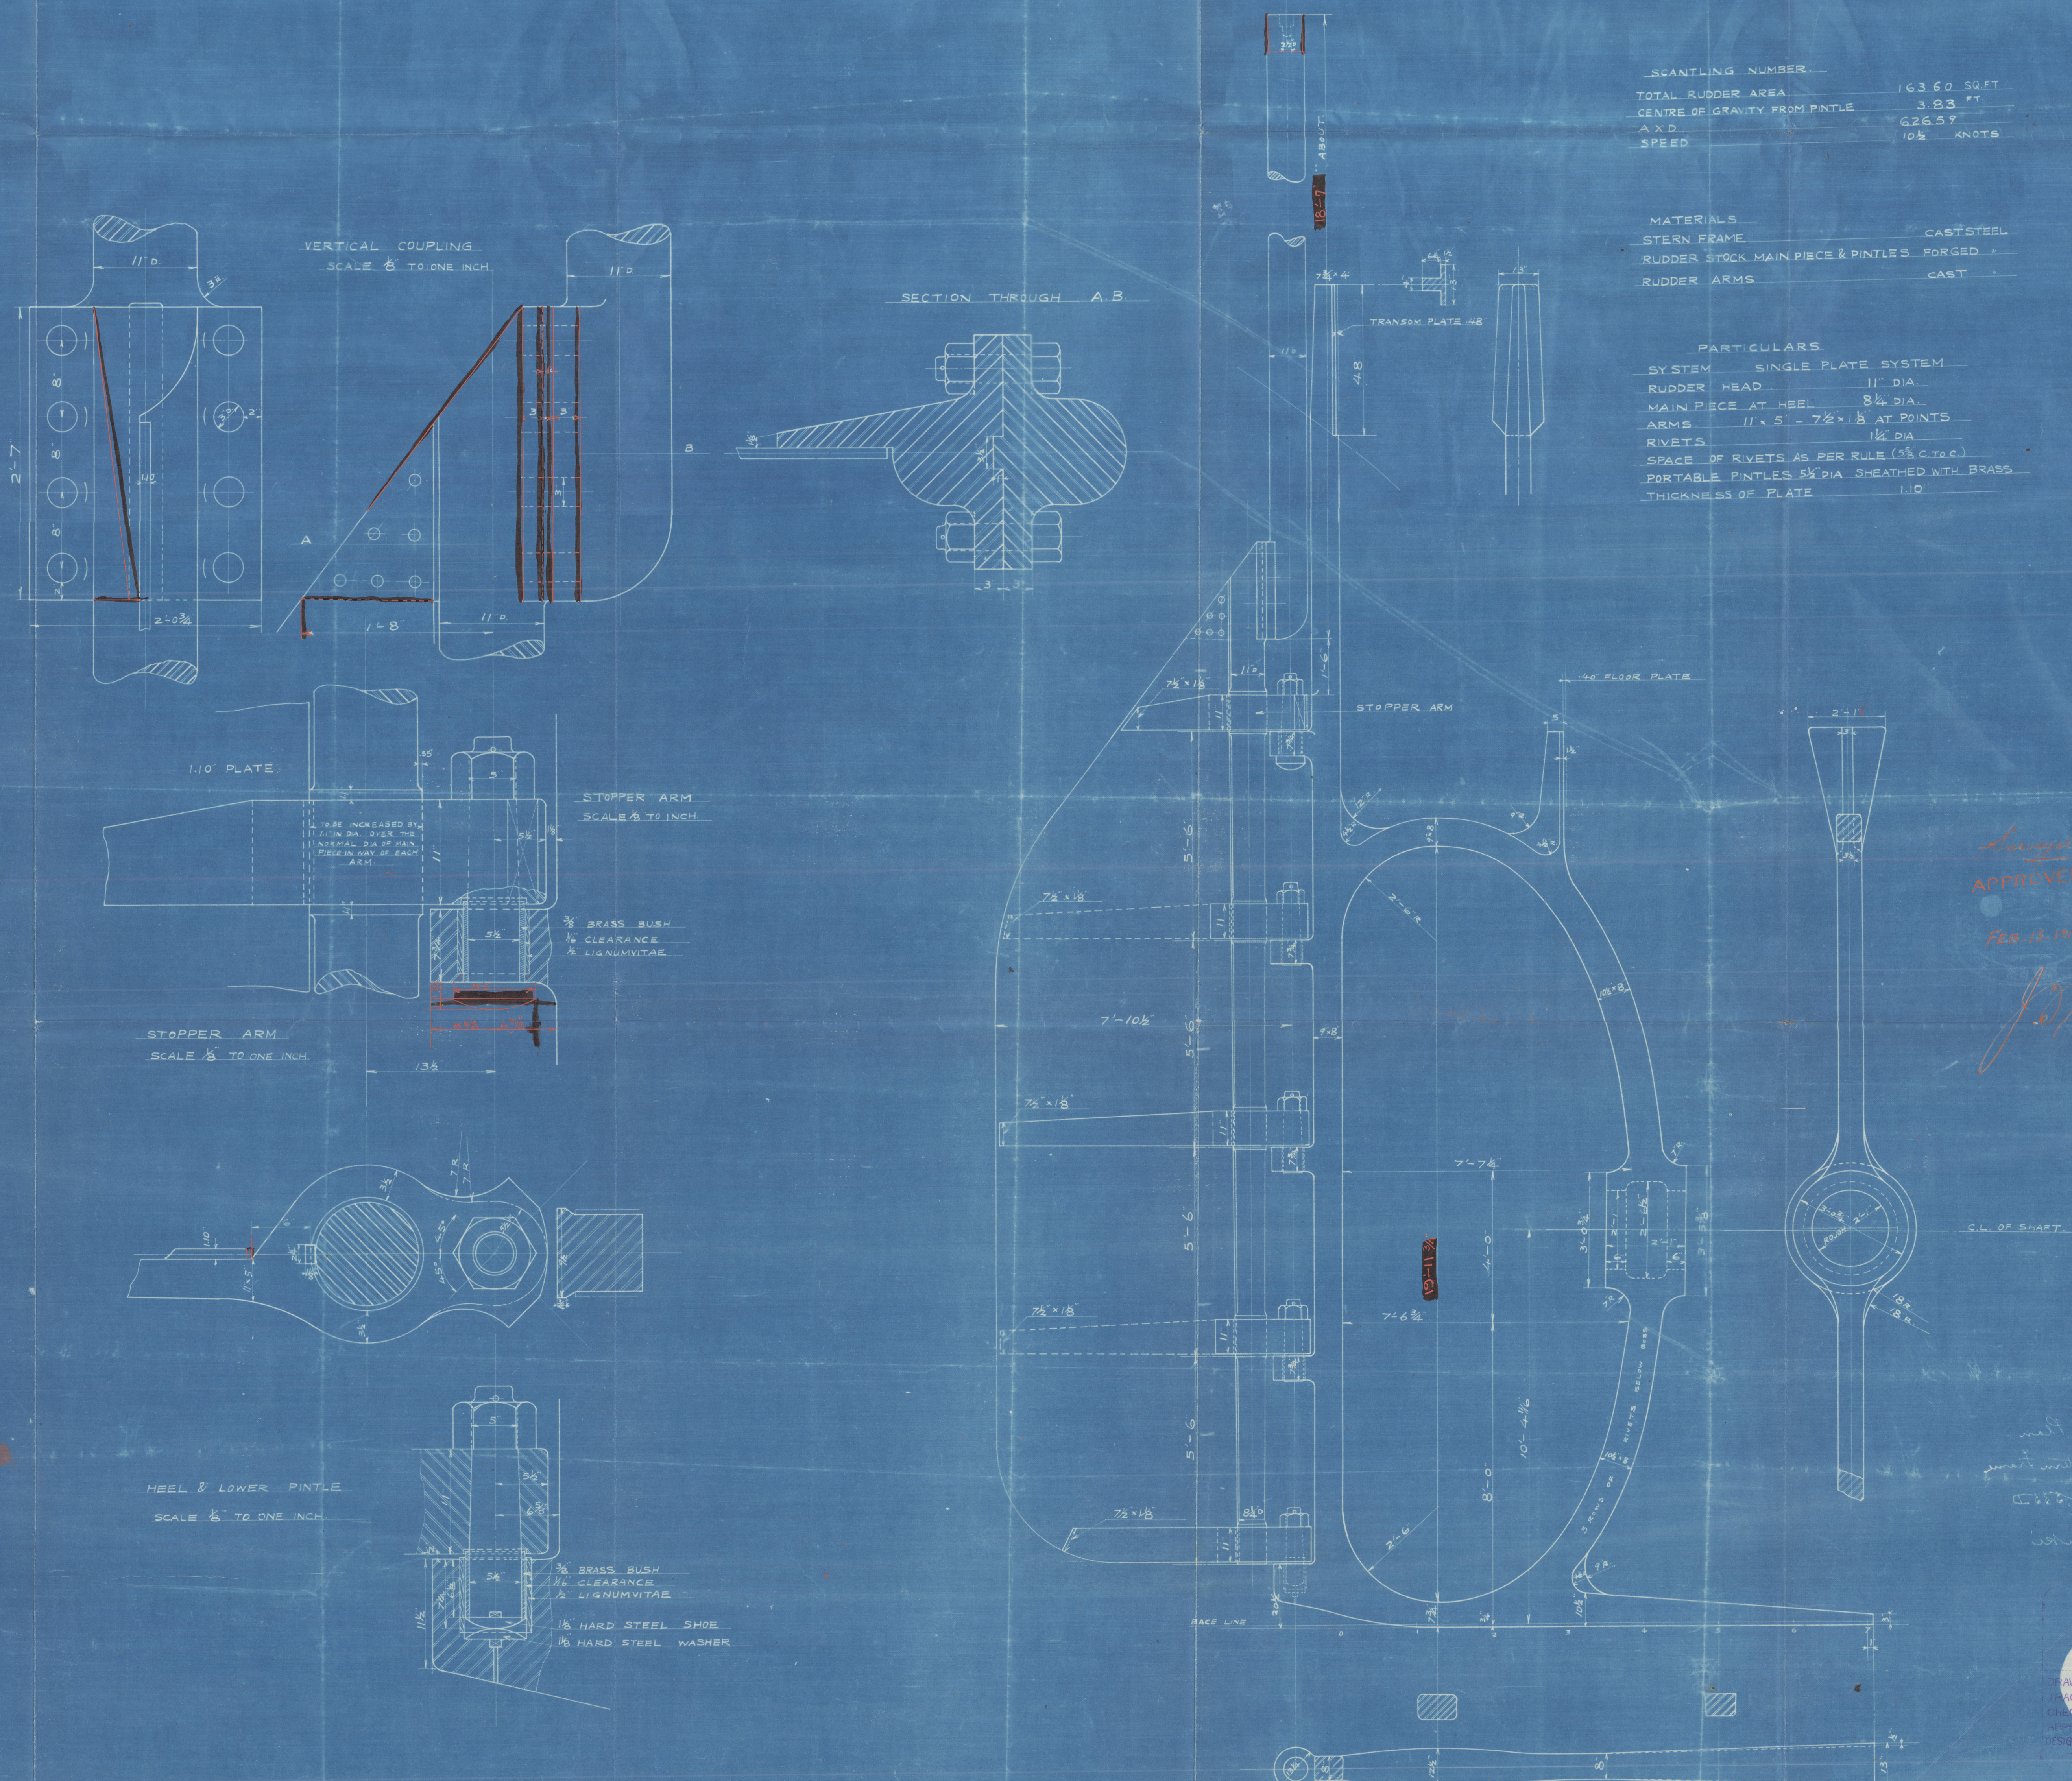

MITSUBISHI
ZOSSEN KAISHA, LTD.
NAGASAKI WORKS.
SHIP DESIGNER'S OFFICE, A.

Rudder + Sternframe.

S.S. No. 330.

Mitsubishi Zosen Kaisha

Nagasaki, Report No. 1278.

"Atlas Maru"



© 2021

Lloyd's Register
Foundation

006760-006771-0053