


SCALE $\frac{1}{8}$ INCH TO ONE FOOT.

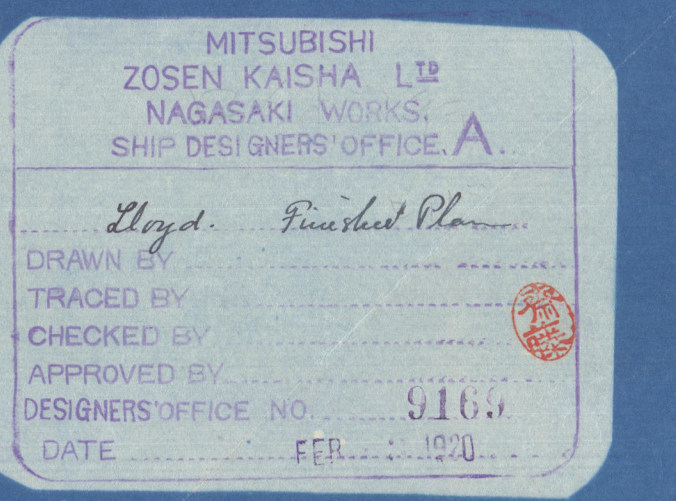

Profile and Deck

S.S. No. 330.

Mitsubishi Gosen Kaisha.

Nagasaki, Report No. 1278.

"Atlas Maru"



© 2021

Lloyd's Register
Foundation

006760-006771-0054