



3-6-54

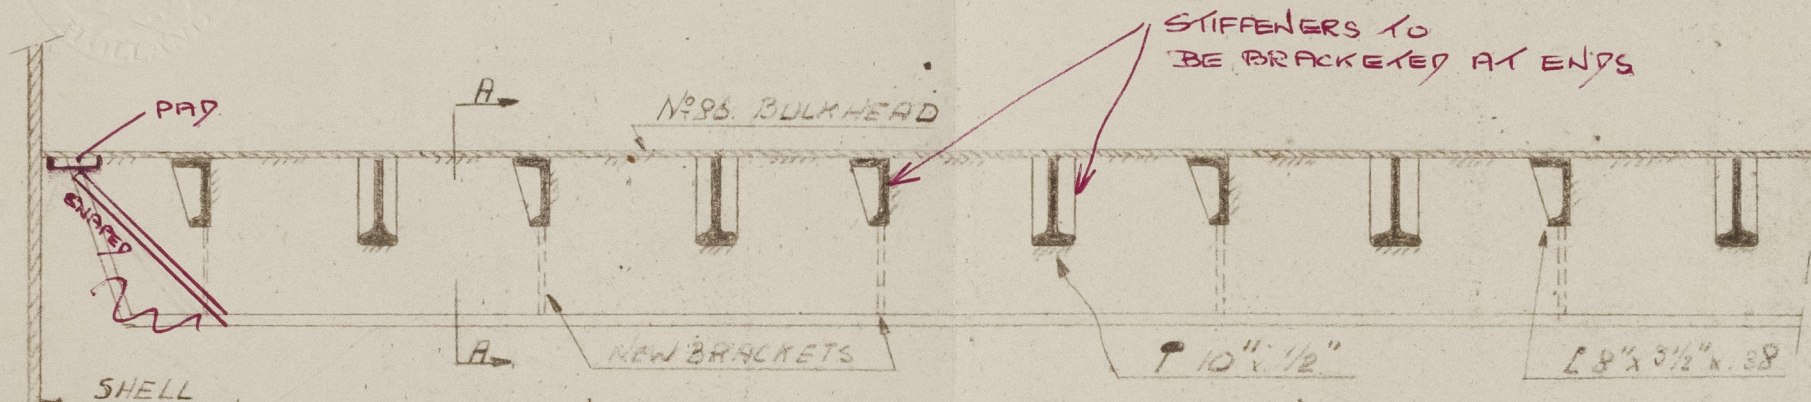

SECTION 'A-A'

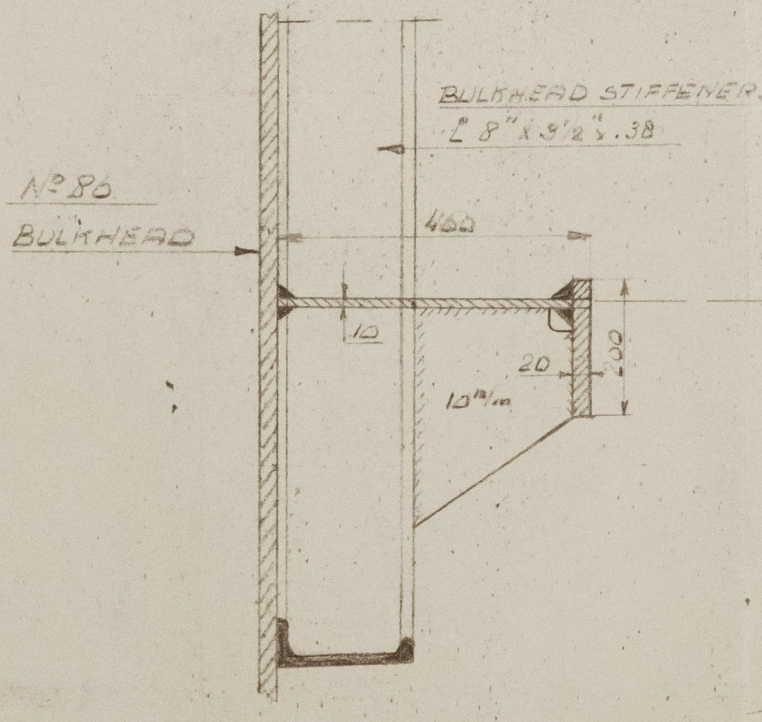

BELONGS TO  
ROTTERDAM REPORT No. 7

37990 a

U/R.  
3-6-54

SS "ROYAL WILLIAM"

HDR. STRINGER TO  
N°86 BULKHEAD



© 2020  
Lloyd's Register  
Foundation

006780-006786-0035

"Royal William"

Ppt. no. Rot. 37990

Hdn. stringer to No 86. bulkhead.



© 2020

Lloyd's Register  
Foundation

006780-006786-0035