



3-6-54


Nº 86 BULKHEAD

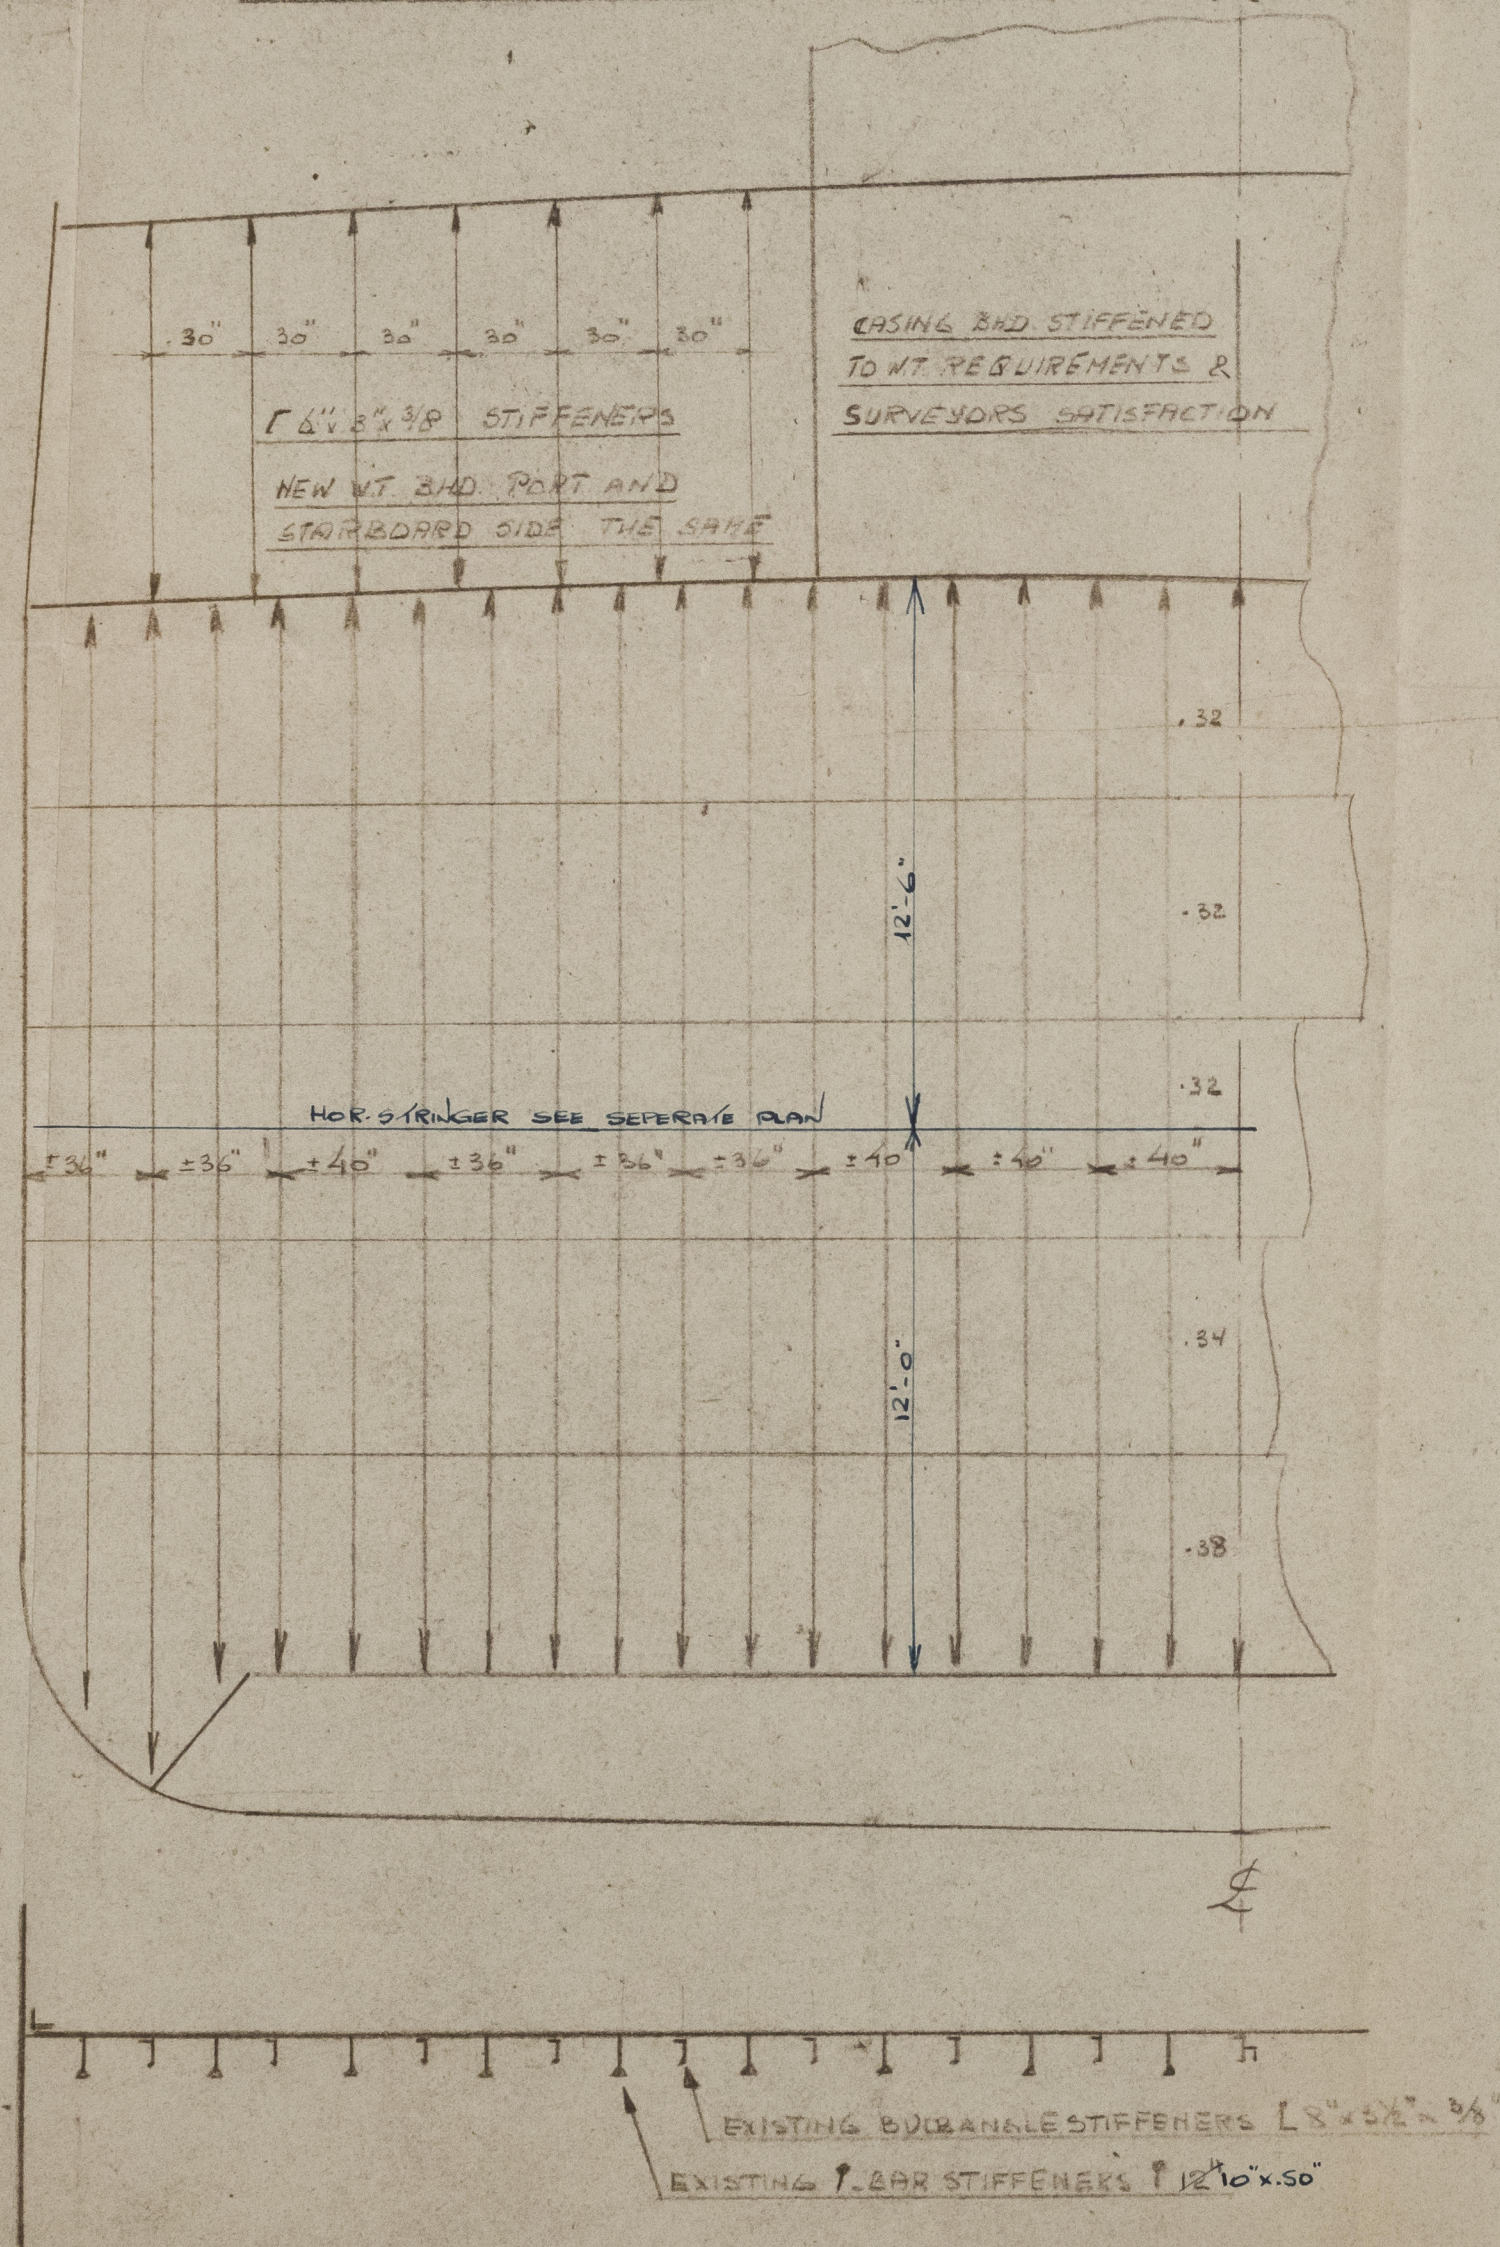

Nº 93 BULKHEAD

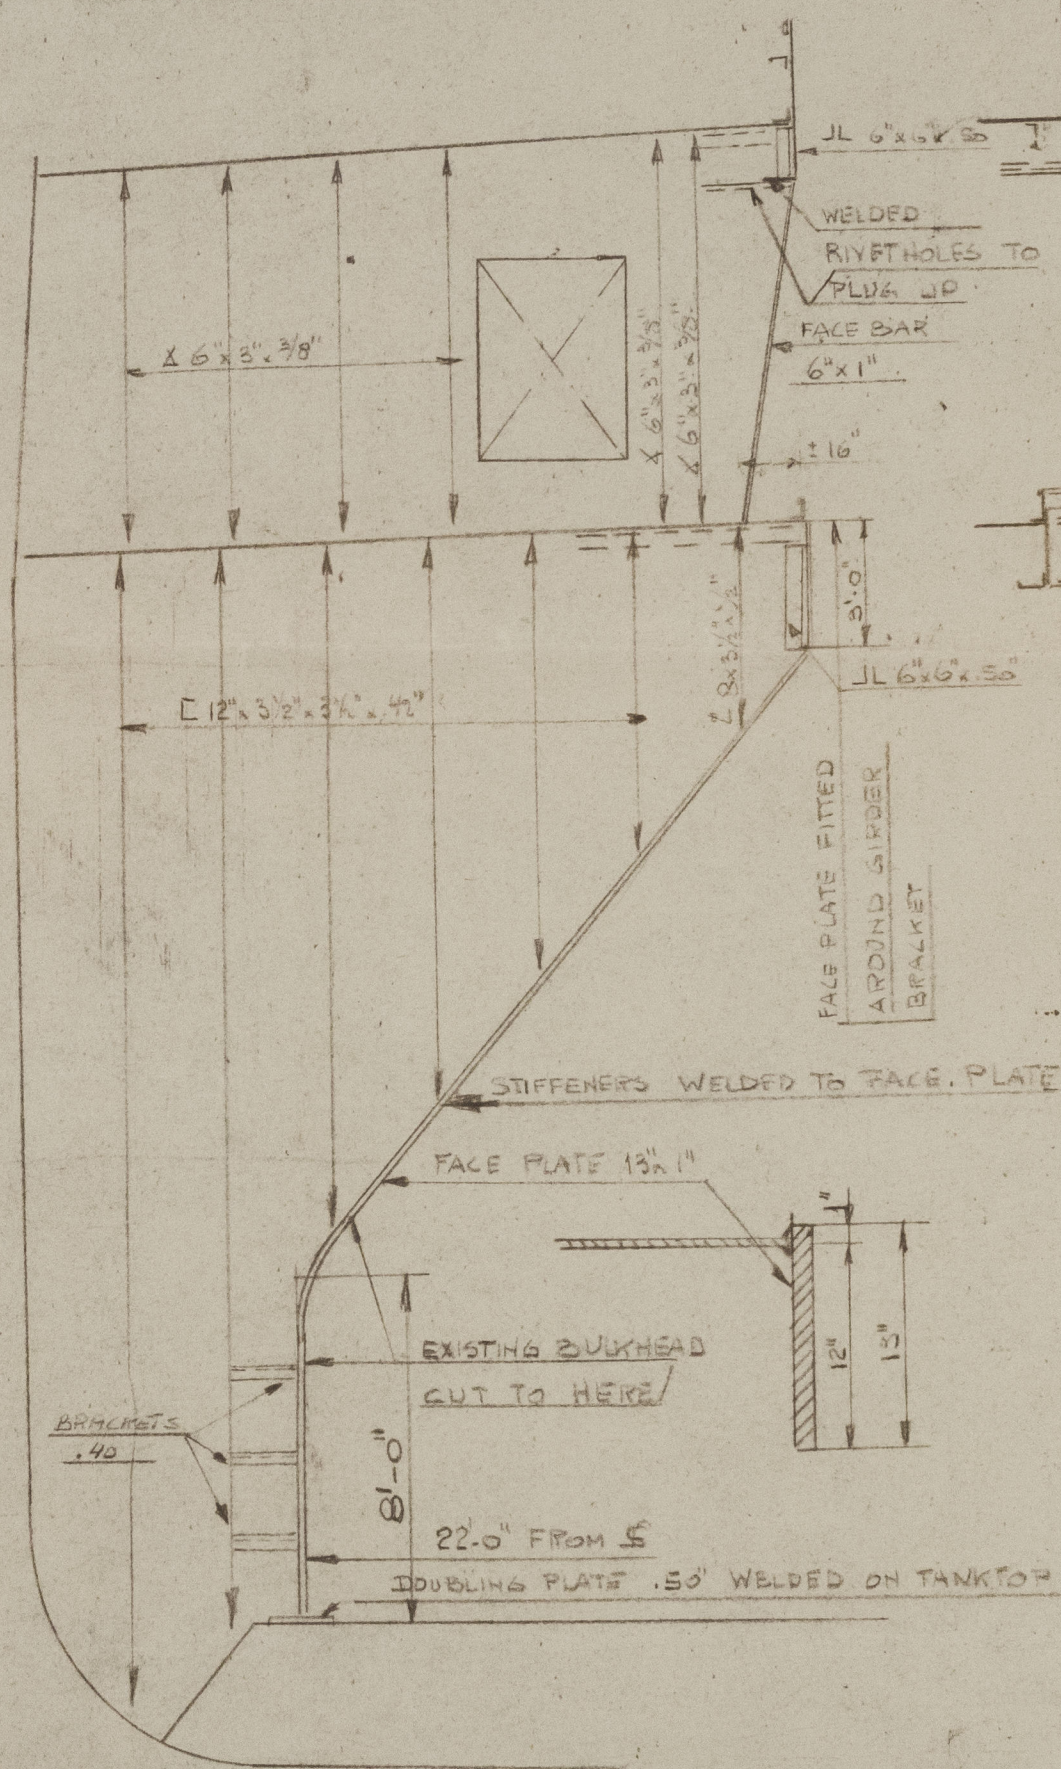

ELEVATION OF HATCH SIDE GIRDERS.

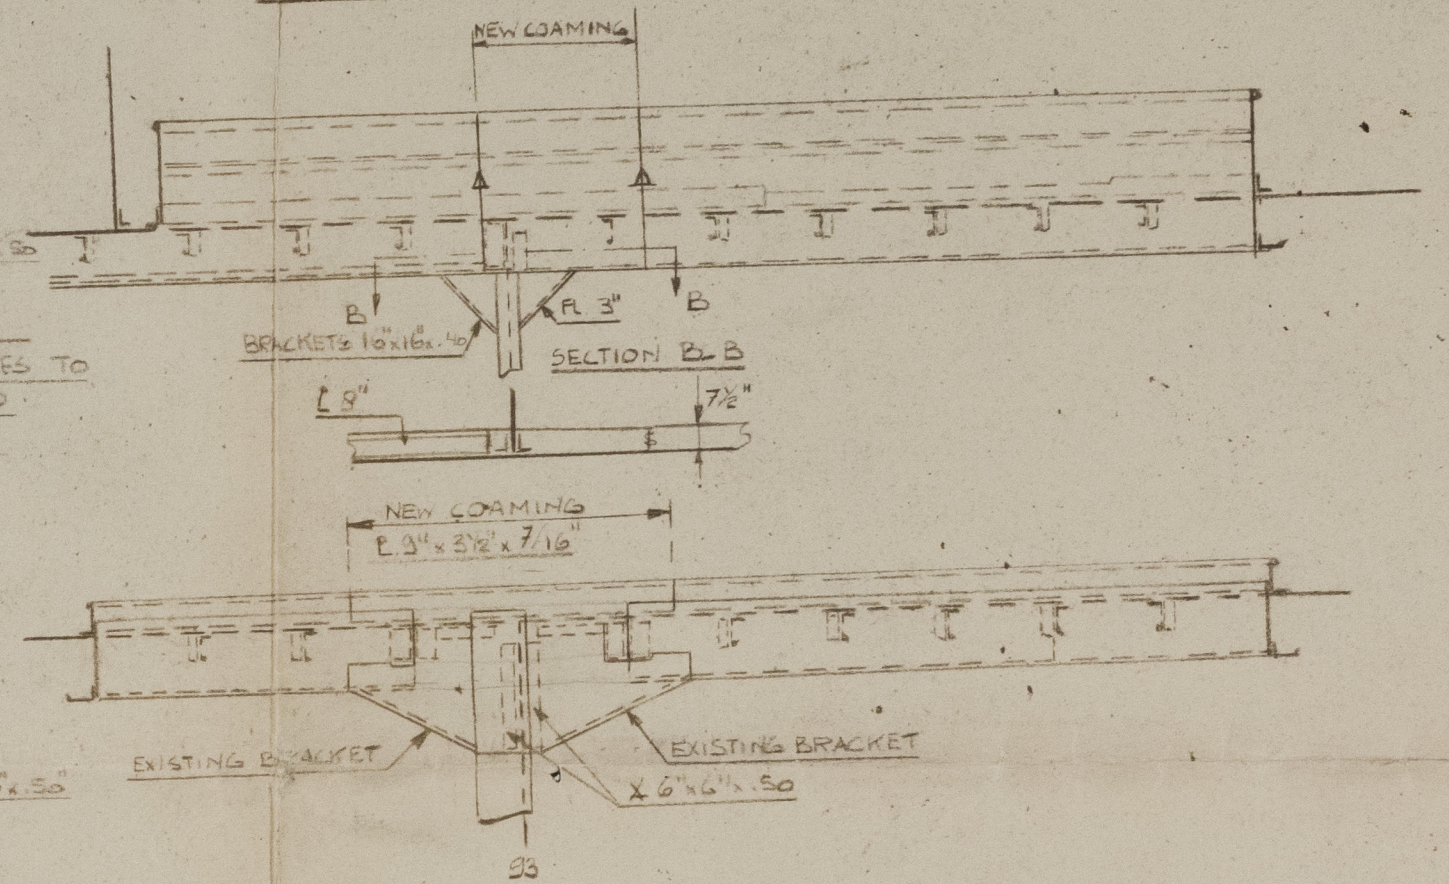

ROYAL WILLIAM
S.S. "ANDERMATT"
BELONGS TO
ROTTERDAM REPORT Nº
37790 A

MODIFICATION TO Nº 3^A HOLD

DM.
3-6-54

390

Modification to No 3rd hold.

"Royal William"

Rpt. no. Ref 37990.



© 2020

Lloyd's Register
Foundation

006780-005786-0036