


No. 368 SHIP.

OUTLINE SKETCH OF DECK ERECTIONS.

SCALE $\frac{1}{8}$ " = 1 FOOT.


Corrected in Blue by

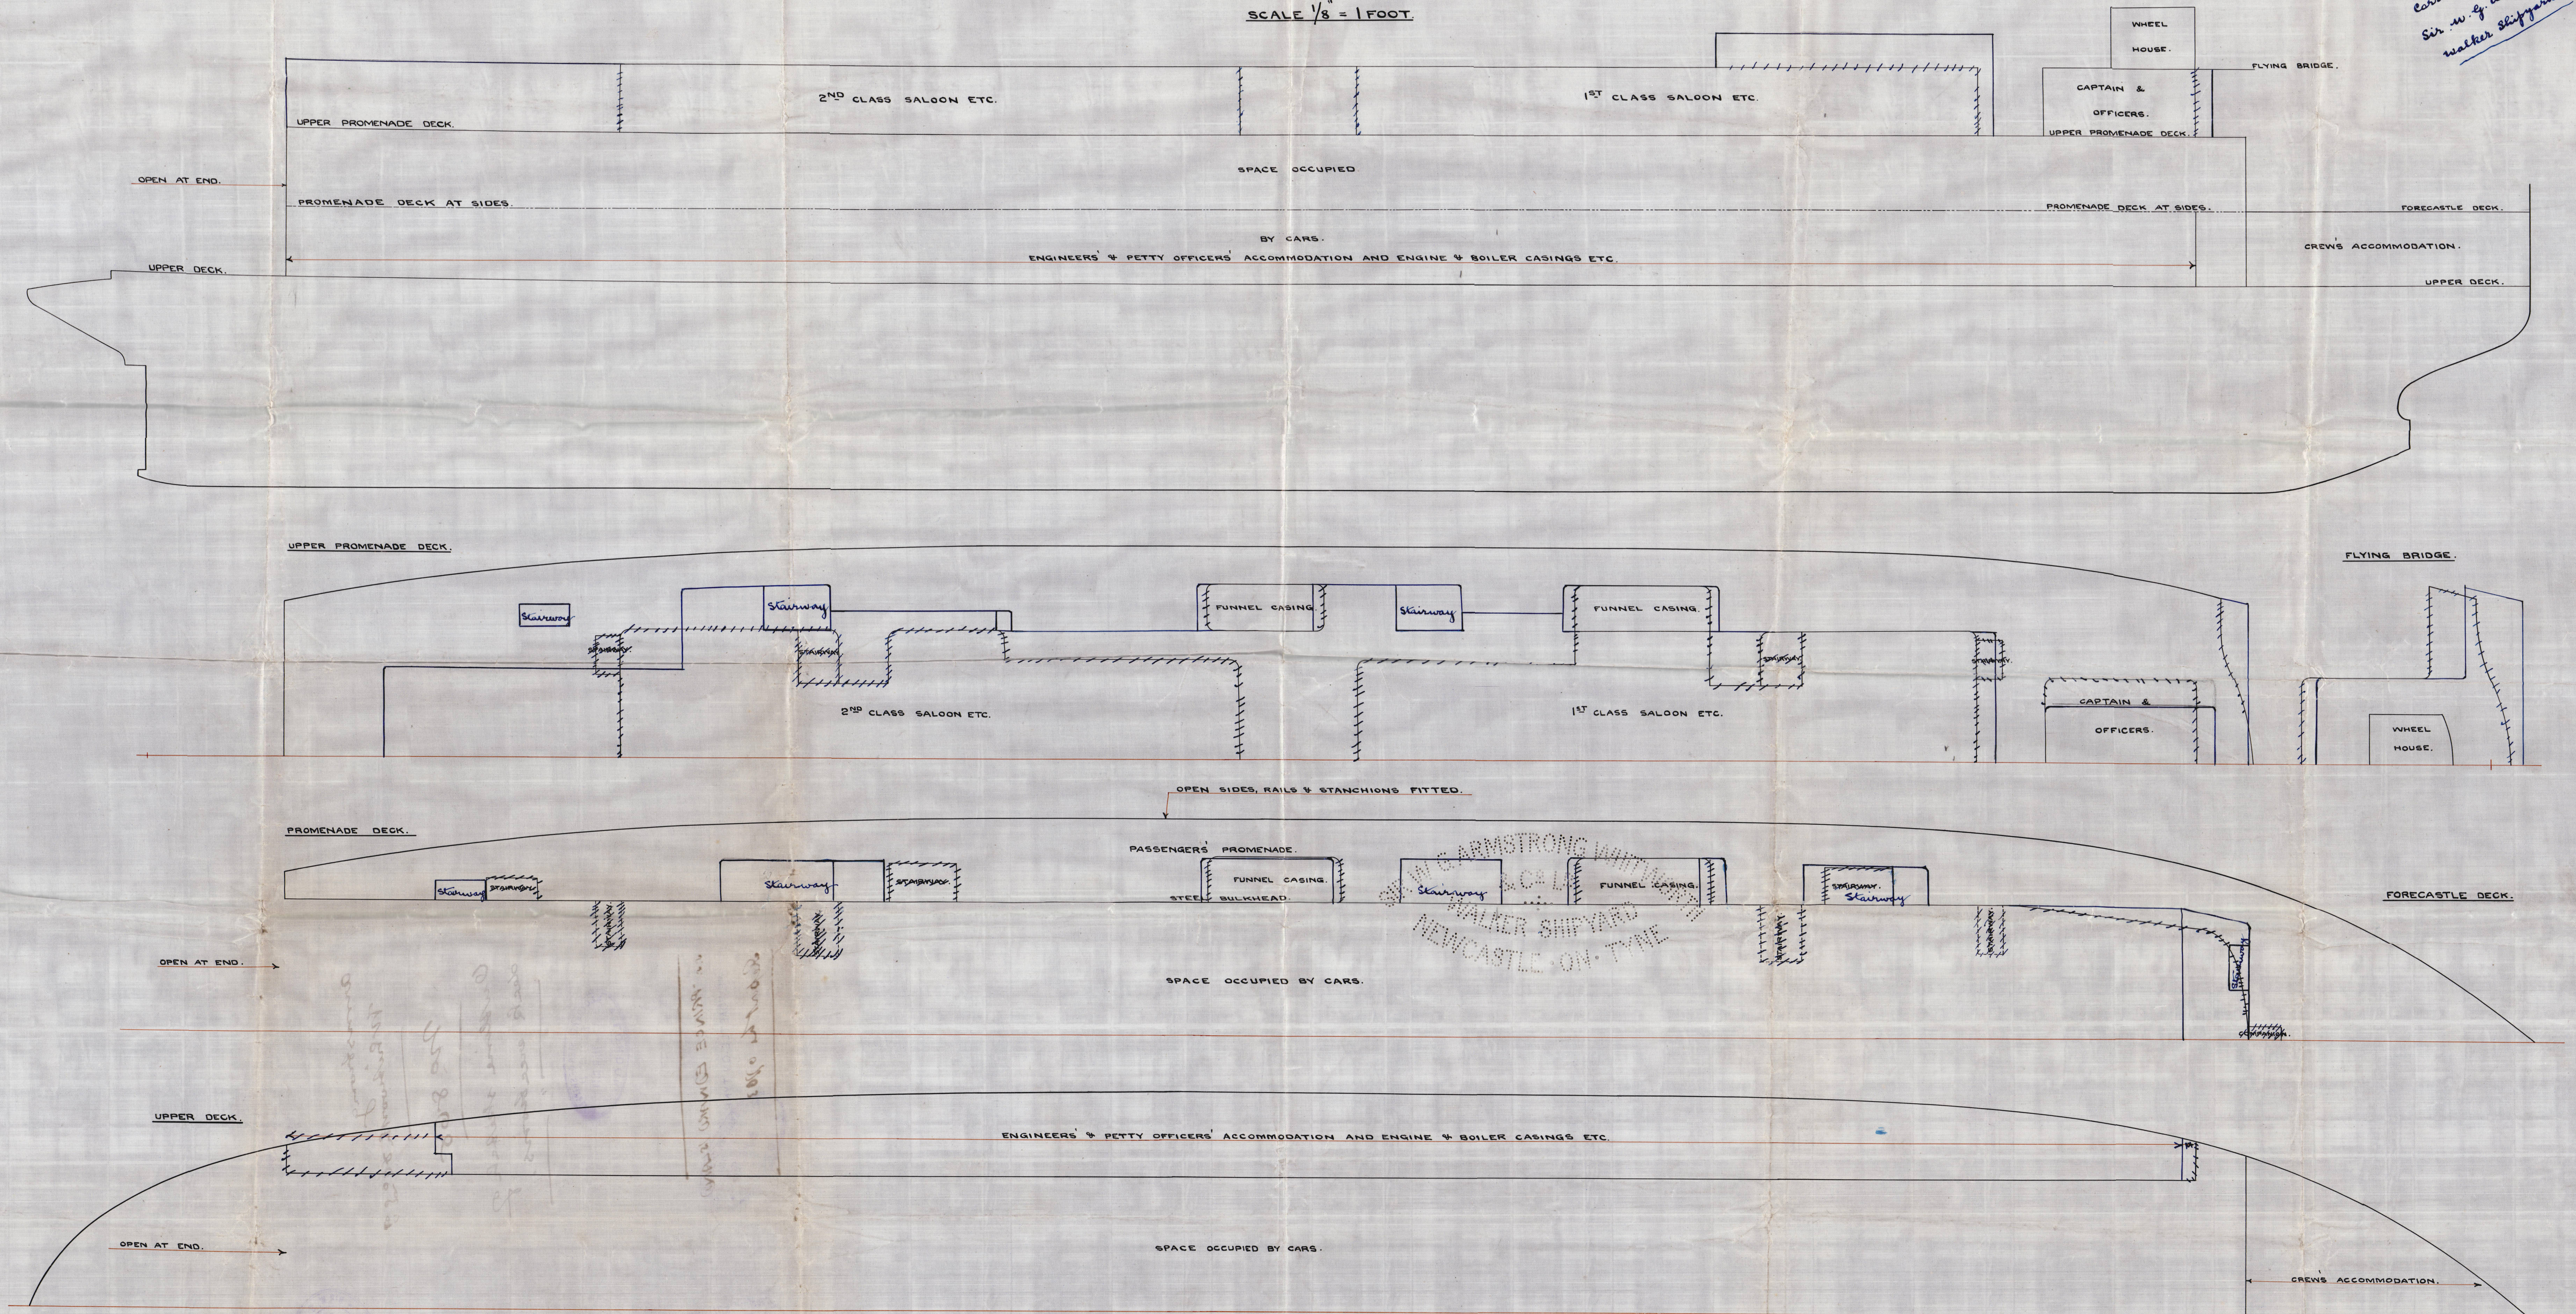

Armstrong
Whitworth & Co. Ltd.

No. 868


Outline sketch of
deck erections.

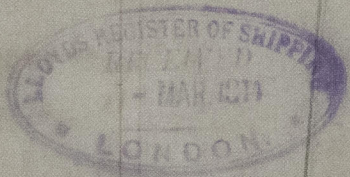

S.S. "PRINCE EDWARD ISLAND"

NEWCASTLE-ON-TYNE

Report No. 6703

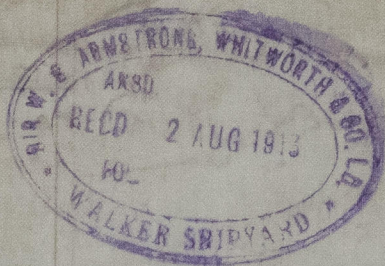

© 2020

Lloyd's Register
Foundation

006780-006786-0099