

AUG 28 1939

Lloyd's Register of Shipping.

INTERNATIONAL CONVENTION 1930 RESPECTING
LOAD LINES.

PERIODICAL SURVEY IN ACCORDANCE
WITH ART. 14.

(Port) HAVRE.

(Date) 25th August 1939

I have to report that I have surveyed the Steamer

"GRANDLIEU" of NANTES. O.N. _____

on this date, in accordance with Article 14 of the above Convention, and I
have endorsed the Freeboard Certificate as under:—

*J'ai visité ce navire pour m'assurer que ce Certificat
pouvait rester en vigueur et la visite a été effectuée à
ma satisfaction.*

Nantes 23^{er} Août 1939

Sd. J. Meillet.

(Certified Copy similarly endorsed) *Inspecteur du Lloyd's Register*

(Signature of Surveyor.)

J. Meillet

(Place.)

Nantes.

(Date.)

23-8-39.

REMARKS.

Vessel Surveyed afloat.

*No material alterations have taken place in the Hull
or Superstructures of this Vessel. The fittings and
appliances for the protection of openings in decks and
Ship's Sides. The Guard Rails, freeing ports and the means
of Access to Crew's Quarters have been found or placed
in good Condition.*


*Now done: 20 Wood hatch covers renewed. Screw fastenings
hinged steel doors at front end of Bridge Space overhauled
if necessary.*

FRM

*720- } 970-
250 }*


Is fee paid ☒

Surveyors should note that there is only one valid certificate, and the above endorsement should
made thereon. No entry should be made on a certified copy of the certificate unless the original
certificate has been produced to and endorsed by the Surveyor.

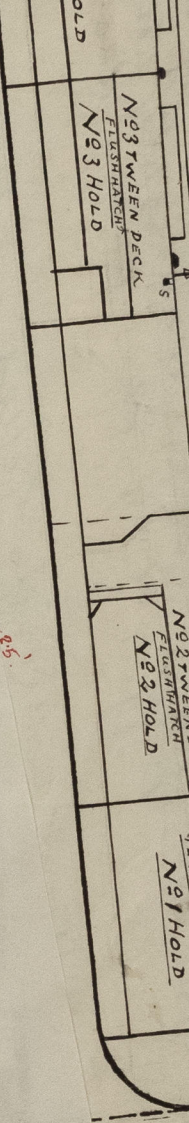

Form C11 (b).

© 2021
Lloyd's Register
Foundation

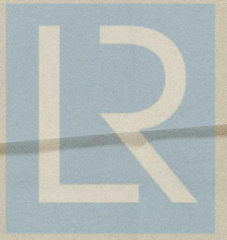

PER

"GR

on this date,

have endorsed

For
Certificate
Effectue

Similarly
loosed.

(Signature

essel

stena

stuct

notect

and

and

beeg

nt

FRA

500

500

ports sho
thereon.
has been

INTERNA

construction of the
country
nation
sides of
state
end
on Helokow
and the in
1 @ 14' 9" x 14' 2"
1 @ 14' 9" x 3' 8"
2 @ 14' 9" x 4' 2"
1 @ 14' 9" x 3' 8"
1 @ 14' 9" x 3' 8"
10' x 4' 2"
3' 3" x 3' 8"
Beam 3' 3" x 3' 8"
Bearing 3' 1 1/2"
In Paulown + bedlam
an entrance
effluent

Received by me

Maitais de

488.
5.
493.

8-28
8-28
8-28