


GENERAL ARRANGEMENT OIL & PACKAGE CARGO VESSEL

DIMS:- 180'-0" BP x 33'-0" B^M x 17'-6" D^M

SCALE:- 1/8" = 1 FOOT

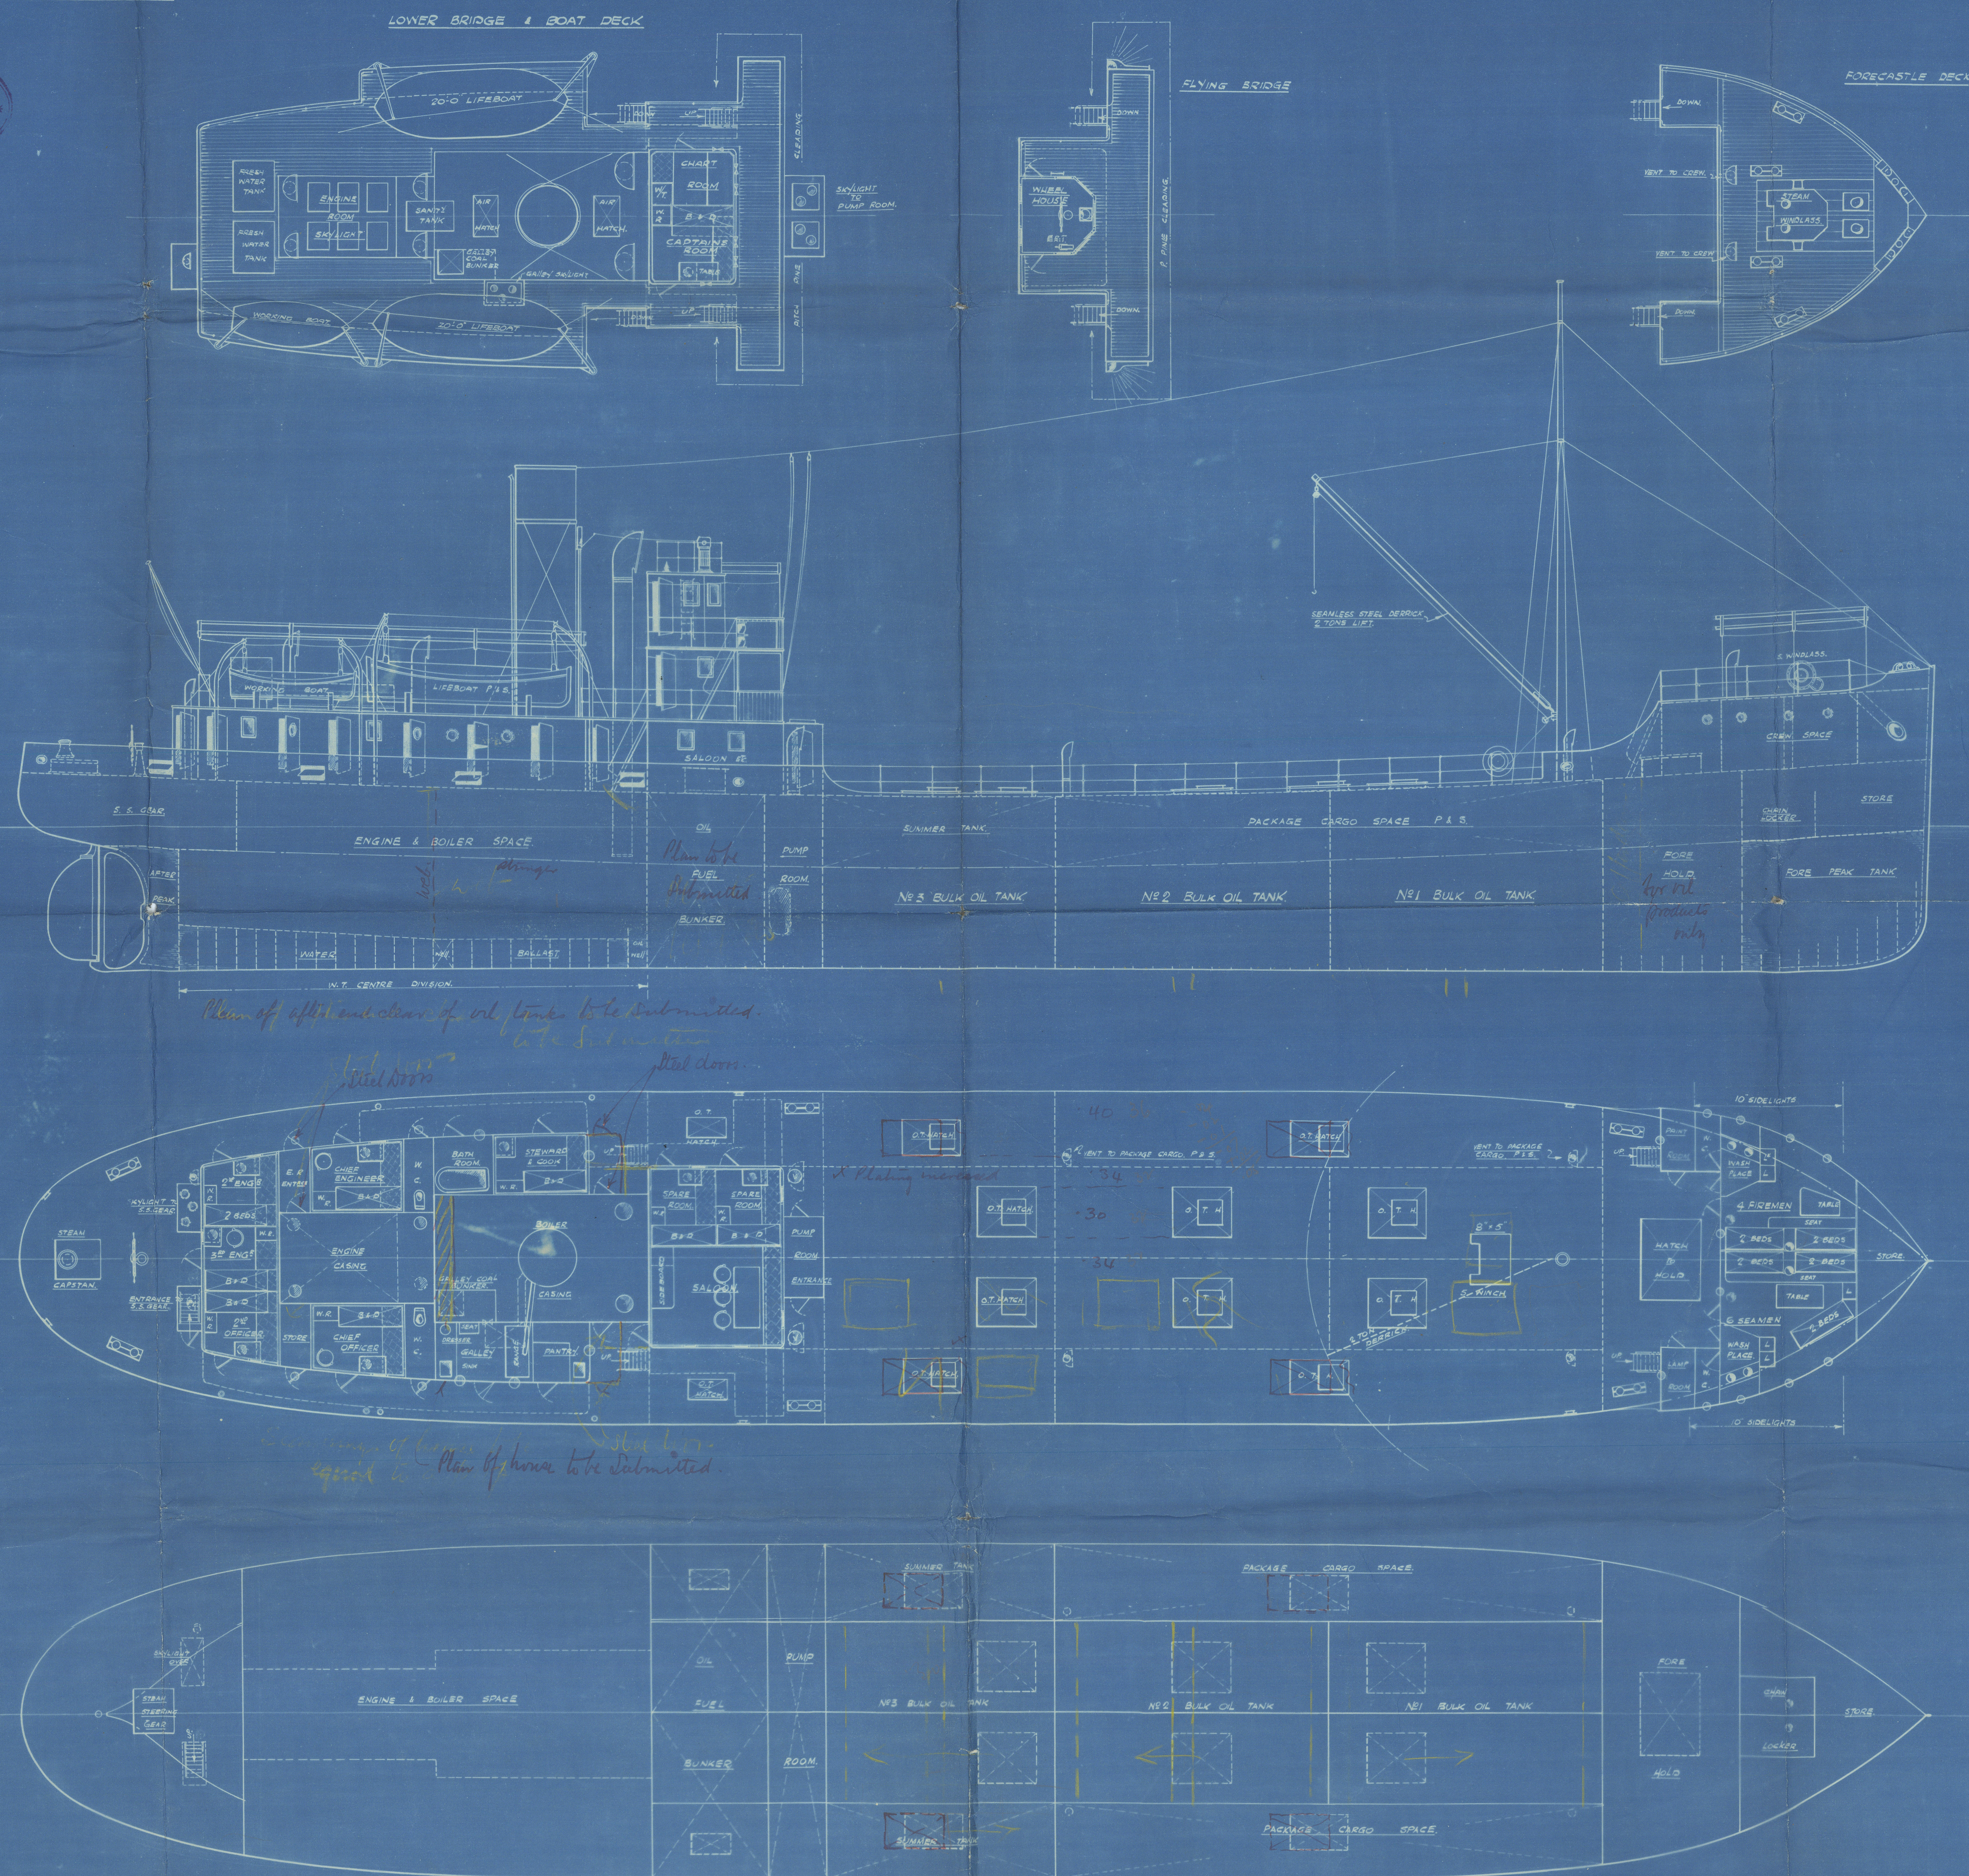

Oil Tanker

General Arrangement-

Preliminary Here

GEN. EXH. 2

909

Indb 13608.

See later plan

s/s "Here"



© 2021

Lloyd's Register
Foundation

006797-006808-0093