

26-1-16

MIDSHIP SECTION

OF
SHIP No 39

CLASS: 100 A. 1. * BRITISH LLOYD

ALL MATERIAL: STEEL

SCALE $\frac{1}{2}$ " = 1' ENG. MEASURE

DIMENSIONS

LENGTH B.P. 109' 3"
BREADTH MLD. 21' 6"
DEPTH MLD. 14' 0"

TRANSVERSE NR.

$21,5 \times 14,0 = 35,5$

LONGITUDINAL NR.

$35,5 \times 109,25 = 3878$

2 FOR FARMES 12' 11"

$\frac{4}{0} = 7,8$

EQUIPMENT NUMBER

LONGITUDINAL NR. 3878
+ FOR DECK HOUSES $\left\{ \begin{array}{l} \frac{1}{2} \times 28,25 \times 4 = 67 \\ \frac{1}{2} \times 27,25 \times 7 = 95,4 \end{array} \right.$
4040,4

2 BOW ANCHORS COLLECT. WEIGHT 10 CWT. ECL. STOCK

1 STEAM ANCHOR WEIGHT $1\frac{3}{4}$ " " " "


1 HEDGE " " " " " "

CHAIN CABLES 135 FTMS. $1\frac{1}{16}$ " 3 HORT LINK

STEEL WIRE 45 " 2"

" " 75 " $2\frac{1}{4}$ "

" " 90 " $1\frac{1}{4}$ " OR HEMP 4"

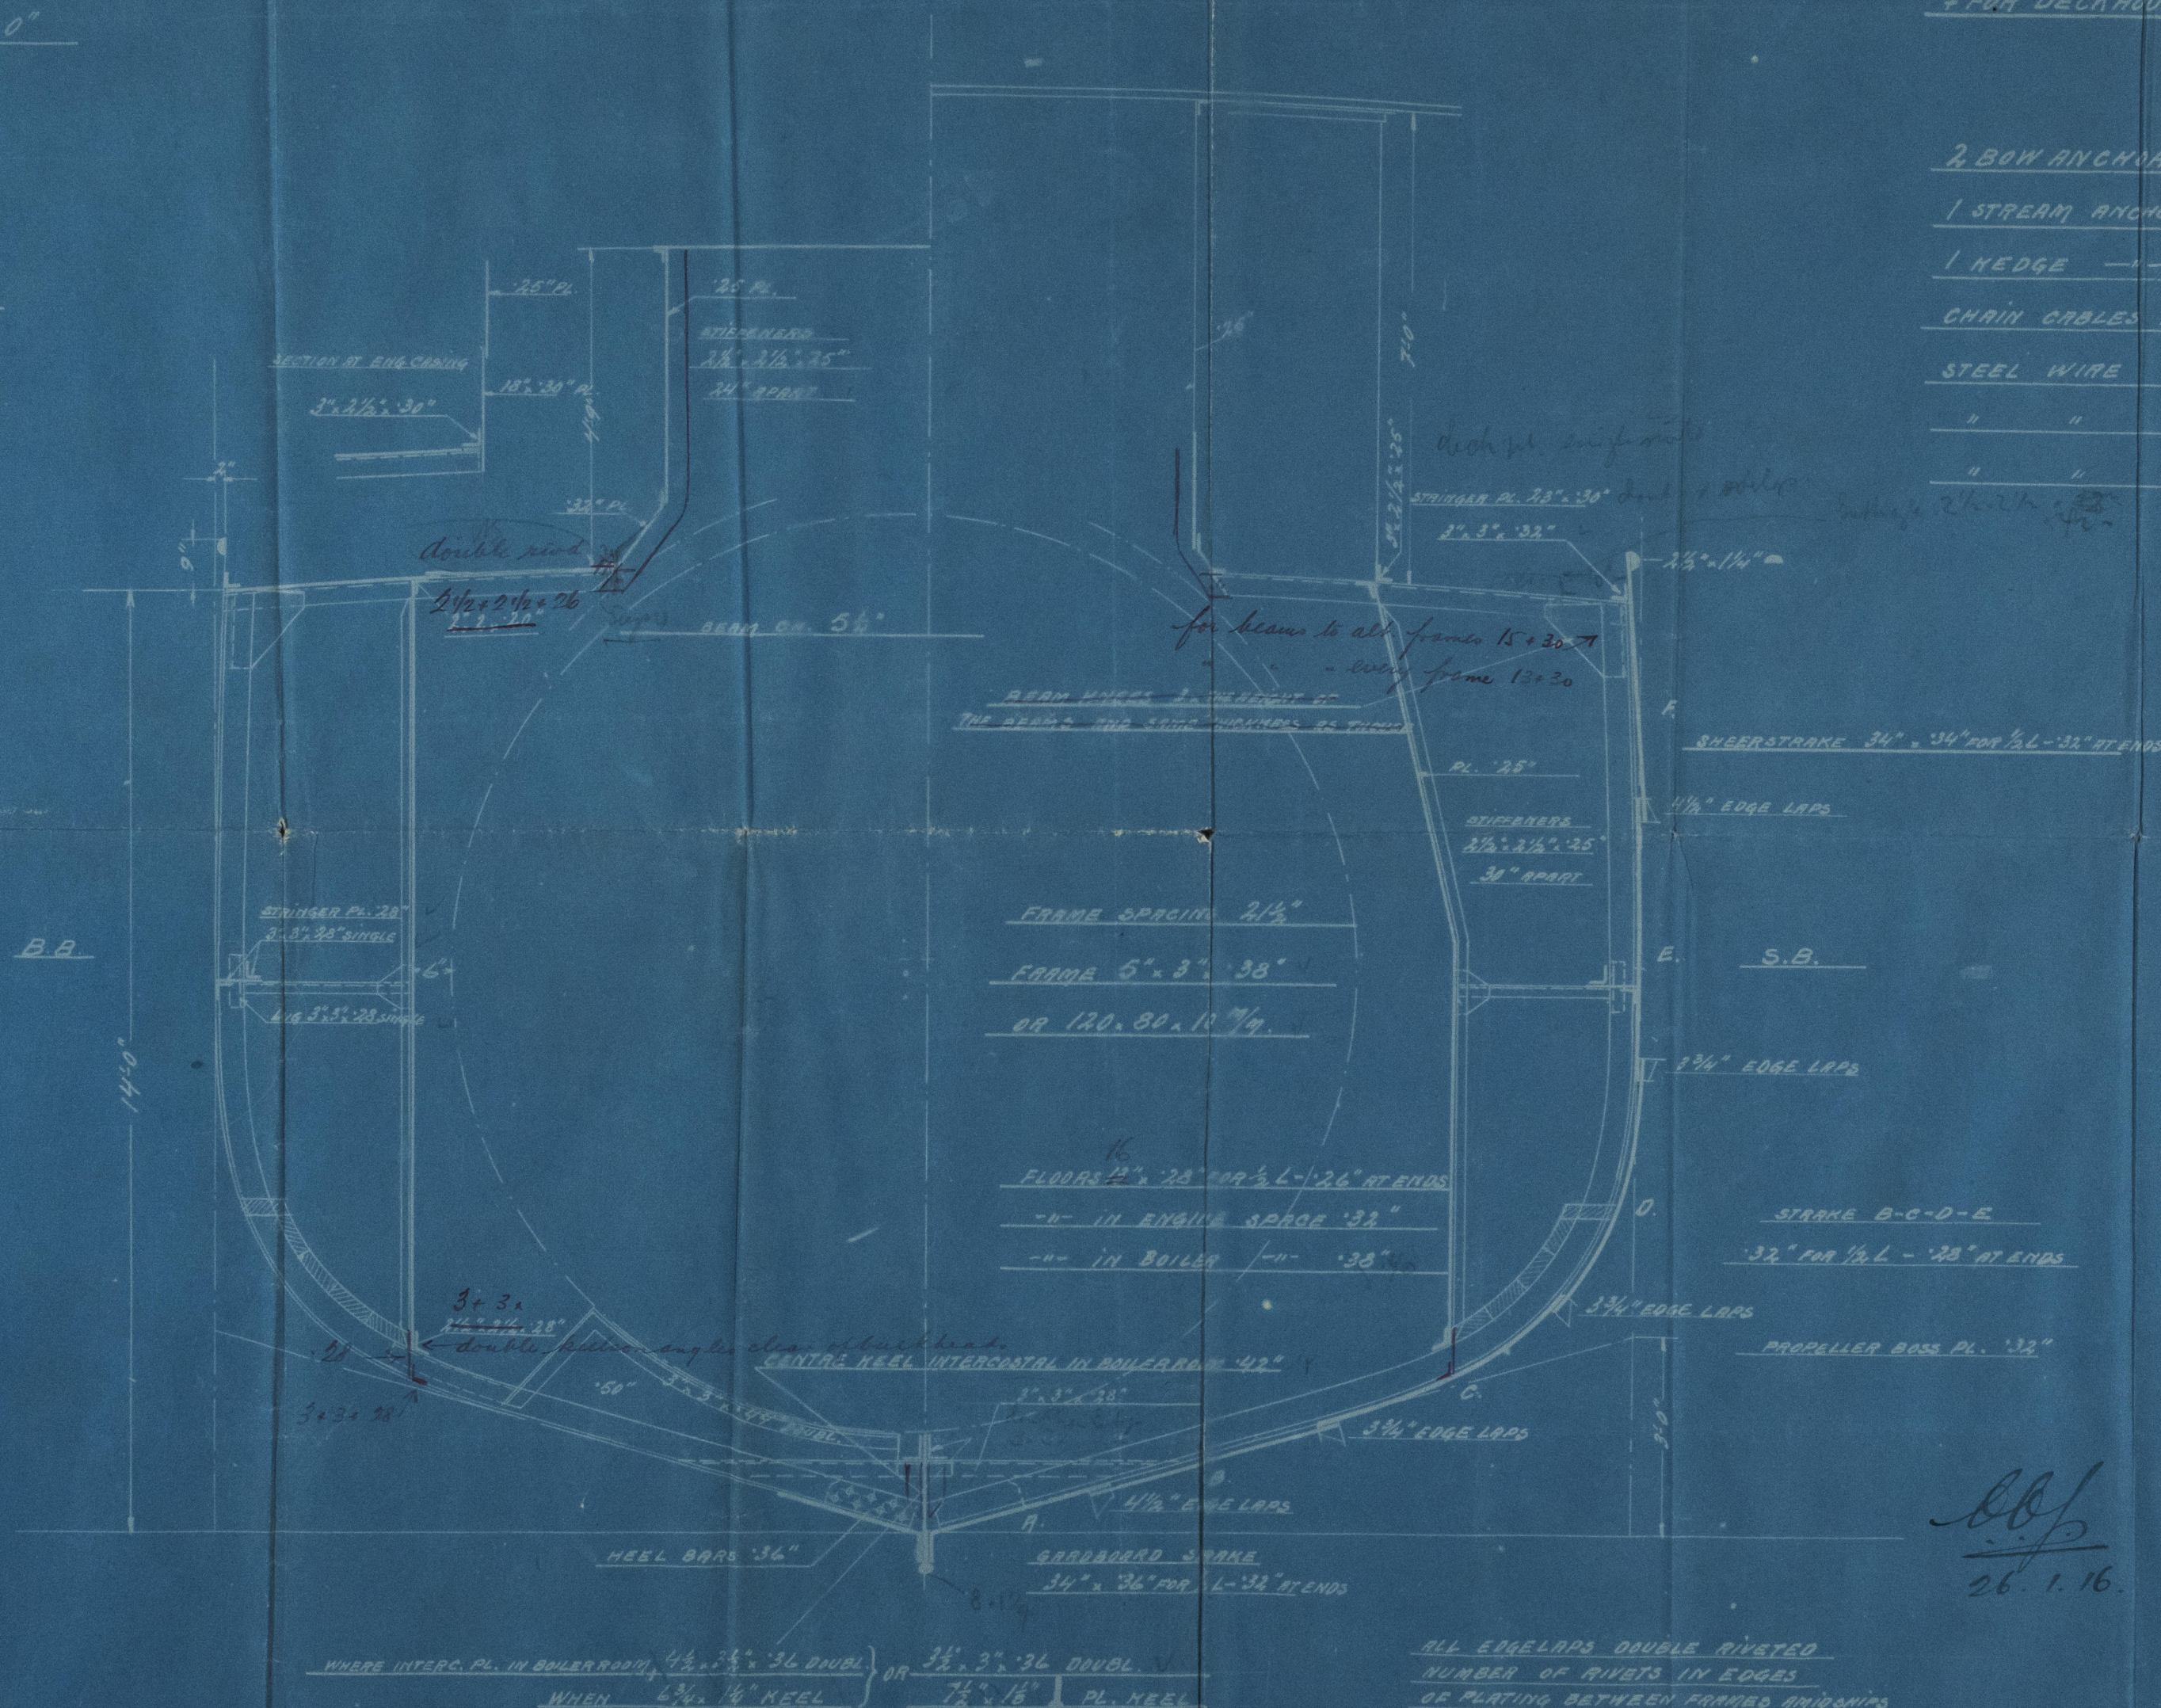


SOME OF THE PLATES AND ANGLES ARE STATED IN M/M, AS THESE ARE TO HAVE FROM STOCK.

ALL EDGELAPS DOUBLE RIVETED
NUMBER OF RIVETS IN EDGES
OF PLATING BETWEEN FRAMED ANCHORS
EXCLUDING RIVETS IN FRAMES
6 RIVETS $\frac{1}{4}$ " DIA. WHERE PL. 3/4" AND OVER
7 " " " " " " UNDER 3/4"

ALL SHELLPLATES DOUBLE RIVETTED OVERLAPS

26. 1. 16.

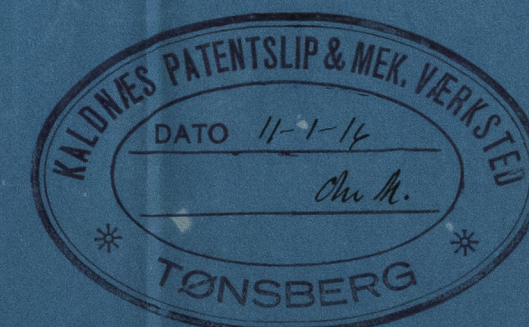

Midship section

ss. "Sorka"


Xia 1994.



© 2020

Lloyd's Register
Foundation

006809-006818-0053

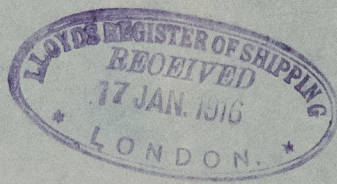

0053



© 2020

Lloyd's Register
Foundation