


No 999 14/12/33. FRAMING PROFILE

Scale:- 1/4" = 1 foot

DIMENSIONS:-
LENGTH ON W.L. 156'-6"
BREADTH MOULDED 46'-0"
DEPTH MOULDED 13'-5" TO MAIN DK.

TO CLASS LLOYDS * 100 A.I. WITH FREEBOARD
CORRESPONDING TO A MEAN DRAUGHT
OF 9'-2" FOR FERRY PURPOSES
RIVER MERSEY. [OLD RULES].


SUN DECK.
SHELTER DECK.
MAIN DECK.

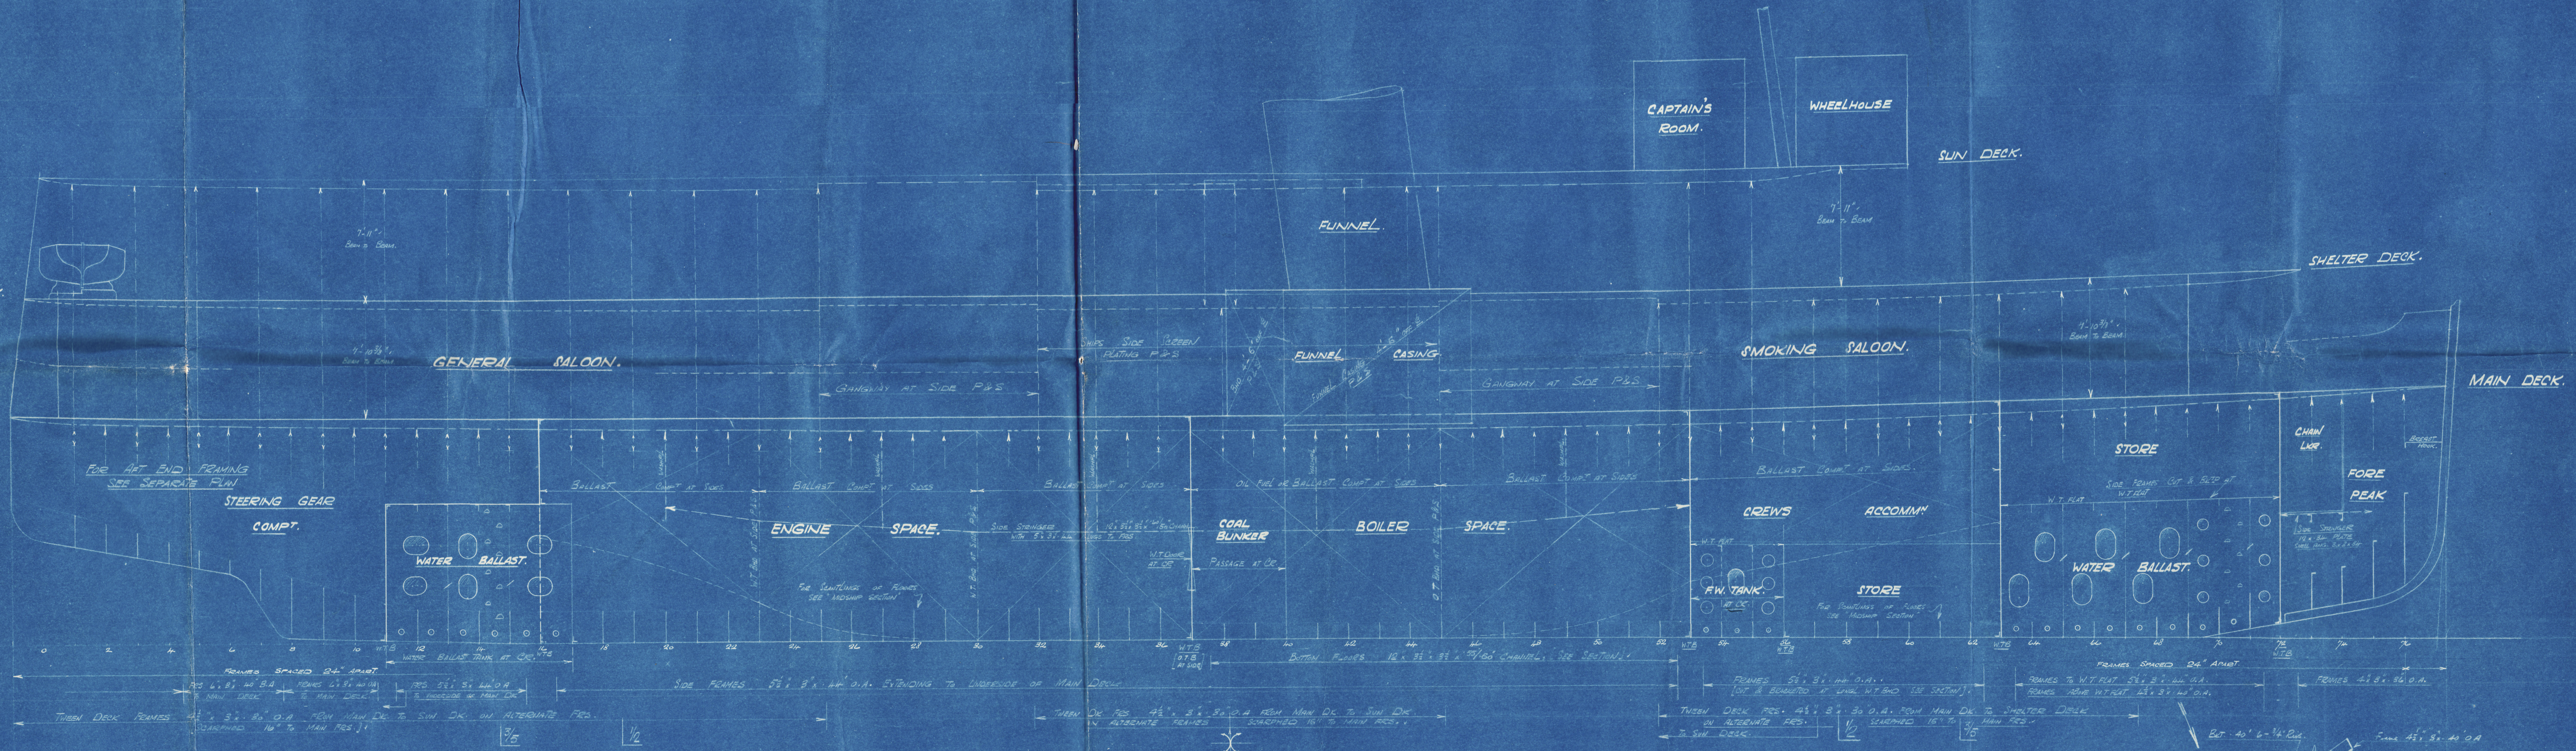

GAMMELL LAIRD & CO LTD
BIRKENHEAD.
FOR ENDORSEMENT TO
Register
DATE 8/12/33
SHIP DEPARTMENT.

TNo 20
DRAWN BY
CHECKED BY

NOTE:- FOR SCANTLING OF W.T.B.H.D.S.
AND WASHPLATES SEE SEPARATE
SUBMISSION.

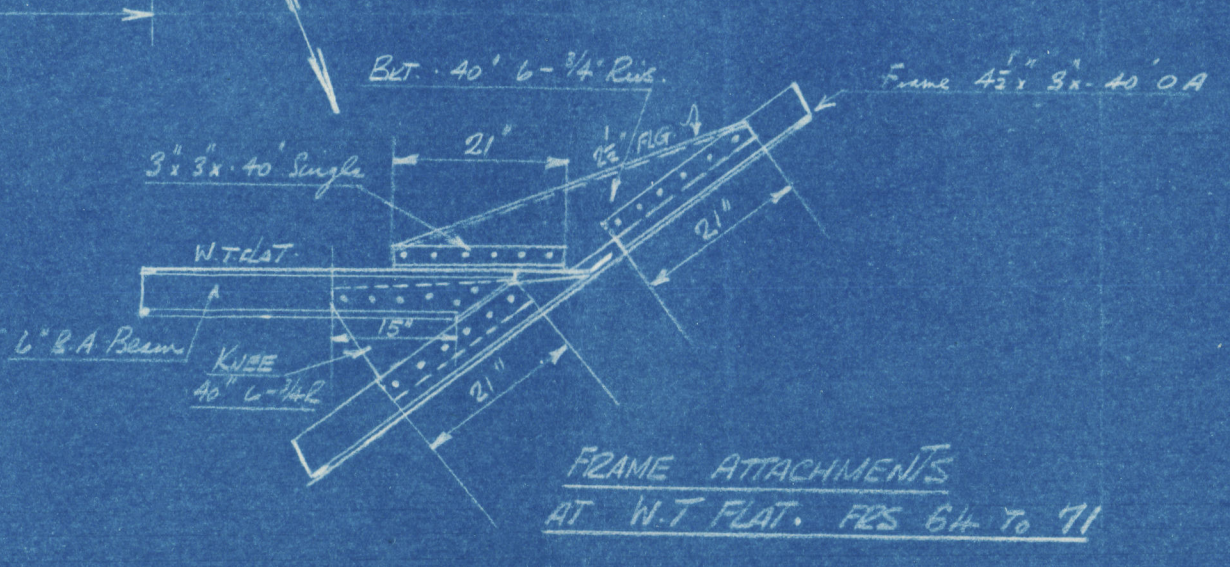

LLOYD'S REGISTER OF SHIPPING
-9 DEC. 1933
LIVERPOOL

LR

2

Cammell Laird & Co
999

Framing Profile

S.S. Royal Daffodil II

LIVERPOOL

Report No. 104171.



© 2020

Lloyd's Register
Foundation

006809-006818-0225