




10.12.29

SINGLE SCREW MOTOR TANKER No 179.
SHELL EXPANSION
SCALE 1/4" = 1 FOOT

SECTIONS OF POOP FRAMING
SCALE 1/2" = 1 FOOT

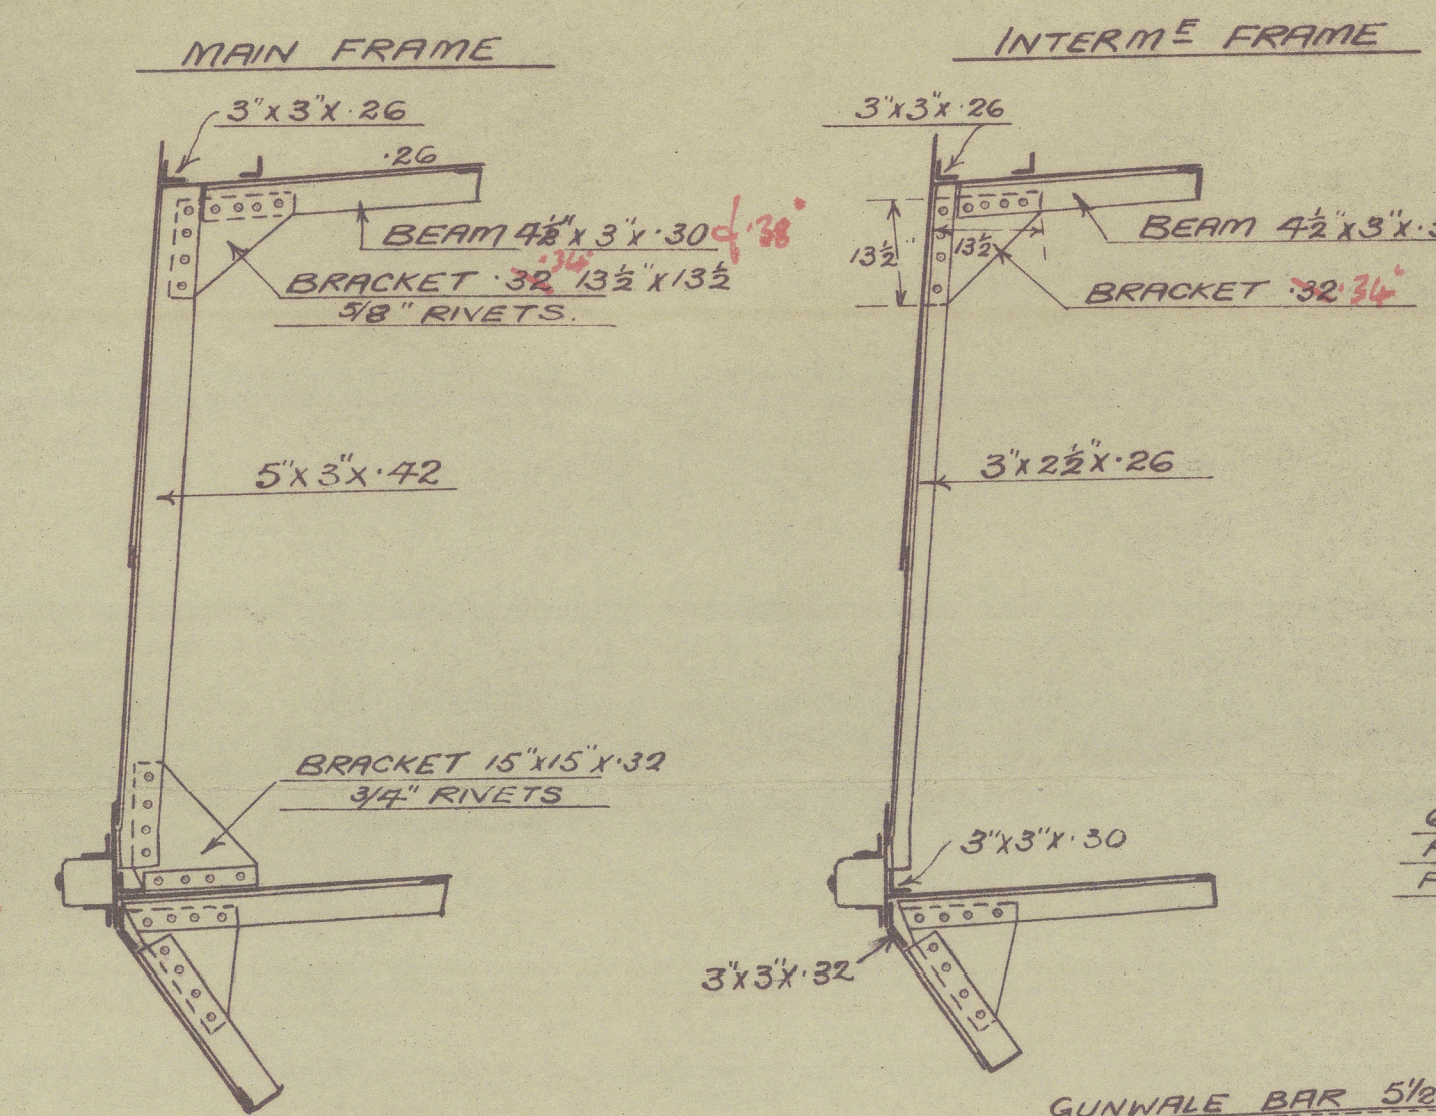


SECTION OF CANT FRAMING

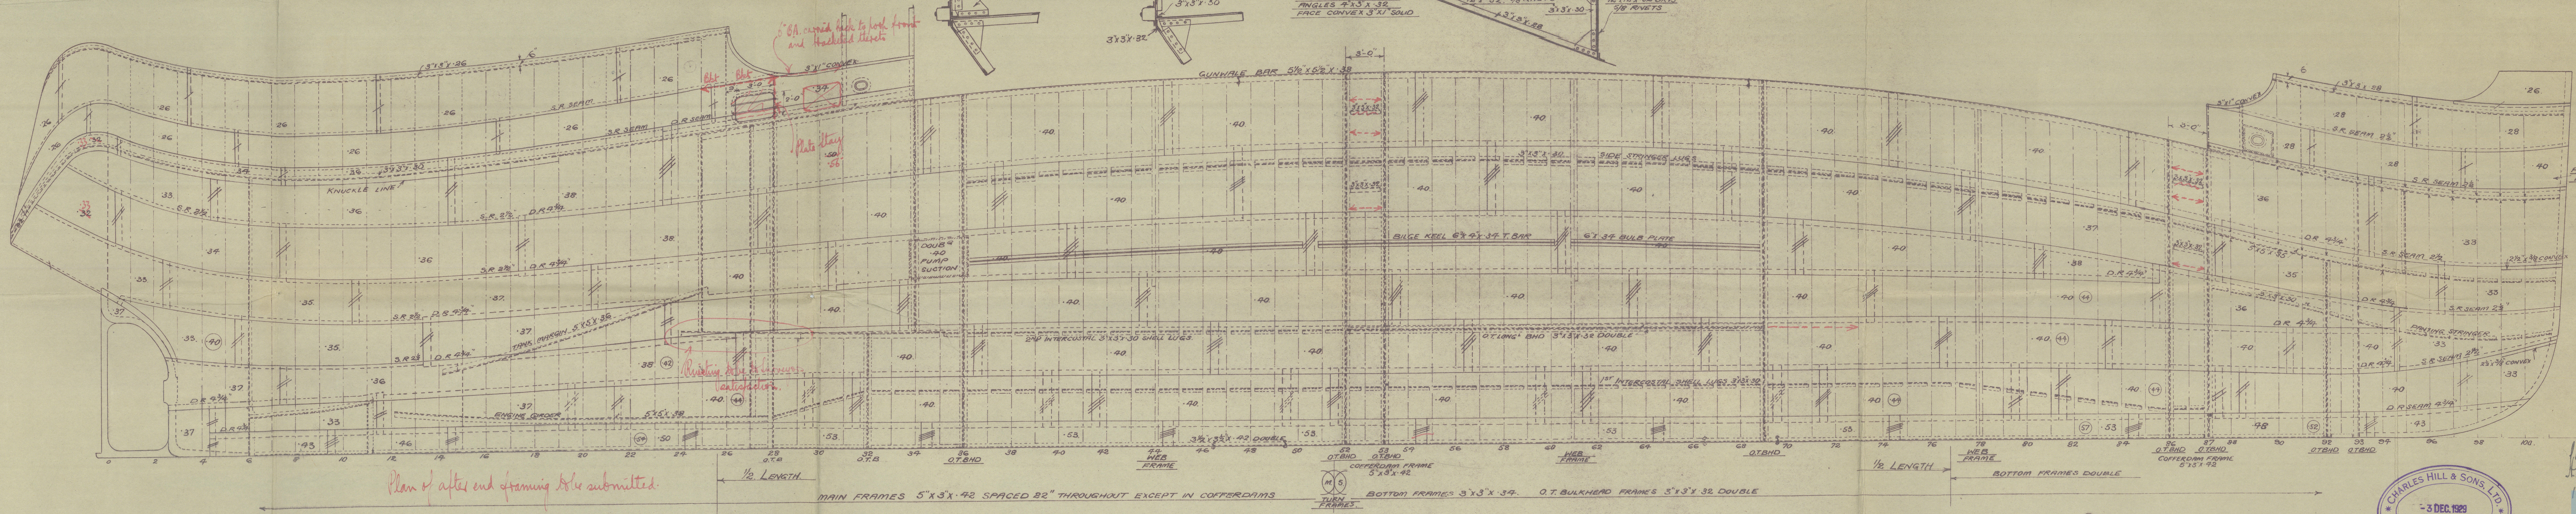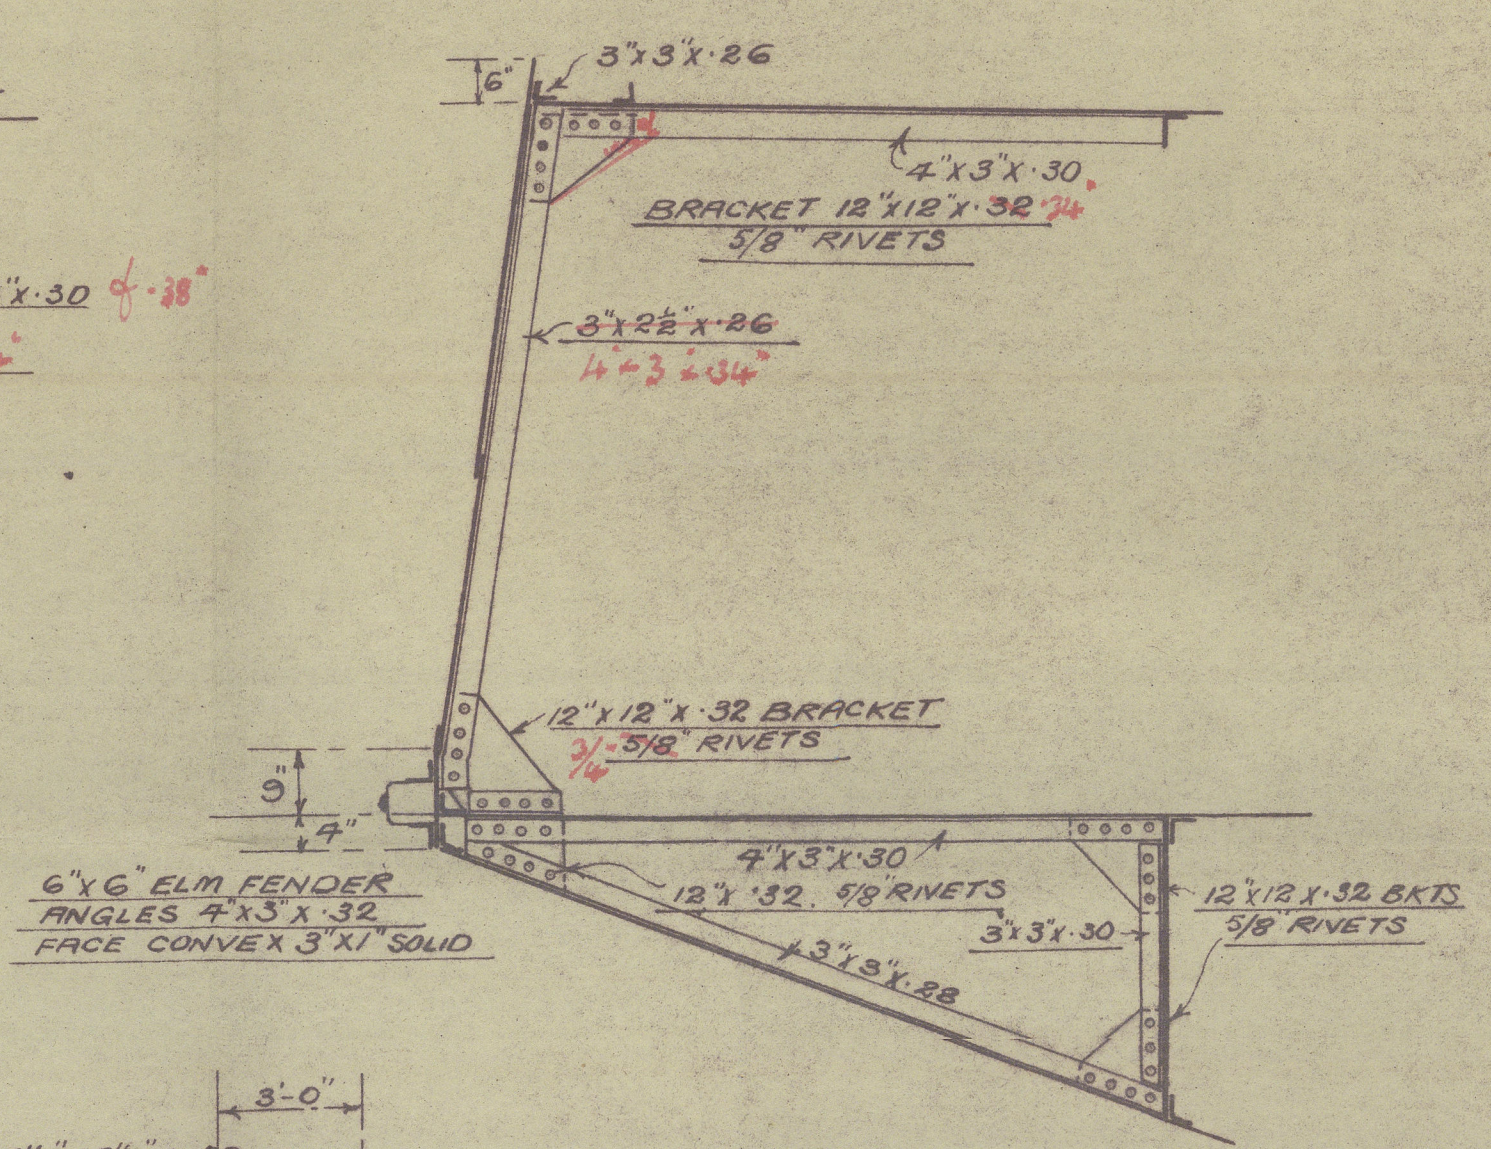

Plan of after end framing to be submitted.

MAIN FRAMES 5"x3"x42 SPACED 22" THROUGHOUT EXCEPT IN COFFERDAMS
BOTTOM FRAMES 3"x3"x34. O.T. BULKHEAD FRAMES 3"x3"x32 DOUBLE

INCLUDING 04 OWNERS EXTRAS.

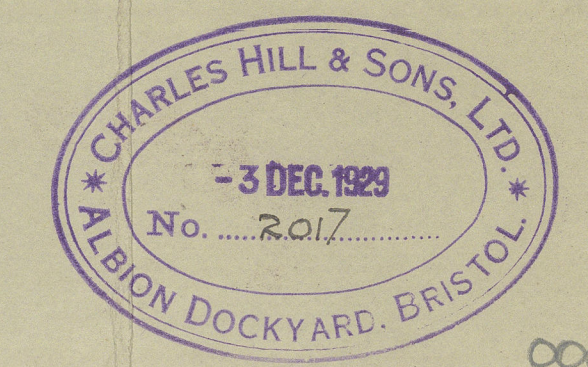

CHAS. HILL & SONS LTD.

Nº 179.

Shell Expansion.



© 2020

Lloyd's Register
Foundation

006819-

006830-

0059