

## MATERIALES


MAIN PIECE  
RUDDER STOCK & PINTLES --- FORGED STEEL  
ARMS --- CAST STEEL

SCALE 1/2, I.IN. TO ONE FT.

(H17)


COUPLING & GUDGEON "A"

GUDGEON "E"

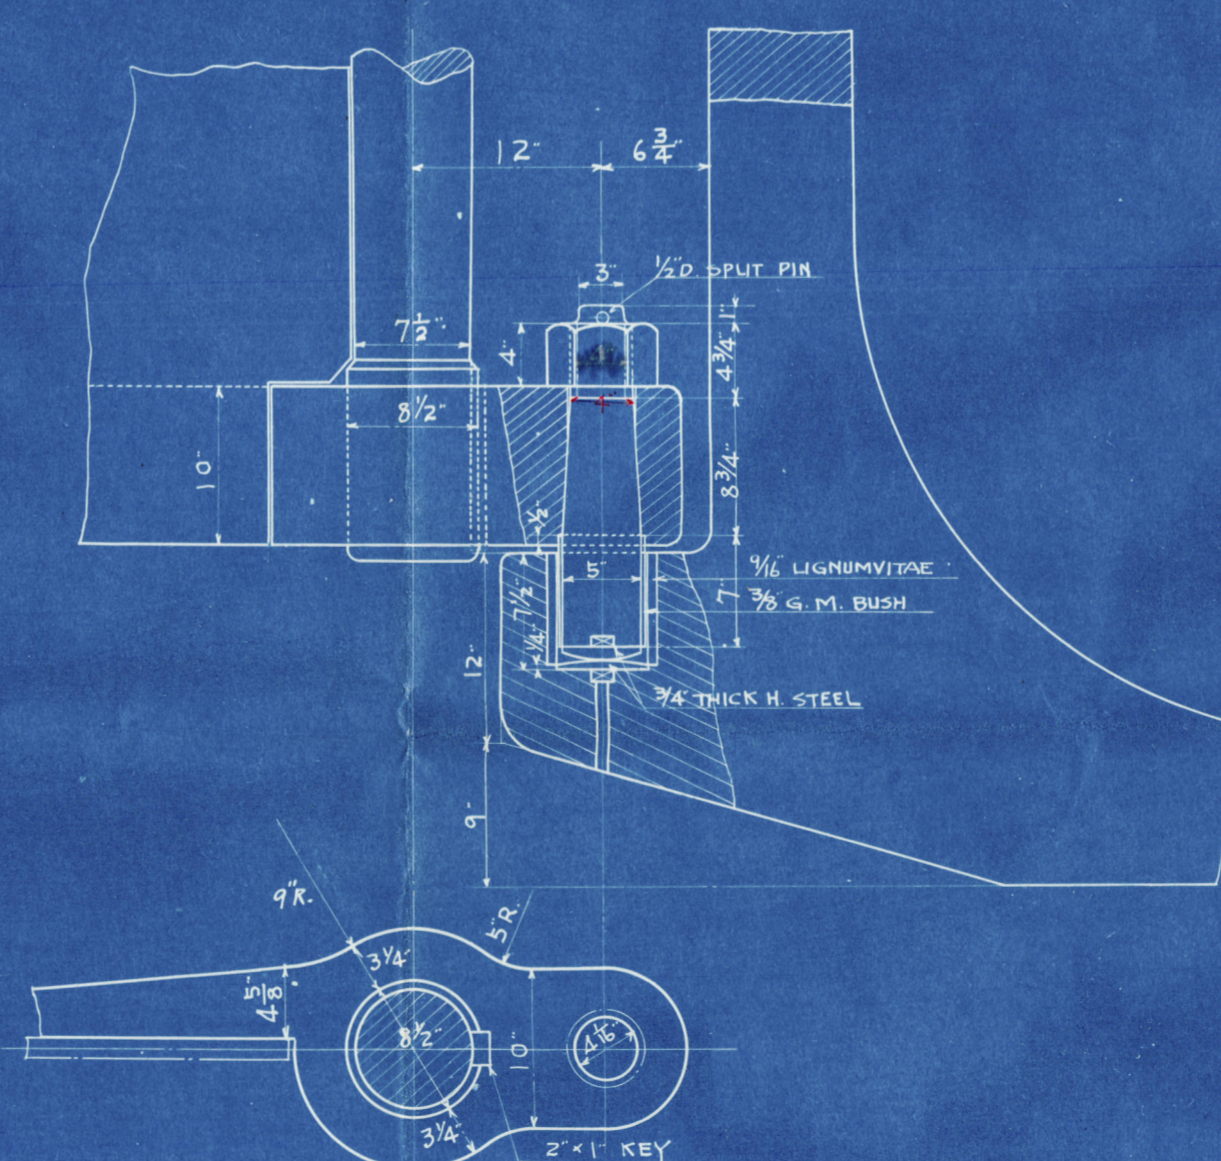

GUDGEON "B"


GUDGEON "C" "D"

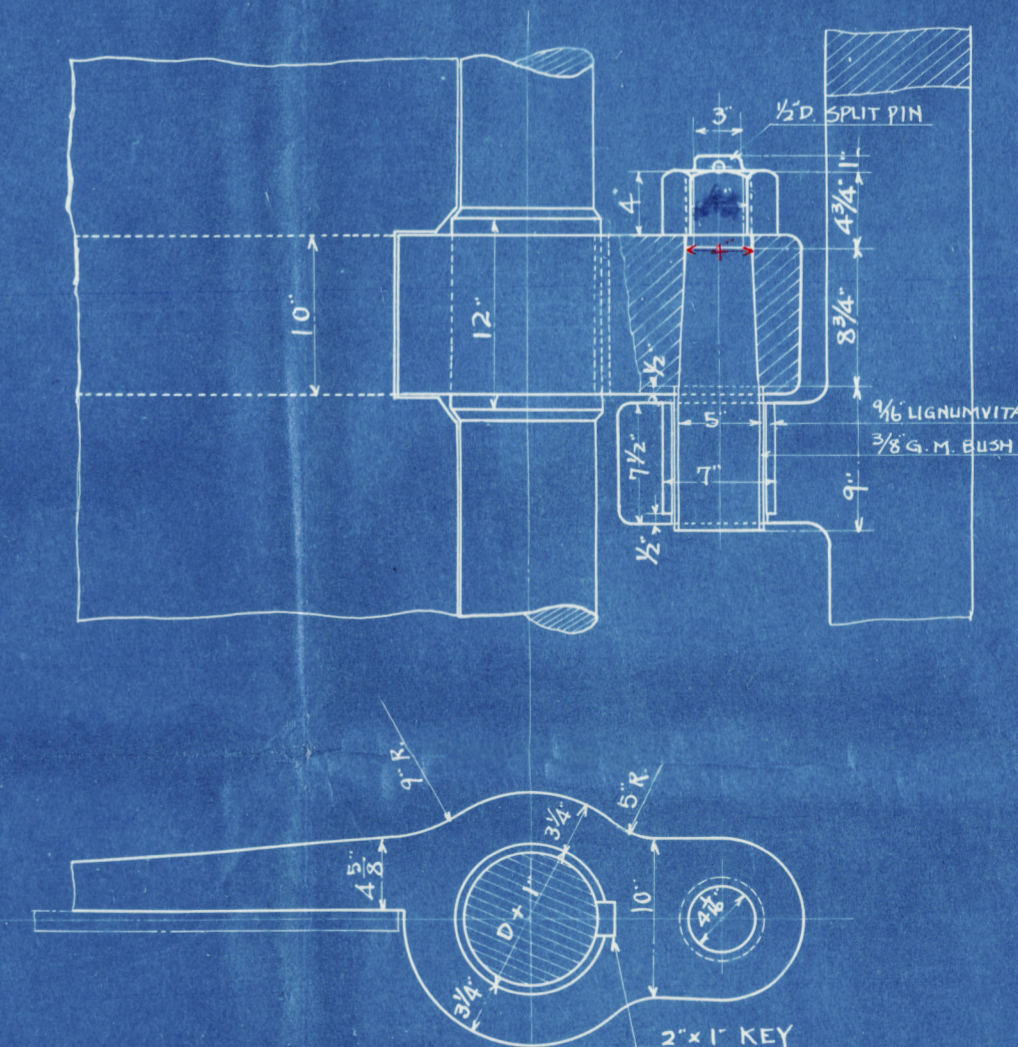

ロイド及海事協會，証明ヲ要ス



*Handwritten signature: J. P. Cox*

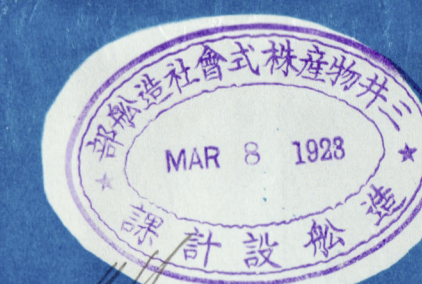

7-13


hunder

Lutini Bussan N 264

Rudner

Gen Box #265

"Akibasan Maru"  
Kbe 4656

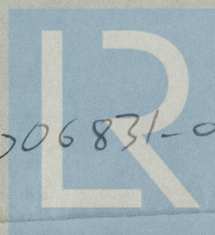

© 2020

006831-006844-0019

Lloyd's Register  
Foundation