



6.9.00
19.9.00
76.9.00
5.10.00

 

Profile.
S.S. No 158.
Scale 1/4" = 1 ft.
Dimensions 210' 30 1/4" x 15' 6" Mld.
Class 100 A1

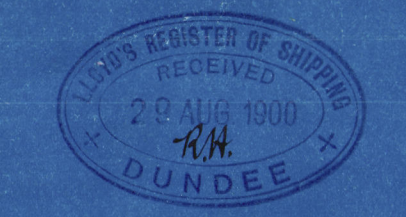

J.P.
6.9.00

006571-006572-0229

Profile plan
Caledon S.B. Yong Co. Ld.
No 158



S. S. "Finana"

Dundee Rpt No 6722



n/n.

"Zoo Shin"

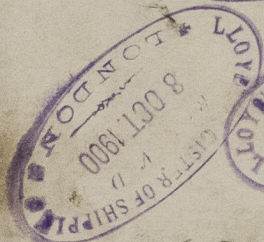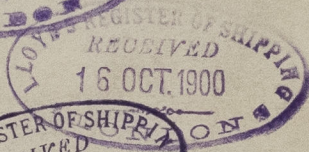

006821-006844-0229



© 2020

Lloyd's Register
Foundation