


N^{o.} 533 a 4

PLAN No. 2063
FOR ENCLOSURE TO
Messrs. Lloyd's Surveyors
Hull FROM
COCHRANE & SONS,
SHIPBUILDERS, SELBY.
DATE 9/10/12 RH

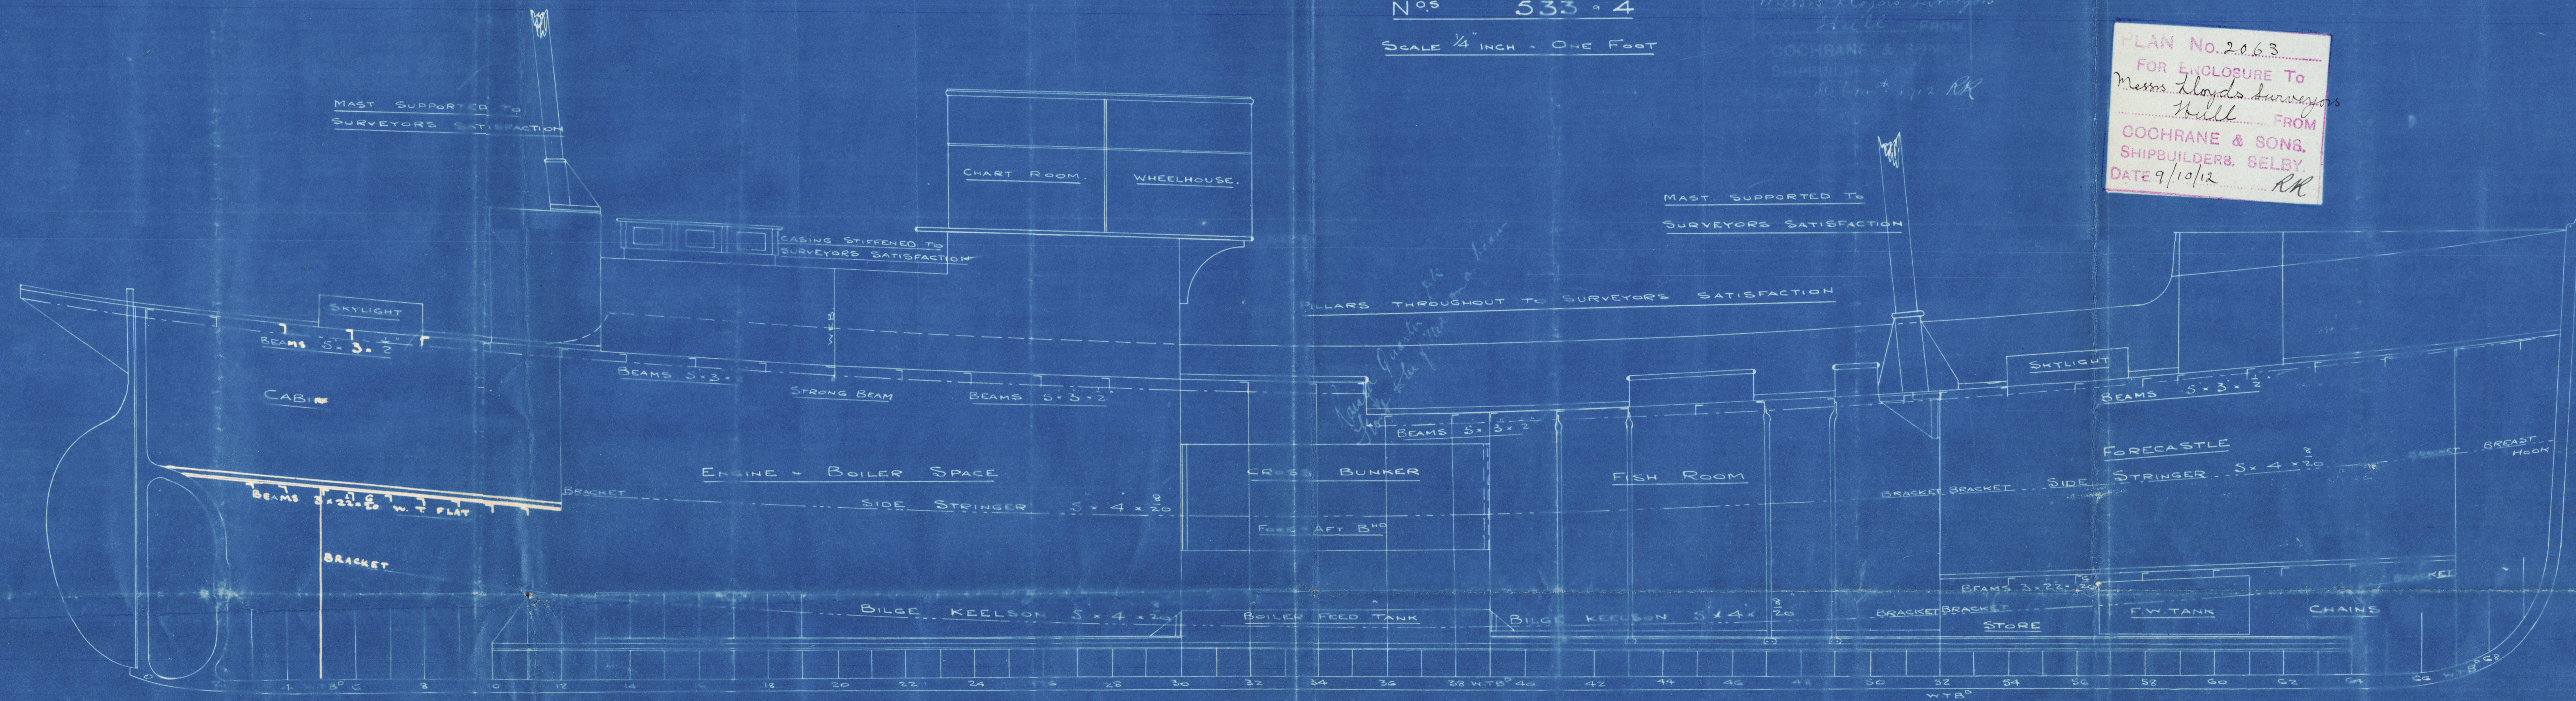

about
15-2-12

Cochrane & Pons

Nos 533 and 534.

Duplicate
Profile and Deck Plan.

for

~~533~~ ~~534~~ ~~535~~ 