

2.4.12

Duplicate

Nos 533 - 34

SKETCH SHEWING ALTERNATIVE CENTRE KEELSON

PLAN No 2064
FOR ENCLOSURE TO
Messrs Lloyds Surveyors
Hull FROM
COCHRANE & SONS,
SHIPBUILDERS, SELBY.
DATE 9/10/12. RK


Messrs Lloyds Surveyors
Hull

20/2/12. RK

*overhaul of Centre Keelson
to be done
No 233-4.
Cochrane & Sons*

2 BULB ANGLES


7" x 3" x 7/16
4" x 3" x 1/2"

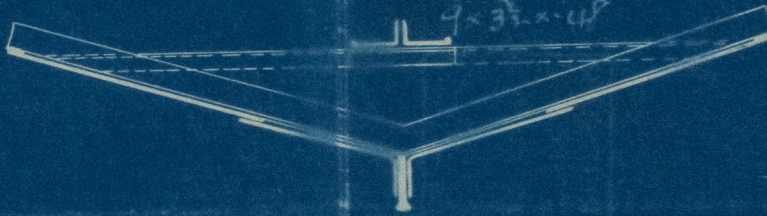

ALTERNATIVE KEELSON.

7 1/2" x 7/16 BP

4" x 3" ANGLES

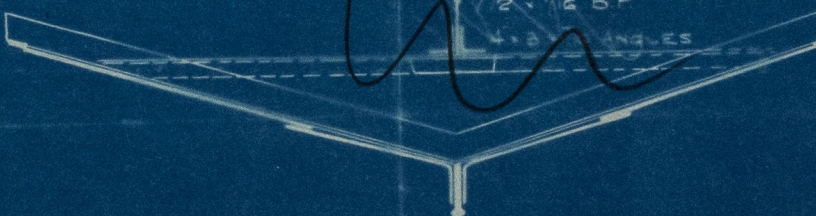

KEELSON AS APPROVED.



Lloyd's Register
Foundation