


W. SIMONS & CO., LTD
LONDON WORKS,
RENFREW. 13-9-01


19-9-01

SEEL TWIN SCREW
SAND PUMP HOPPER DREDGER N°395
TO CLASS A.1. STEEL DREDGER.
SCALE 1/8 INCH = 1 FOOT.

Dimensions
Length as per Rule 215-0'
Breadth Moulded 36-5'
Depth as per Rule 16-37'

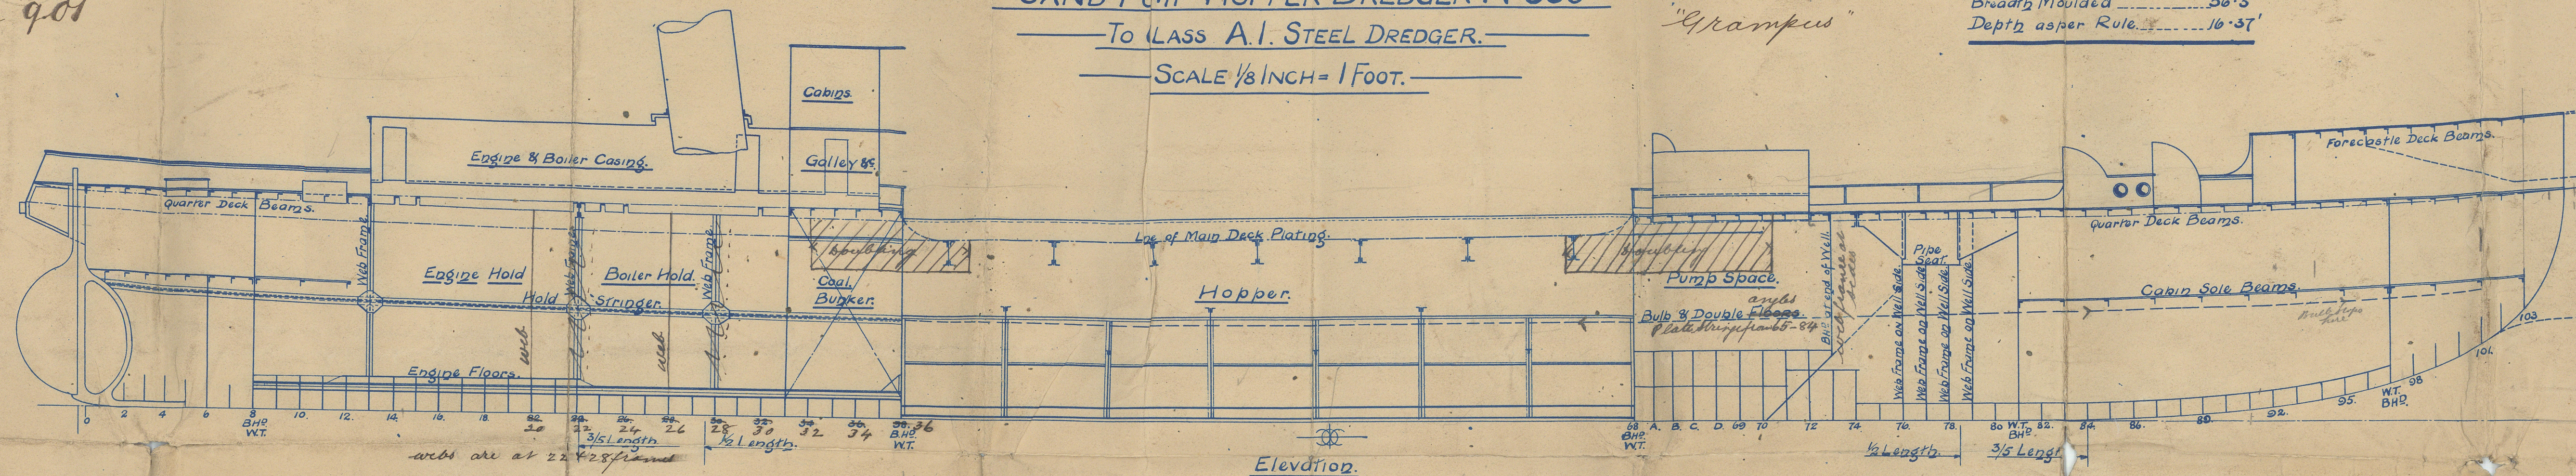

Elevation.

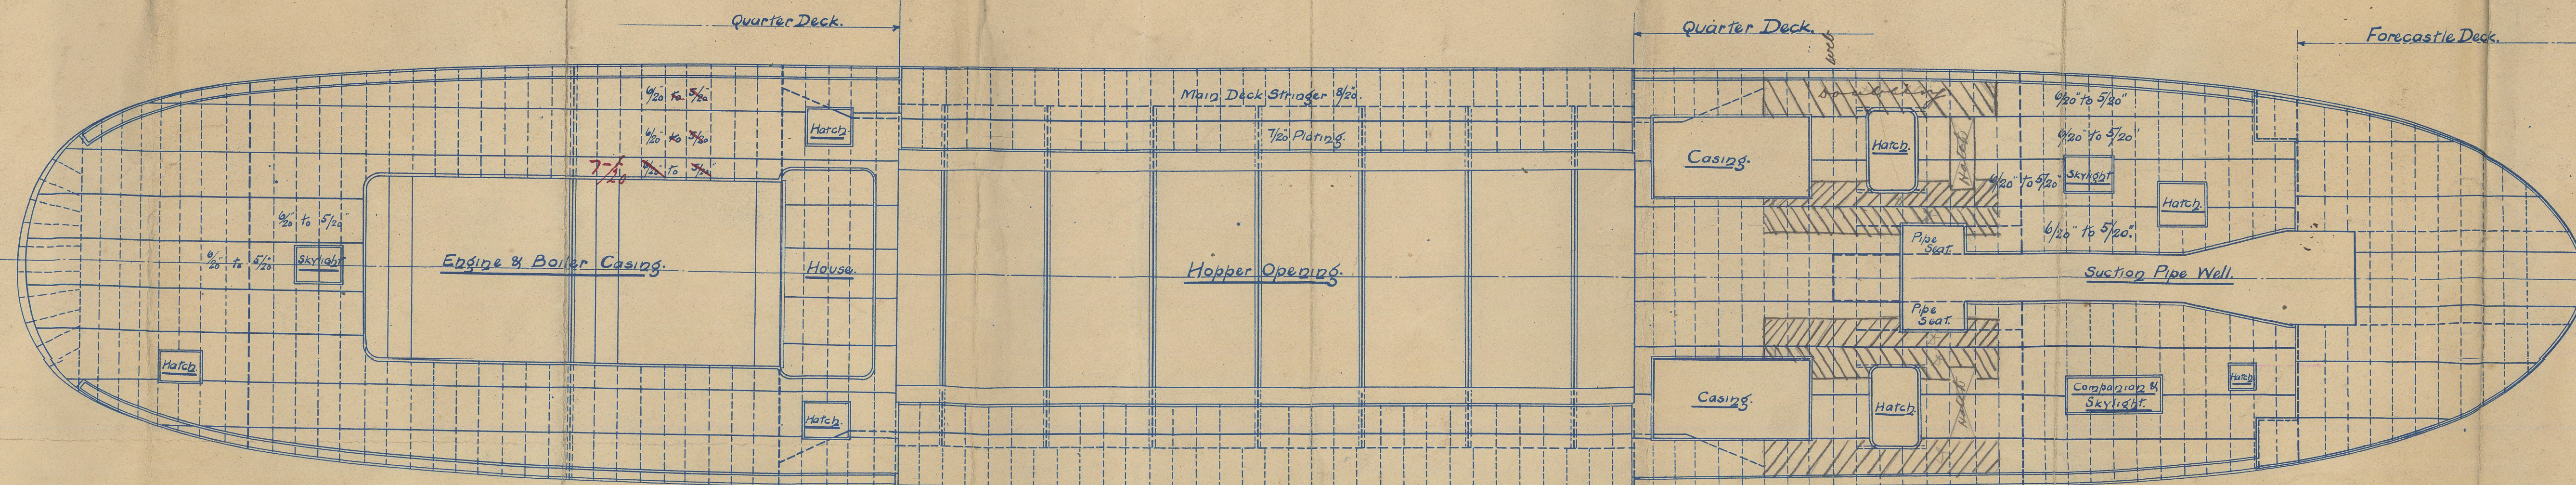




Plan.

006868 - 006876 - 0140

W. Dimmons & Co.

Nº 395


Profile & Deck Plan.

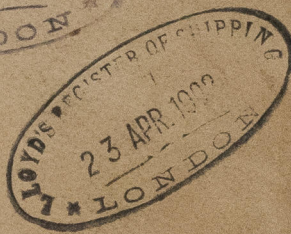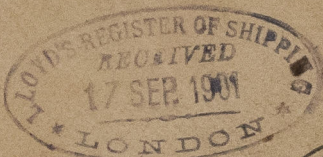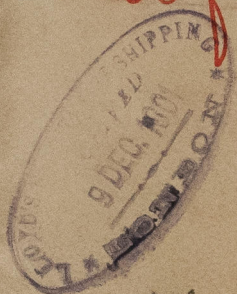

MISENO

EX

5/5 Grampus
Ls up to 20017

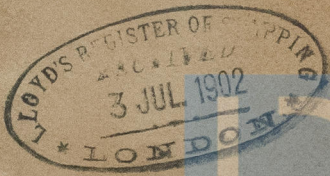

1647.

006868 - 006876 - 0140

Lloyd's Register
Foundation

0140

Celeland
Grampian



© 2021

Lloyd's Register
Foundation