

11.11.36

No. 242.

PROFILE & DECK PLAN for position of Hatches, W.T. BHD & mast. see also General Arrangement Plan.


Scale: 1/4" = 1 Foot

To Class Lloyd's A.1 for 'Service in Gulf of Guinea'

Min. Dimensions: 125'0" x 24'0" x 9'0" 1/2"

Forecastle D¹ sides 3/16
Beams 3 1/2 x 1/2 x 1/4 on Every Frame
Stanchion 1 1/2 x 3/16 Ties 1 1/2 x 3/16 Under W/L 1/4 x 3/4
W/L D¹ 2 1/4 Ties

W/L 1/4 supported to Surveyor satisfaction

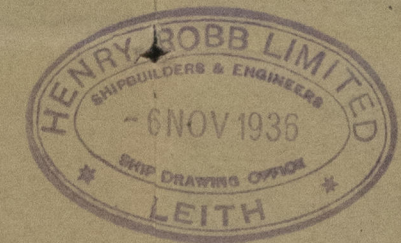


Frame No. 26

Position of Hatch as built

No. 36

Frame No. 43

Position of Hatch as built No. 49

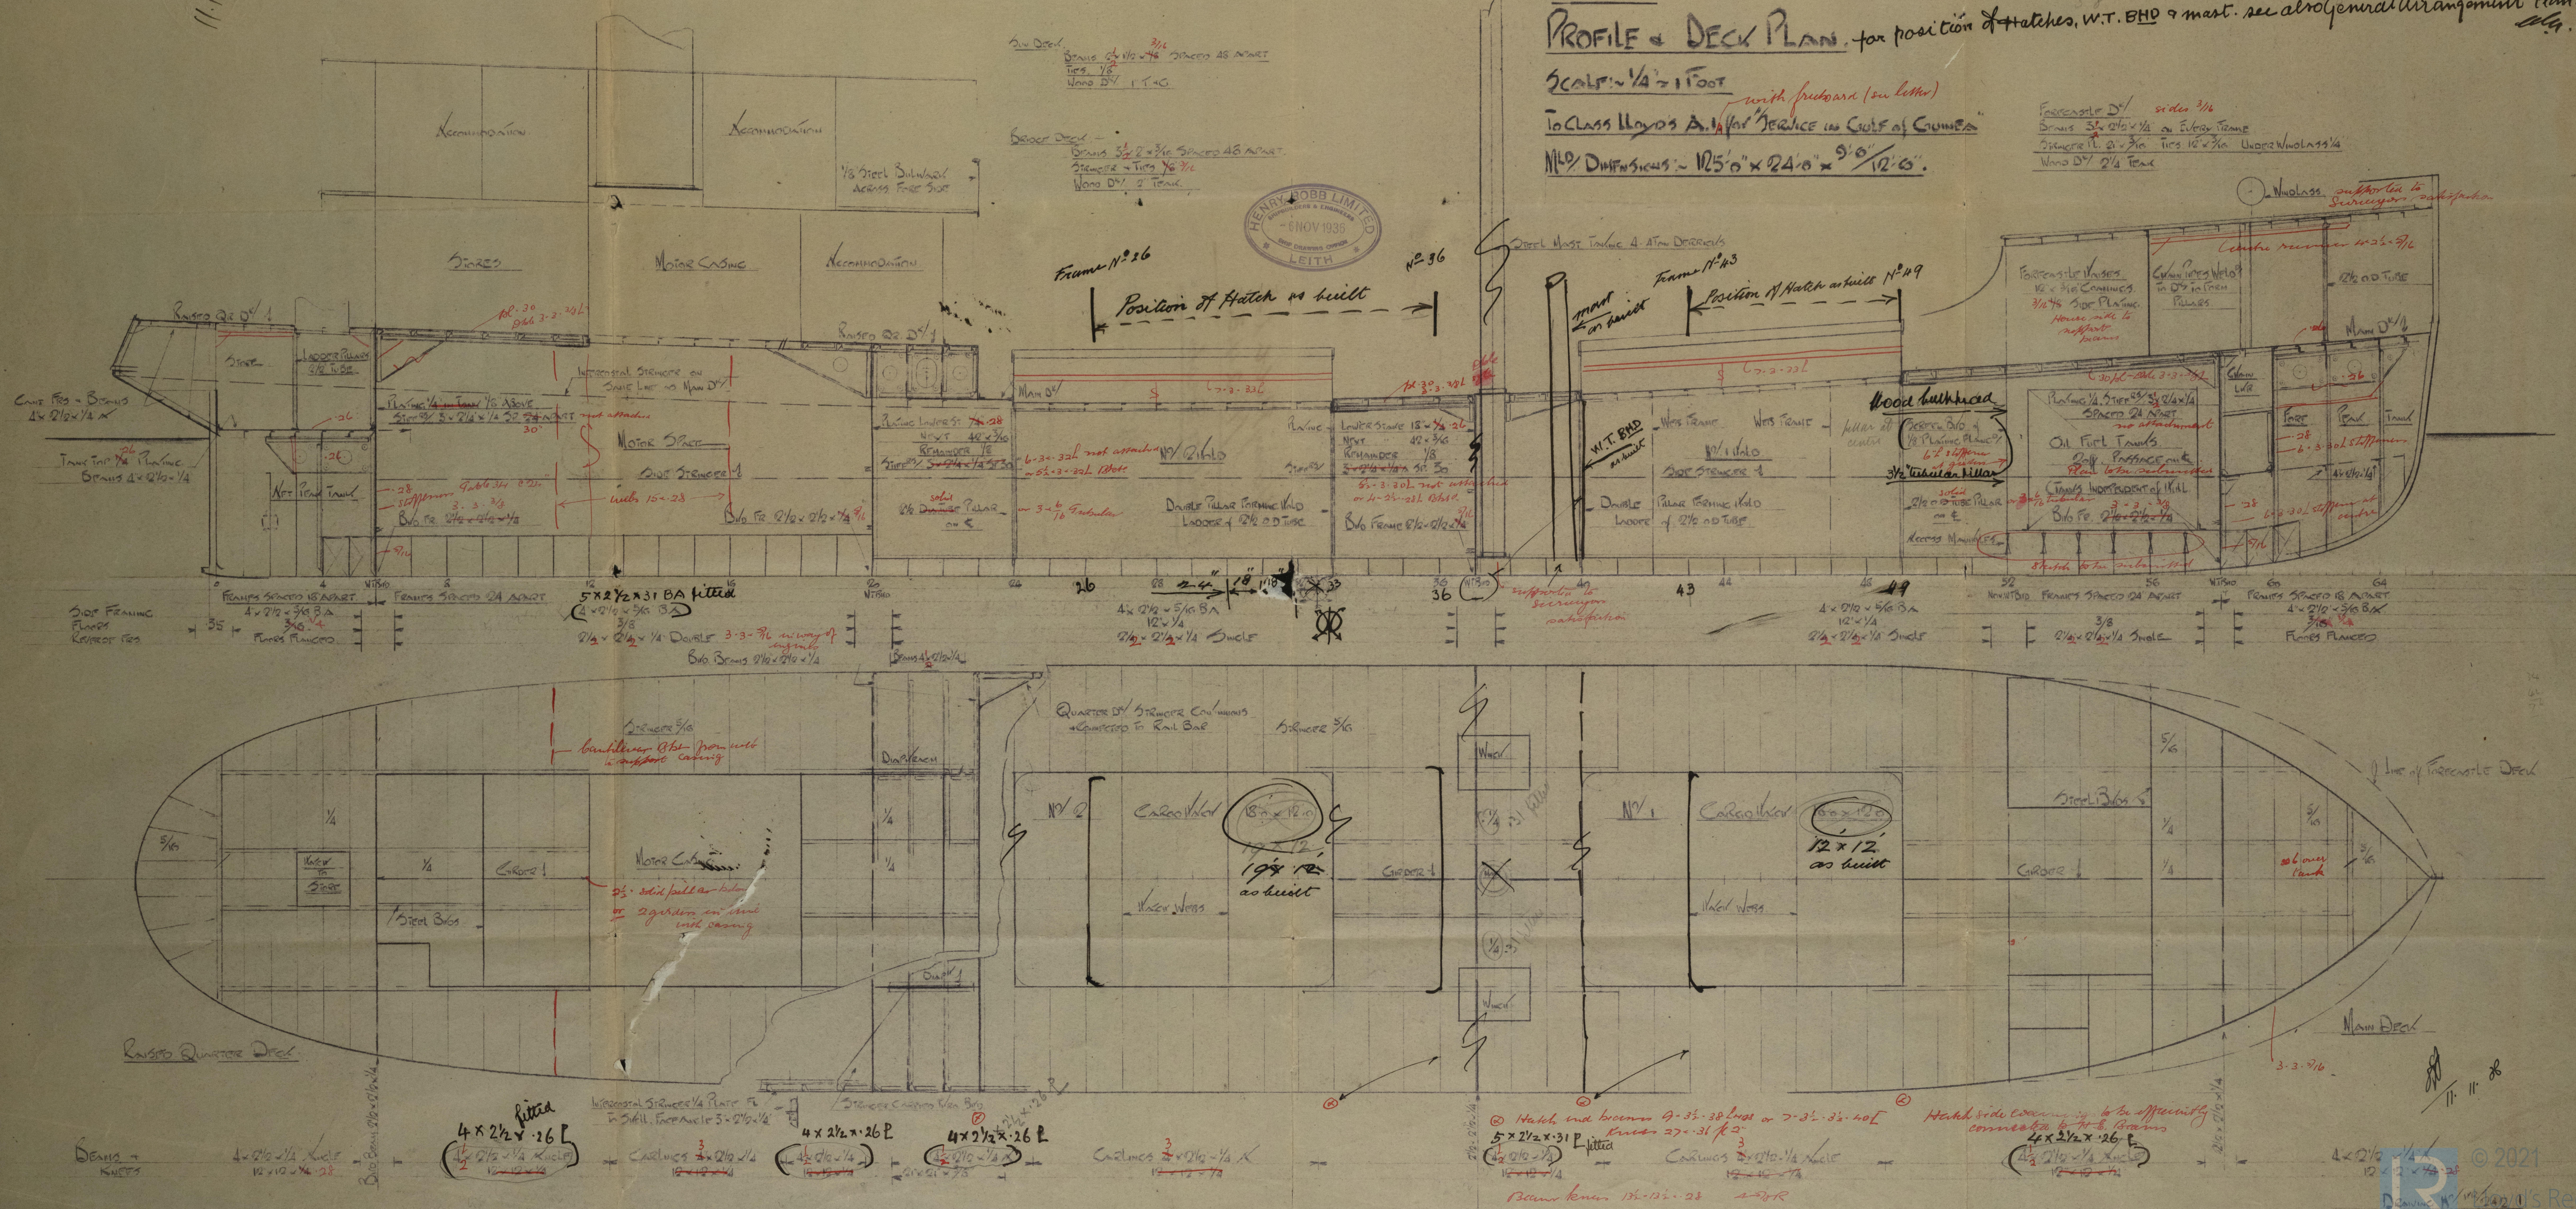

© 2021

Register Foundation

Henry Robt L^d
N^o 242

Profile & Deck

Leith RMT N^o 19587

M.V. "AA COWAN"



© 2021

Lloyd's Register
Foundation

5410-888908-0175