


Nº 174.

# MIDSHIP BULKHEADS.


SCALE  $\frac{3}{4}'' = 1 \text{ FOOT}$

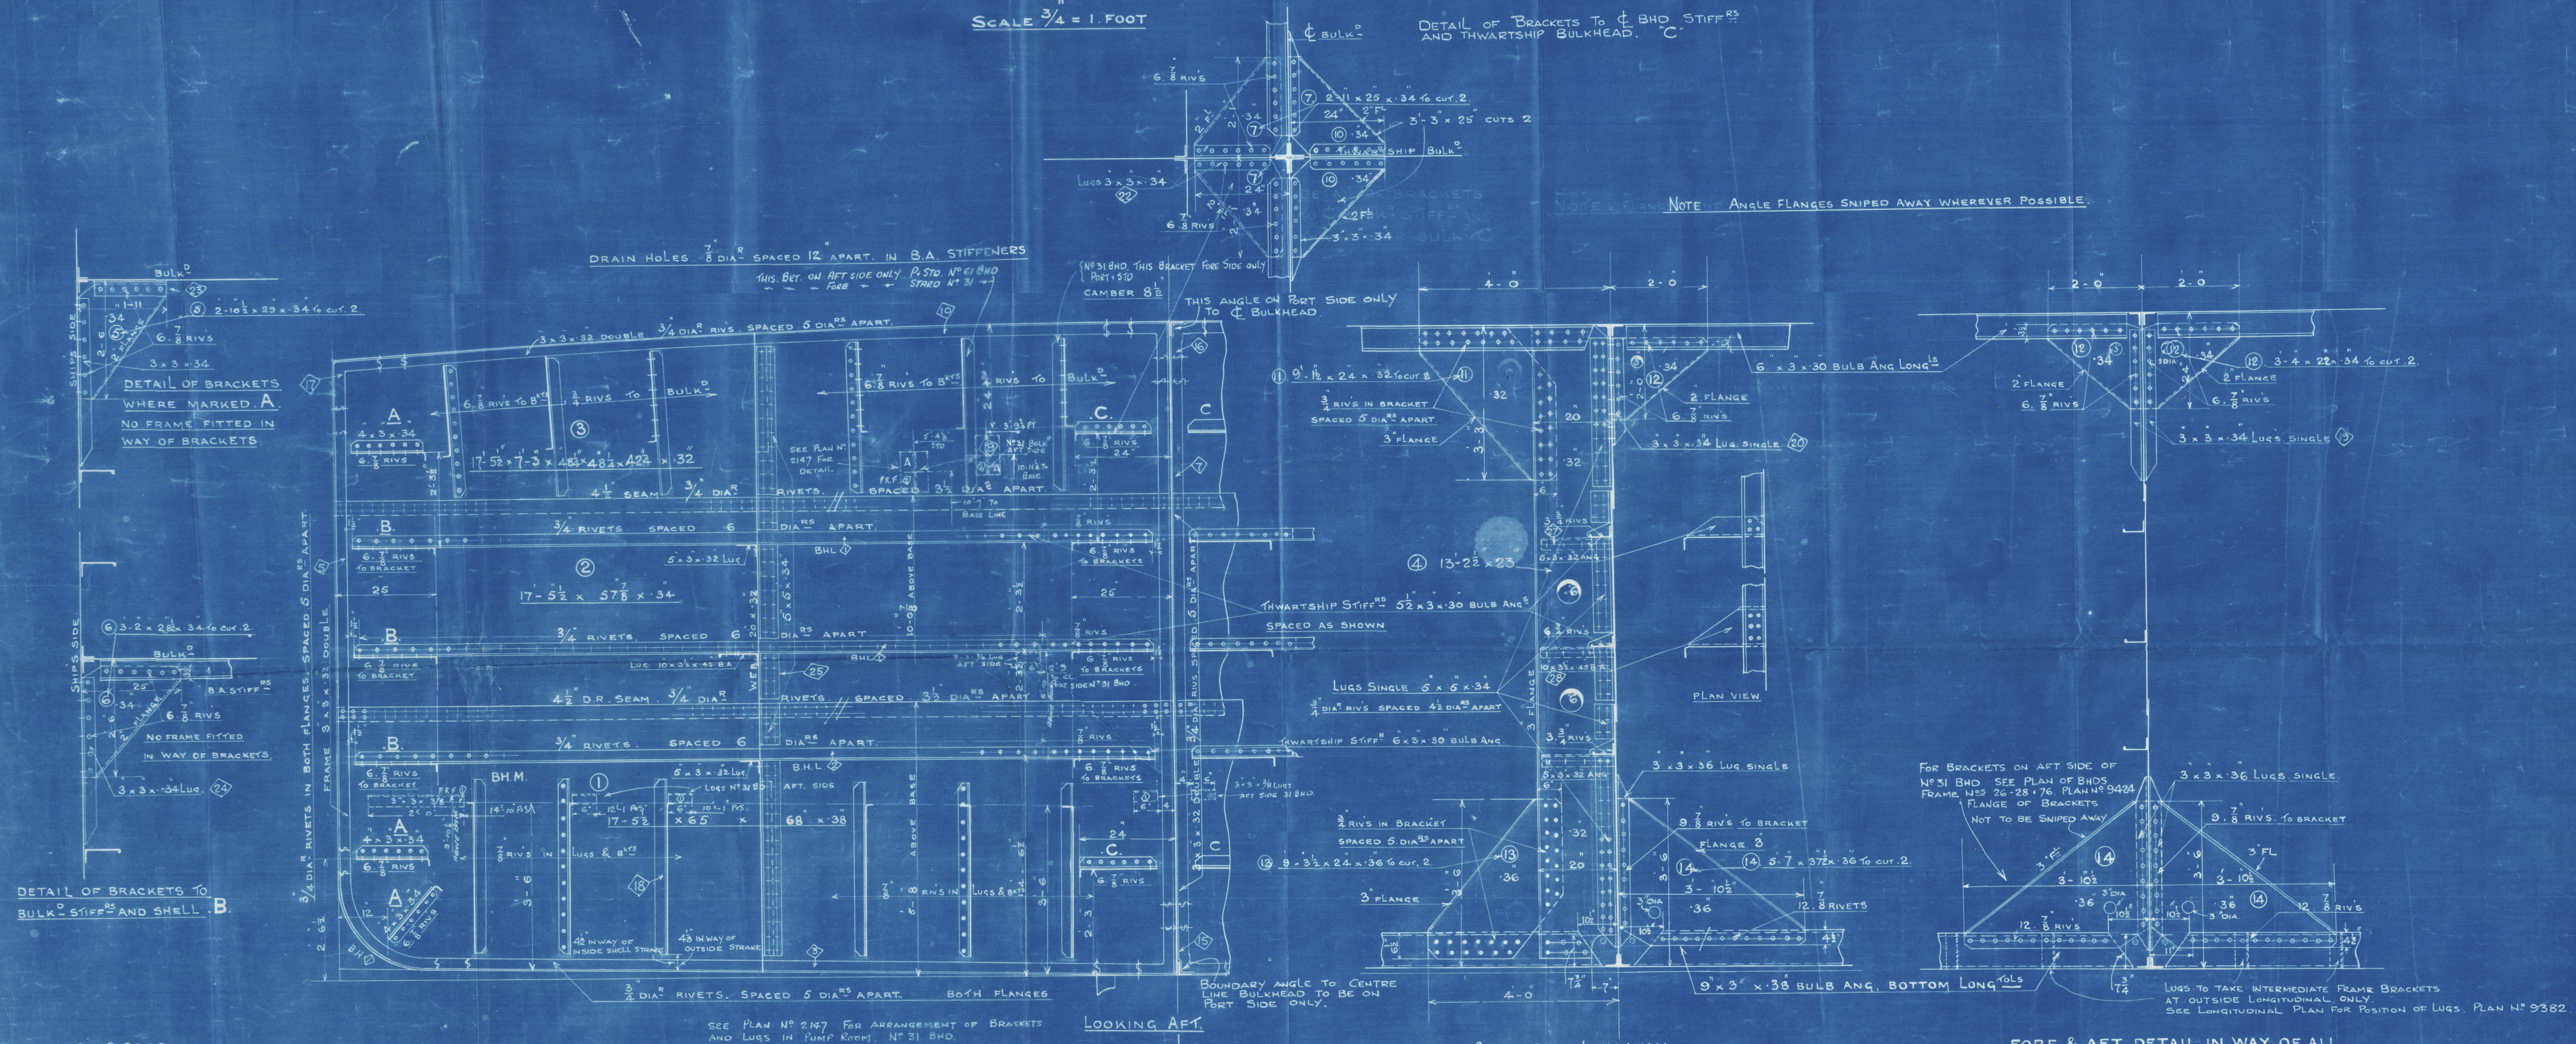


S. Nº 9368.

BULKHEAD FRAME Nº 61 LOOKING AFT

Nº 46	FWD.
Nº 31	AFT

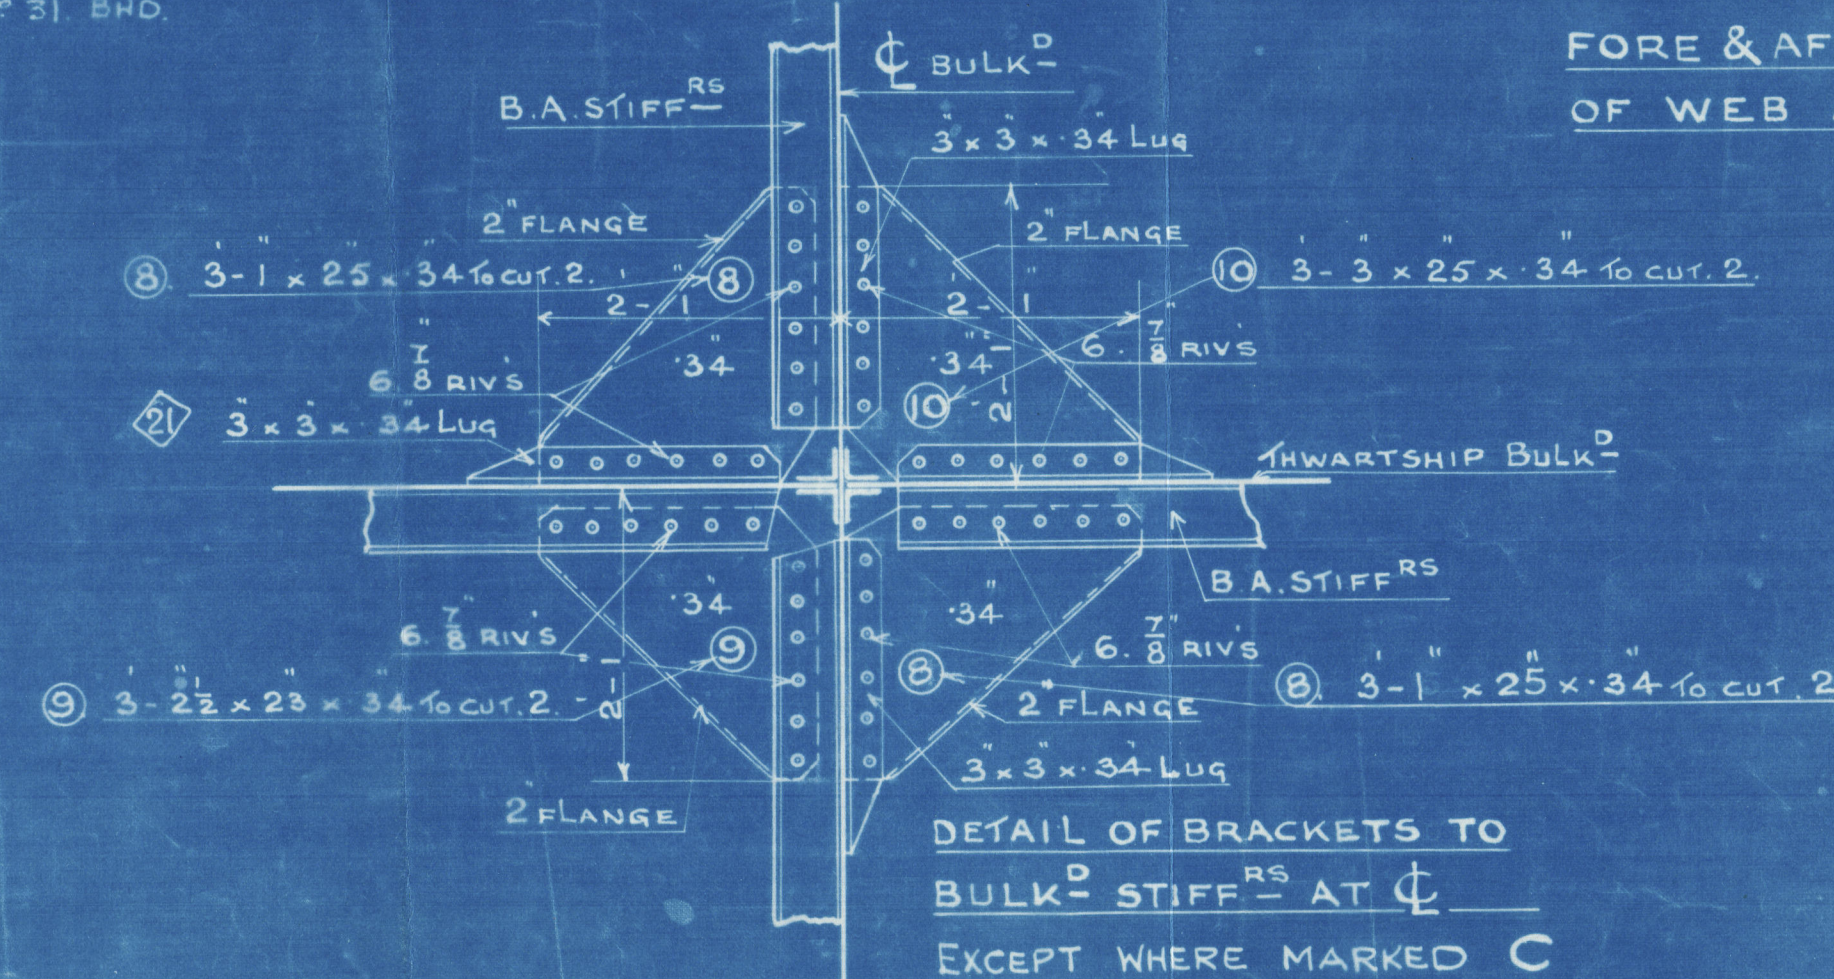

MARK	Nº	LENGTH	SIZE	THICK	REMARKS
BH	1	5'	17' 0"	3 x 3	BILGENT 28.26.31.46.61
"	3	10	28' 0"	"	BTM Nº 26.28.31.46.61
"	5	10	18' 9"	"	SIDE Nº 26.28.31.46.61
"	7	9	23' 3"	"	CENTRE Nº 26.28.31.46.61
"	8	1	10' 6"	"	AFT SIDE Nº 26 BHD
"	10	8	30' 9"	"	DECK Nº 28.31.46.61
"	11	3	31' 8"	"	FORE SIDE Nº 26
"	12	1	33' 3"	"	AFT " Nº 26
"	15	6	11' 0"	"	SHOES KEEL
"	16	4	11' 3"	"	CENTRE, DECK
"	17	4	16' 6"	"	SIDE
"	18	36	14' 10"	3 x 3	BKTS BOTTOM
"	19	24	18' 3"	"	34' 1"
"	20	1	11' 3"	"	WEBS
"	21	11	11' 6"	"	AT $\phi$ D
"	22	8	14' 3"	"	DECK
"	23	4	14' 8"	3 x 3	SIDE A
"	24	12	14' 8"	3 x 3	SIDE B
"	25	10	25' 0"	5 x 5	VERTICAL BAR TO WEBS
"	26	1	12' 6"	10 x 33	STIFF TO WEBS
"	28	1	16' 3 1/4"	5 x 3	45' BA
BILL	2	10	16' 3 1/4"	6 x 3	50 BA STIFFENERS

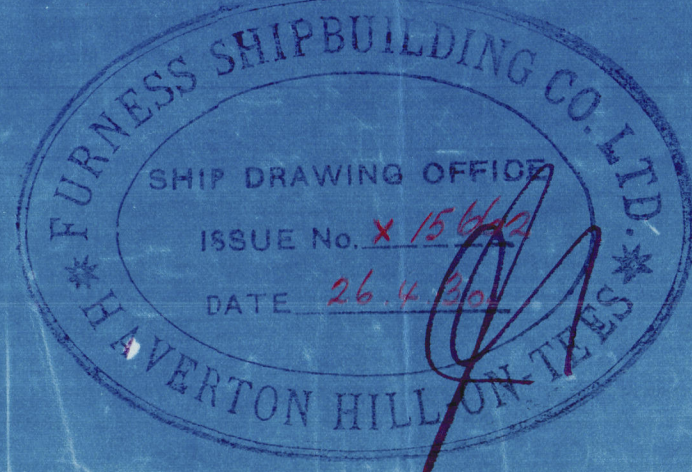



MESS<sup>RS</sup> FURNESS S.B. CO.

Nº 174

MIDSHIP BULKHEADS AS BUILT.

S.S. Rideaulite  
M.D.B. RPT. No. 14075.



© 2021

Lloyd's Register  
Foundation

006877-006888-0205