


RIVETING

BUTTS OF SHELL PLATING TO BE LAPPED AND
DOUBLE RIVETED EXCEPT GARBOARD AND SHEERSTRAKE
WHICH ARE TO BE STRAPPED AND DOUBLE RIVETED
ALL LANDINGS DOUBLE RIVETED
BULWARK SINGLE RIVETED

To class \star 100 A.I. STEAM TRAWLER.

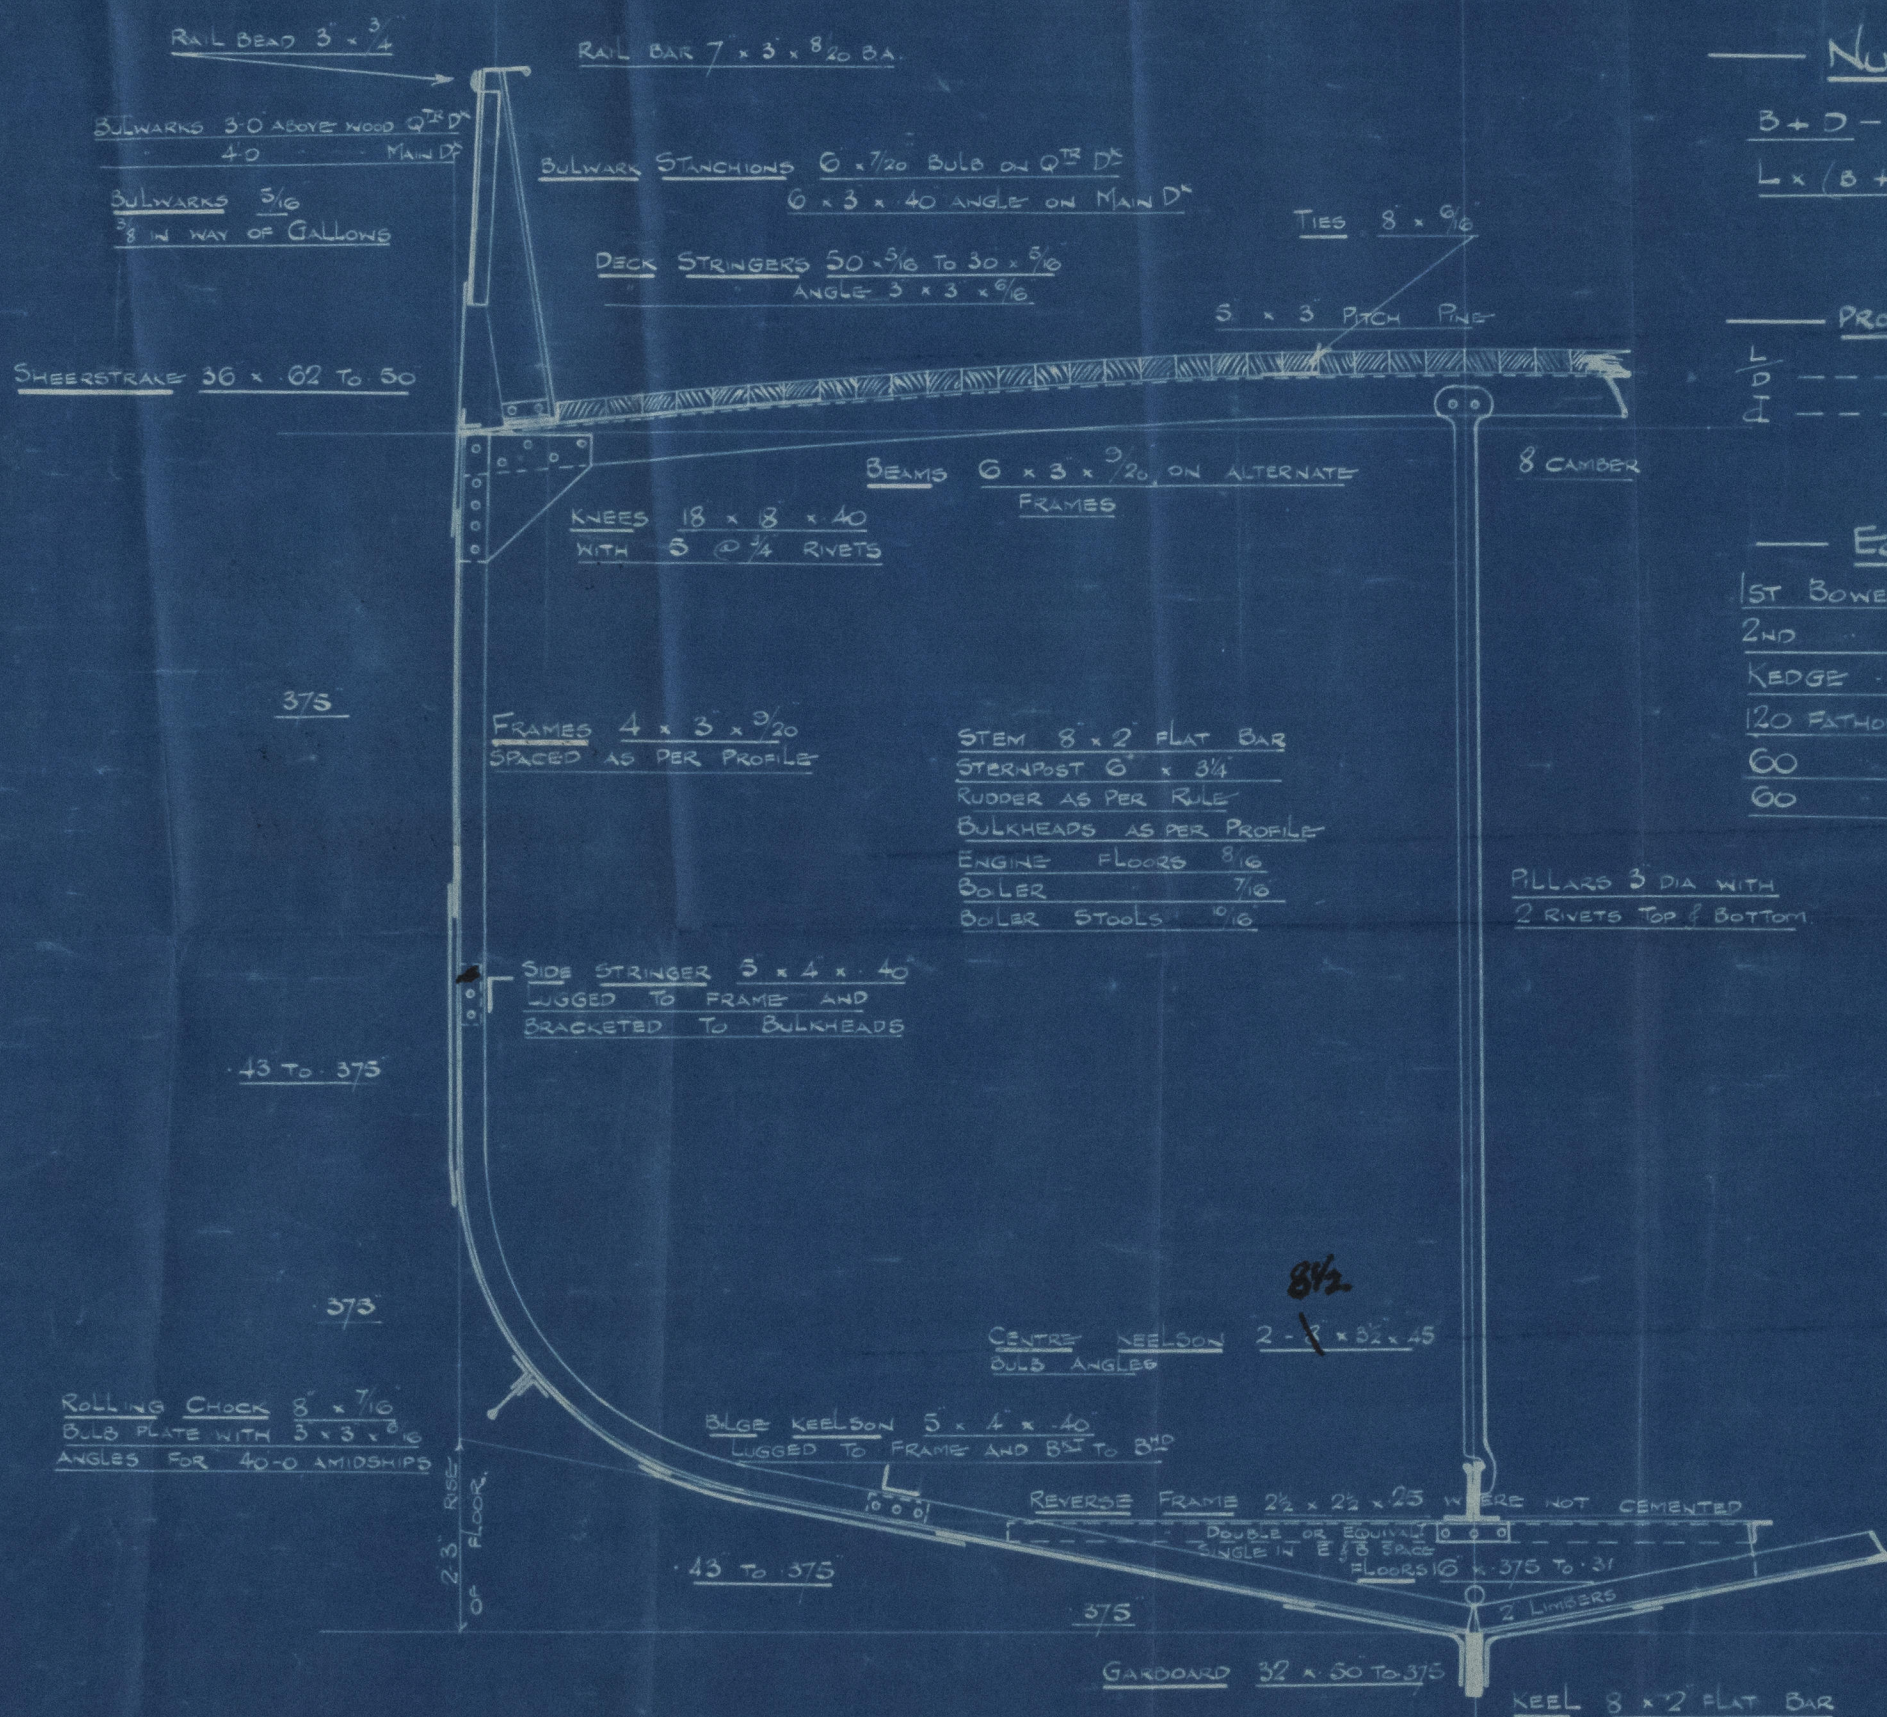

NUMERALS

B + D ----- 37.87

L x (B + D) --- 5300.87

PROPORTIONS

$\frac{L}{D}$ ----- 10.00
 $\frac{L}{B}$ ----- 12.67

EQUIPMENT

1ST BOWER ANCHOR	8 1/2 CWTs	STOCKLESS
2ND	7 1/2	
KEDGE	3 1/4	EX STOCK
120 FATHOMS	1 1/2	STUD LINK CABLE
60	6	HAWSER
60	5	WARD

S.S. DAIRYCOATS MIDSHIP SECTION

No 988

STEEL SCREW TRAWLER
DIMNS :- 140'-0" BP x 23'-10 1/2" MLD x 14'-0" MLD
1/2" SCALE.

PLAN No. 4756

FOR ENCLOSURE TO
Messrs The Surveyors
Lloyd's Hall FROM
COCHRANE & SONS, LTD.
SHIPBUILDERS, SELBY
DATE 12/1/20



Lloyd's Register
Foundation

006877-006888-0256

S/T DAIRYCOATES
Midship Section
As fitted
Hull Report 36401.

Messrs. The Surveyors
Hull



006877-006888-0256



© 2001

Lloyd's Register
Foundation