

STEEL SCREW TRAWLER

SCALE  $\frac{1}{4}" = 1 \text{ FOOT.}$

DIM<sup>S</sup>. — 140'-0" B.P. x 23'-0" Ex. x 13'-0" M.L.D.


# PILLARS TO SURVEYORS' SATISFACTION

PLAN No. 8711


FOR ENCLOSURE TO  
Lloyds Surveyors.  
Knull.

DATE 15/2/09. Hu

MOST SUPPORTED TO  
SURVEYORS SATISFACTION

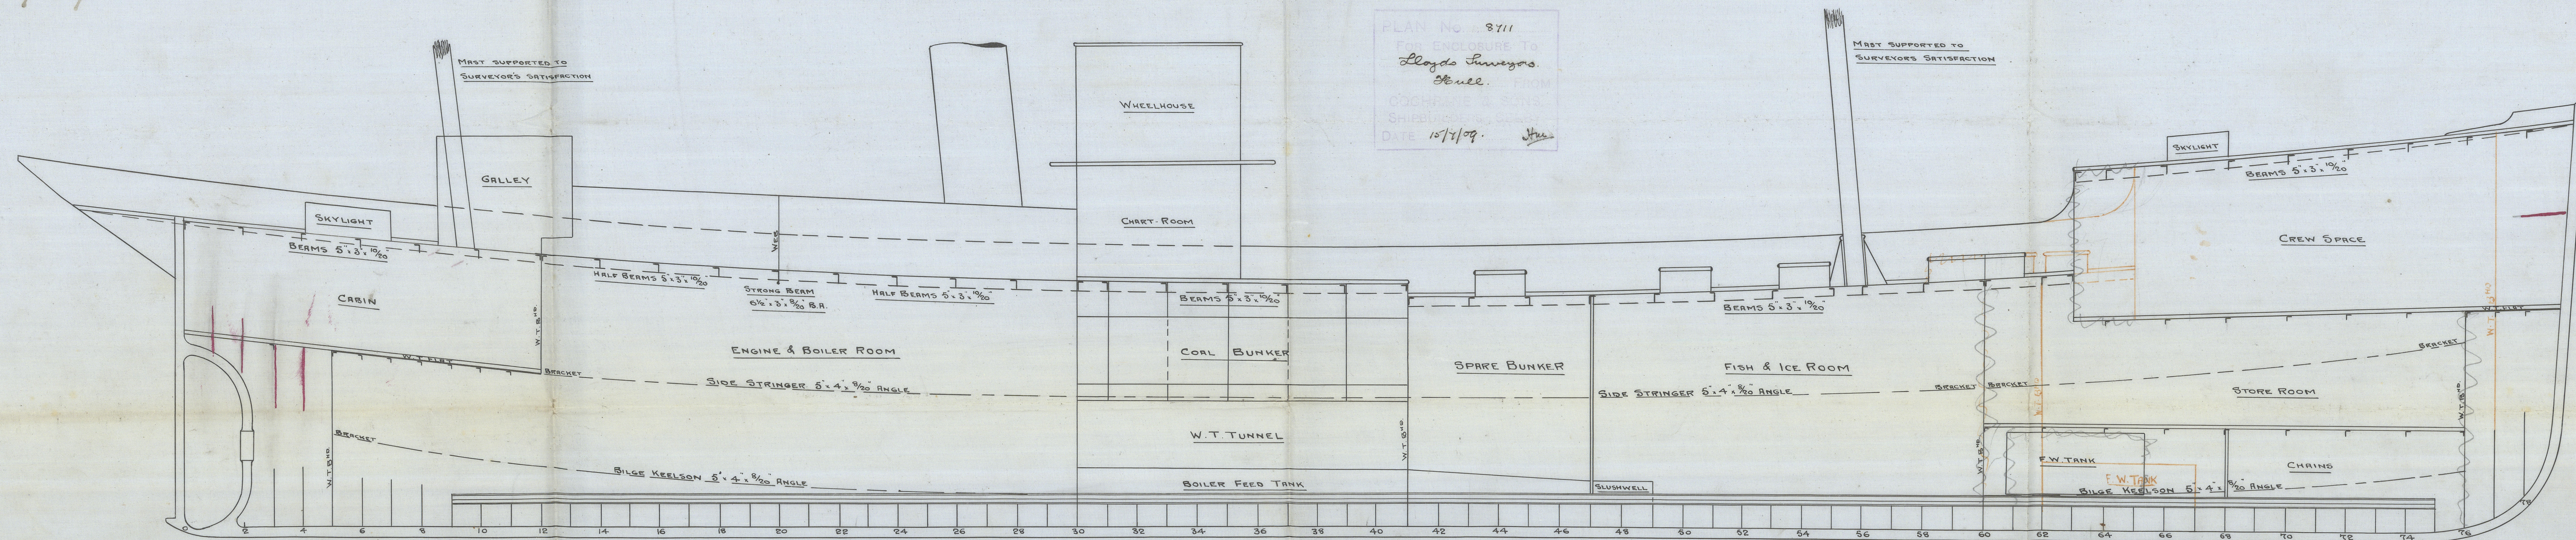

Pillars throughout to Surveys's satisfaction

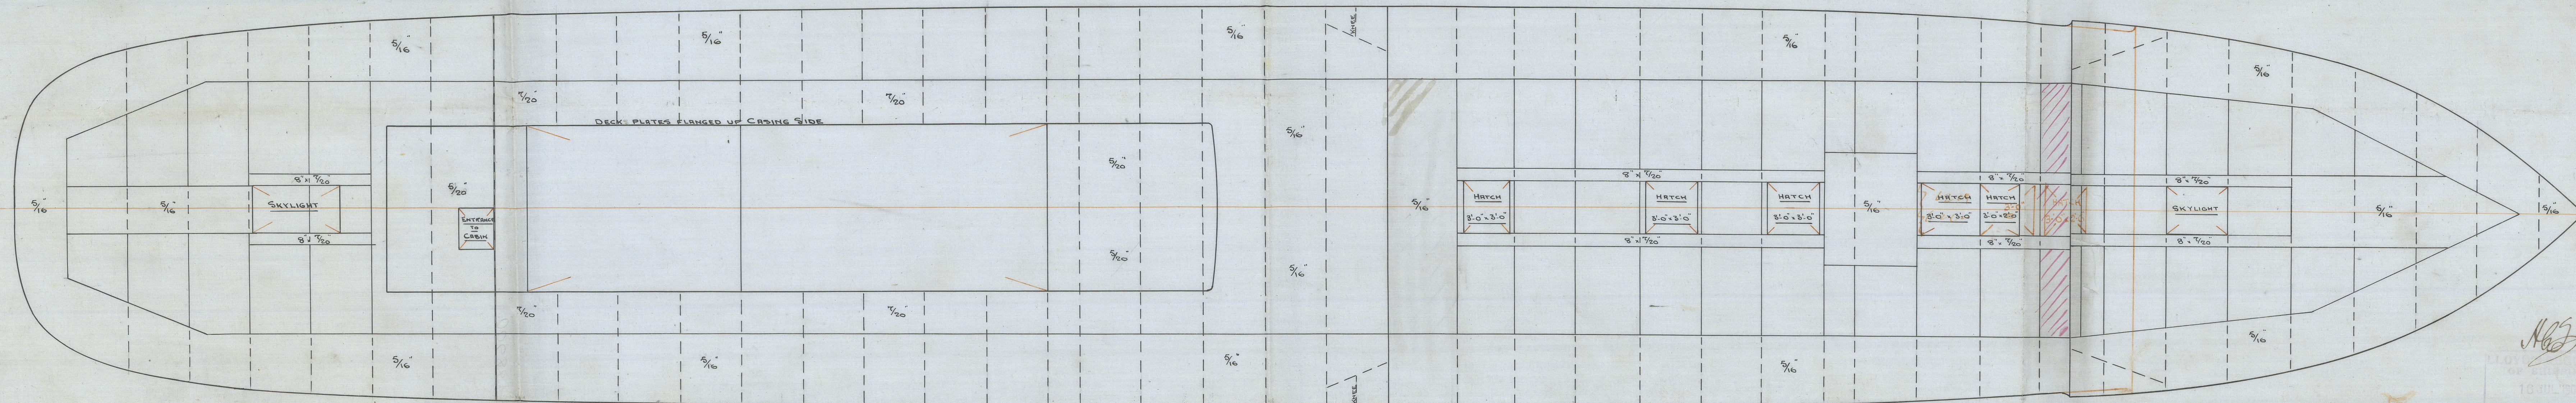




Profile & Deck Plan  
Cochran & Sons

No: 456-

s/s 'Albatross'  
Hull Report No. 21832

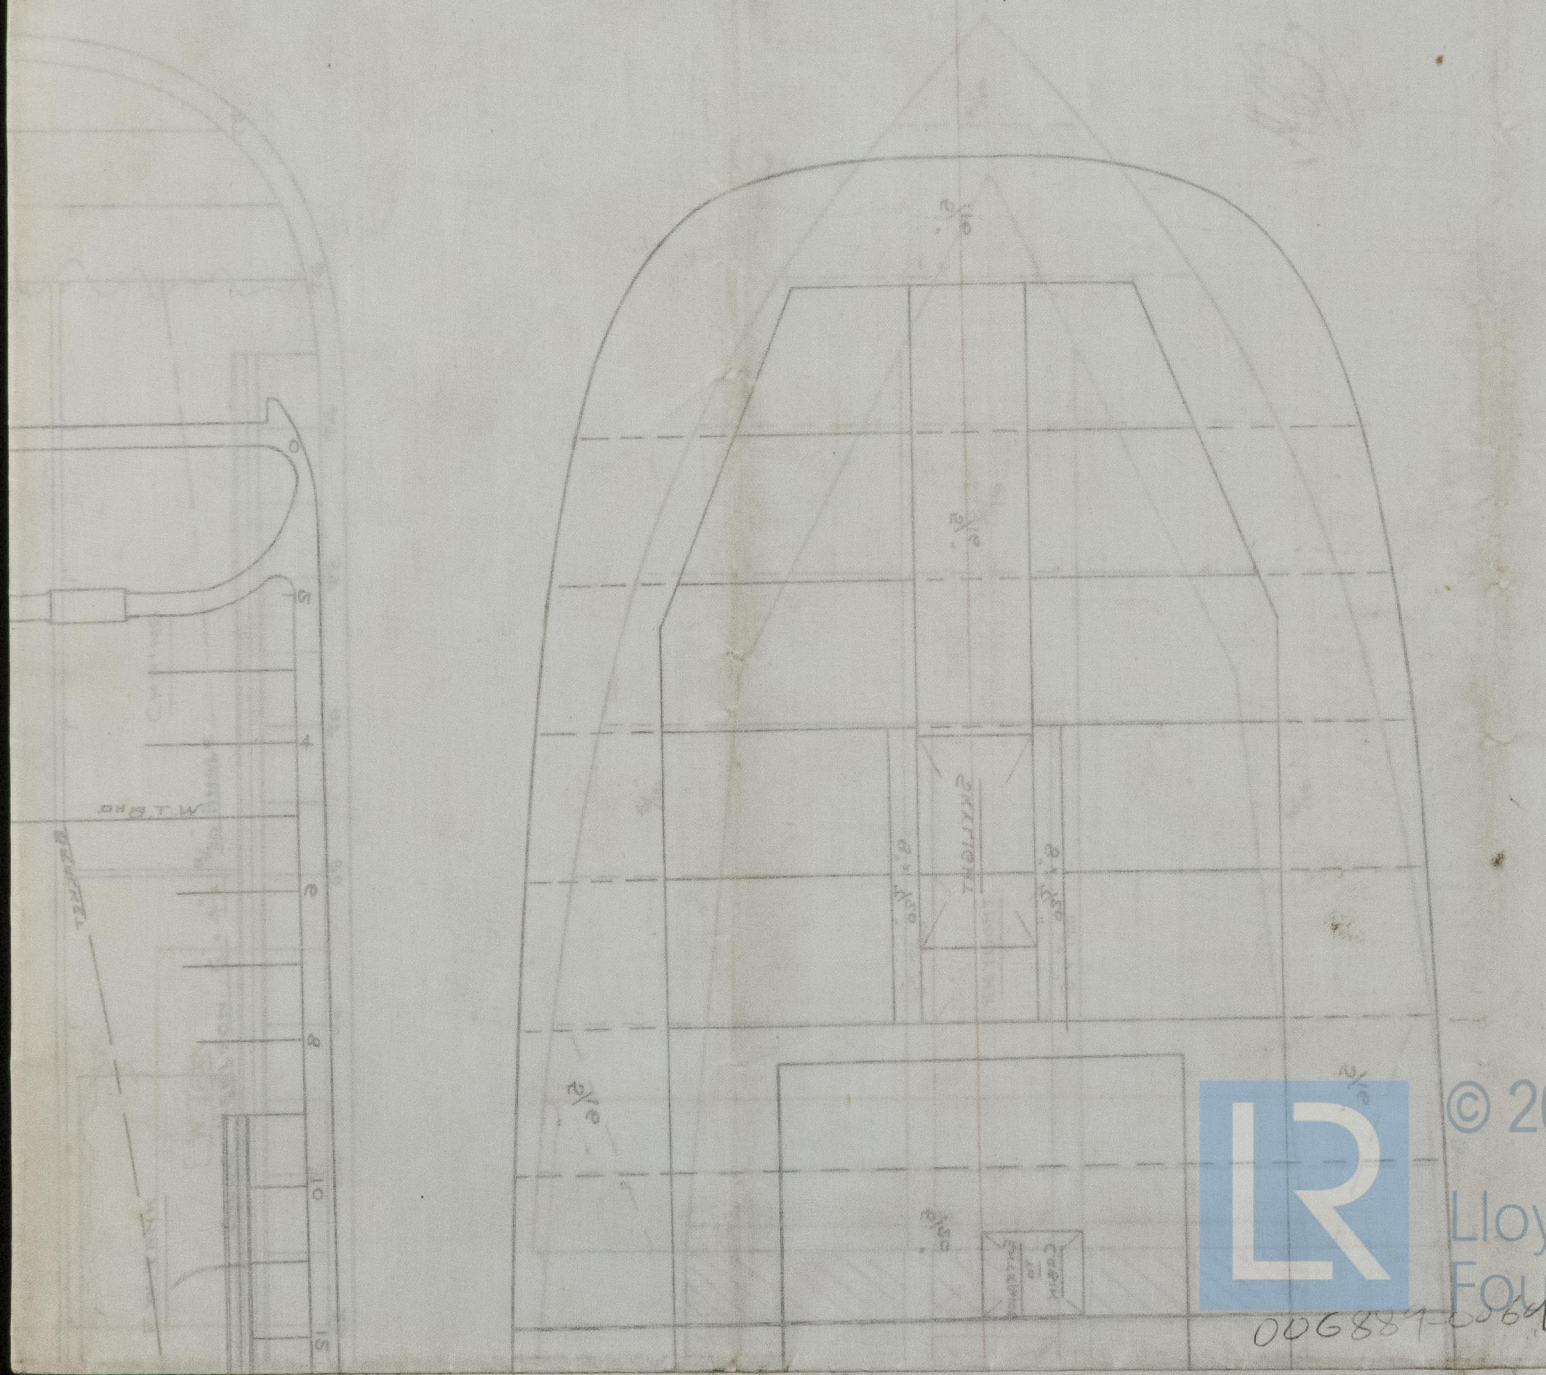

© 2021

Lloyd's Register  
Foundation

006887-006402-0119