


Estimated A x D
not exceeding 192.

Existing diameter of stock $6\frac{3}{4}$ "

PROPOSED ADDITION
SHOWN SHADED

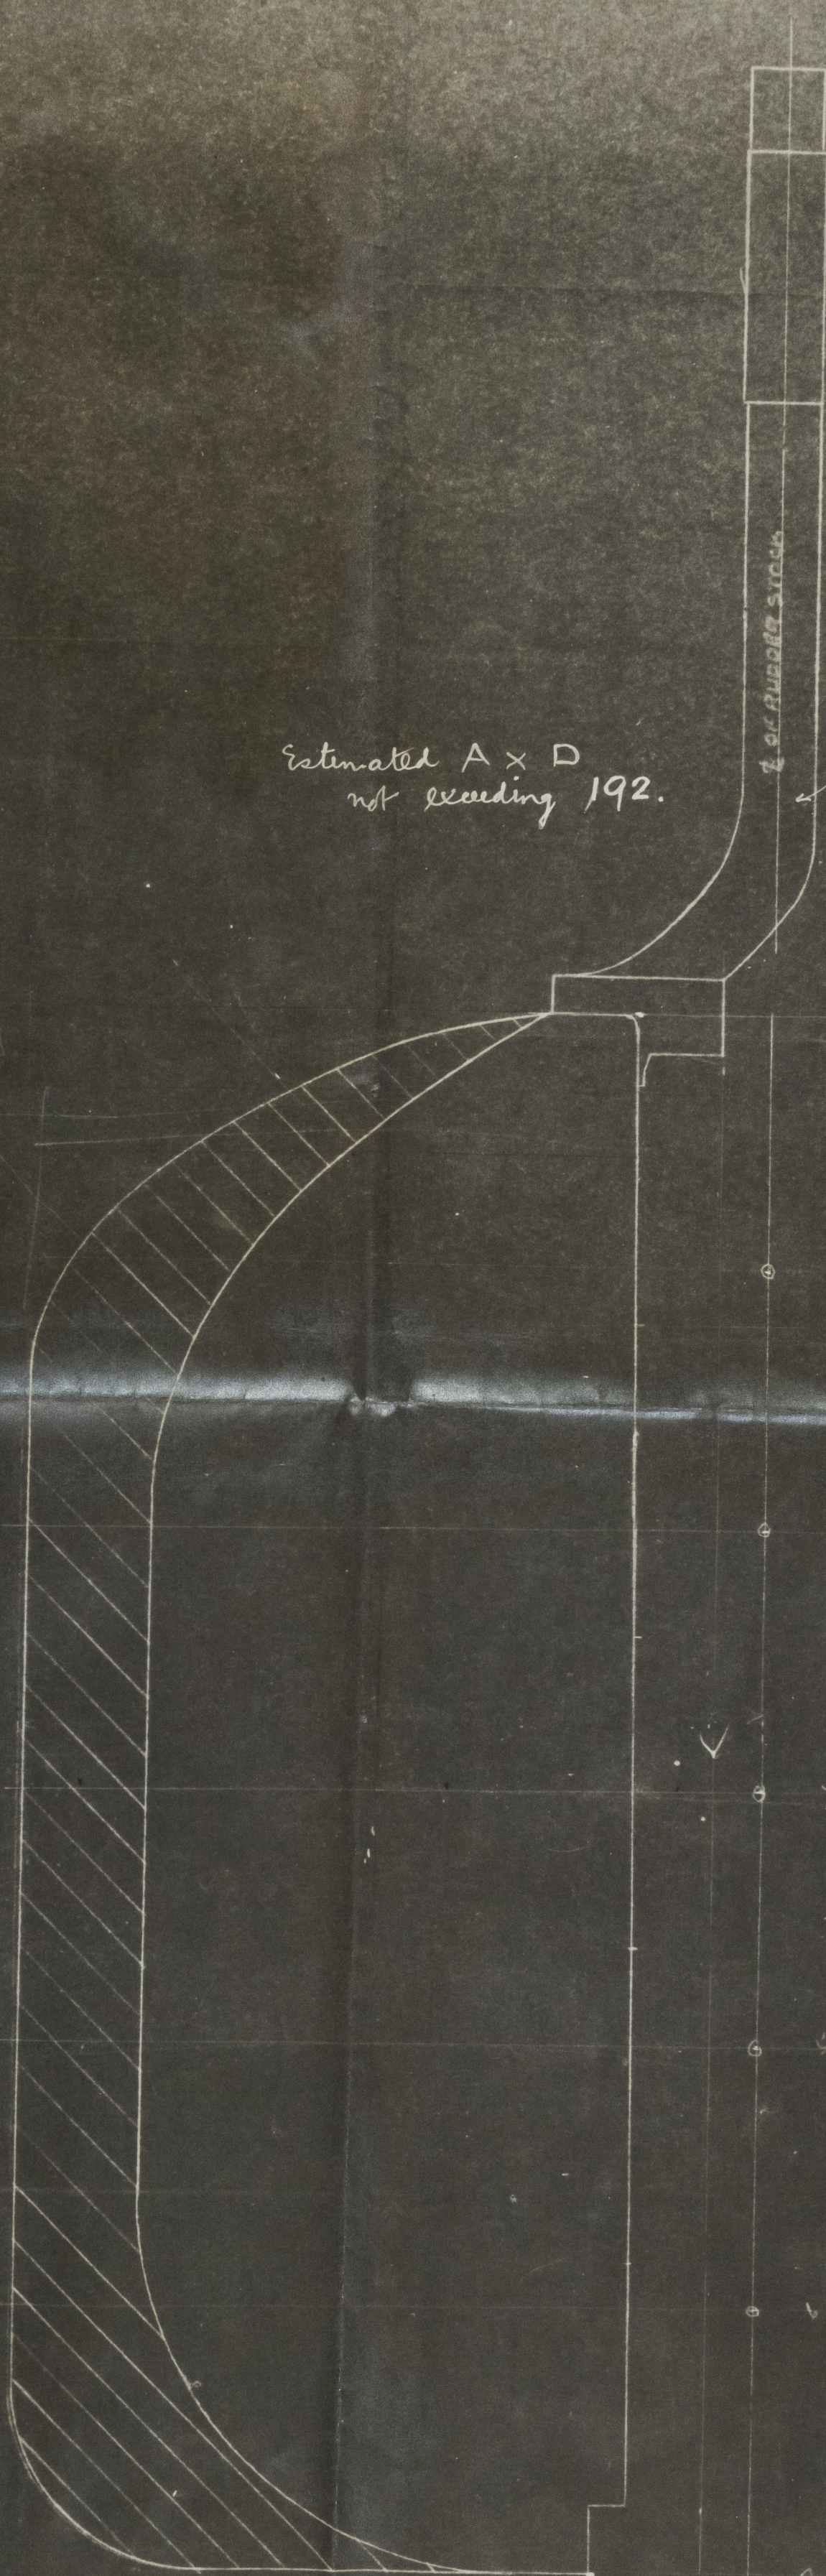

S/T. ABEILLE No. 22

21. 1. 38

PROPOSED ADDITION TO RUDDER
SCALE - 1" = 1 FOOT
13-1-38



Lloyd's Register
Foundation