
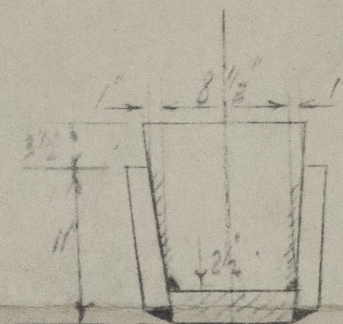
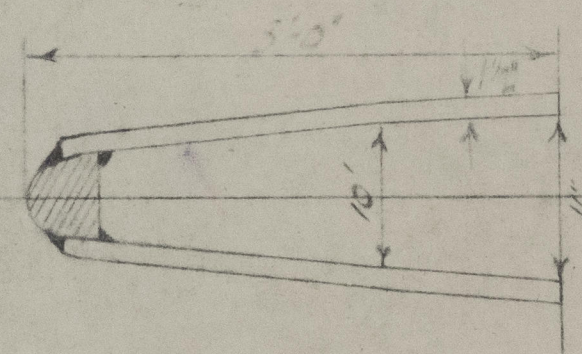


MESSRS HARLAND & WOLFF LTD GLASGOW

NEW STERN FRAME ARRANGEMENT


FOR SHIP NO 13430 13440 13450

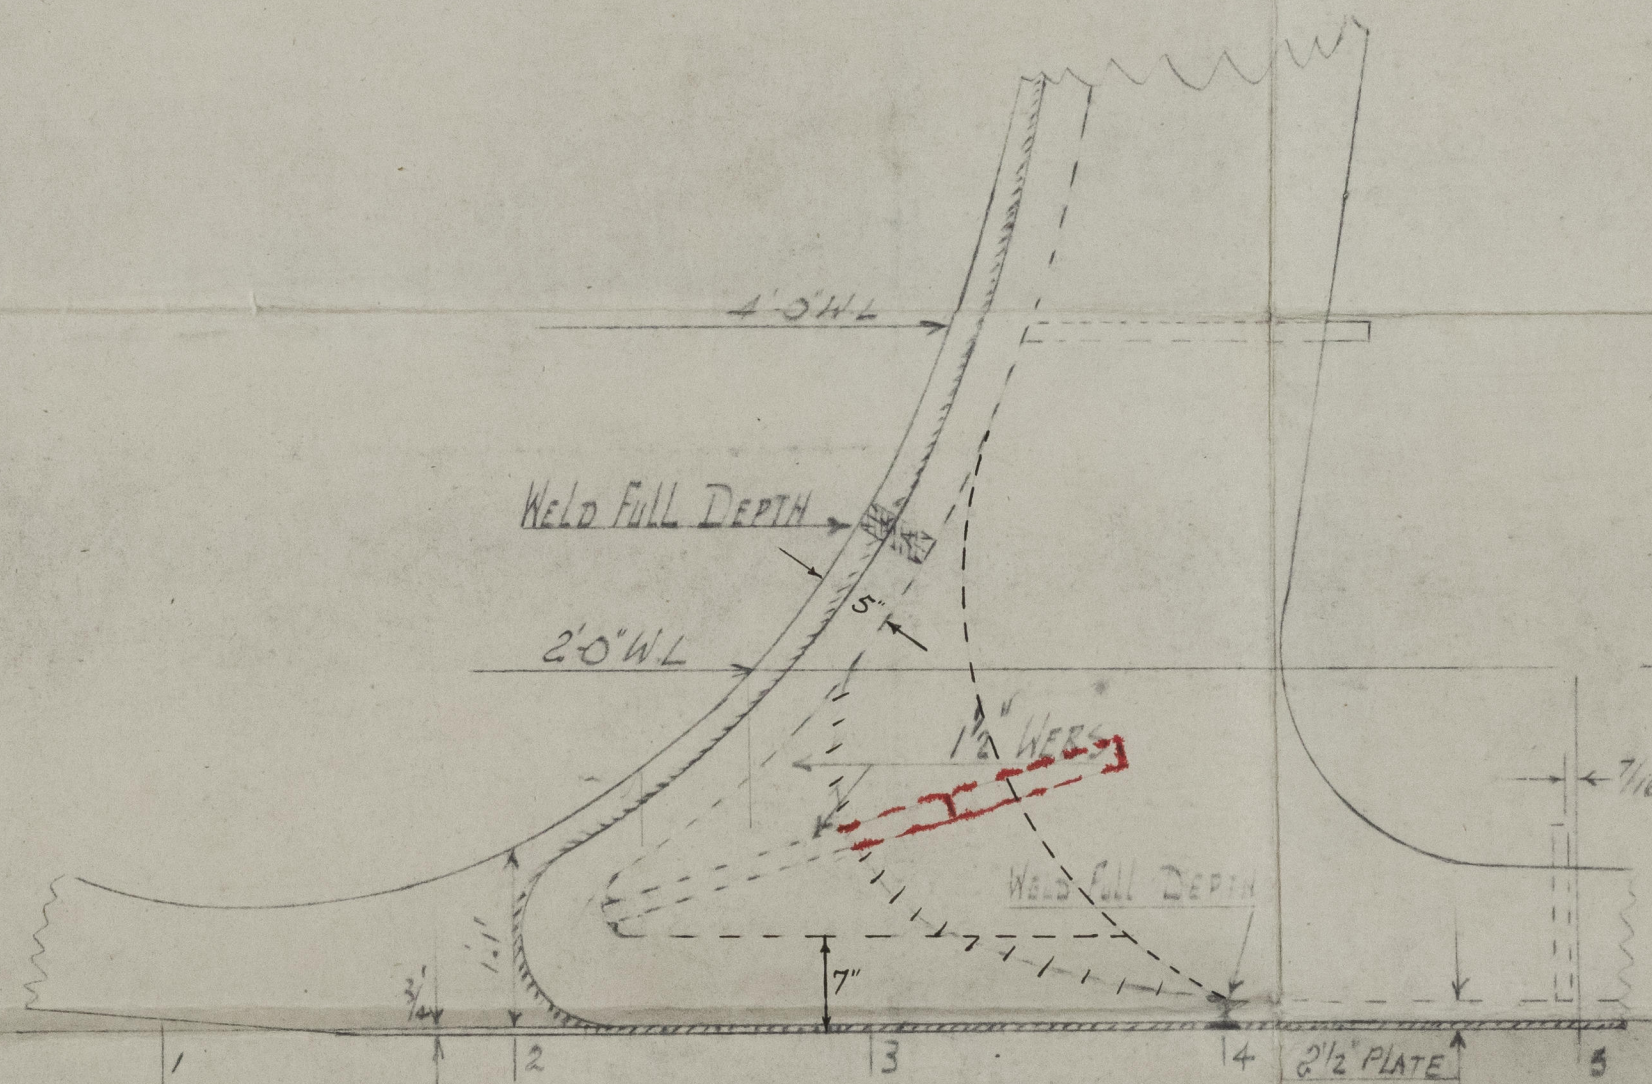


SECTION AT FR 5  
LOOKING AFT

APPROVED  
LLOYD'S REGISTER OF SHIPPING

*John R. Clark* 2/2 1946

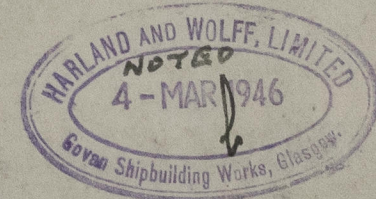

DRAWN NO 2448/A  
COLVILLE CONSTRUCTIONAL CO LTD  
GLENGREENOCK  

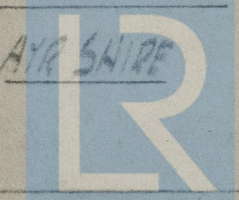

© 2021  
Lloyd's Register  
Foundation

006903- 006911- 0211




4

Hawland & Woff

N<sup>o</sup> 1303-4-5

N<sup>o</sup> 5 Empire Court

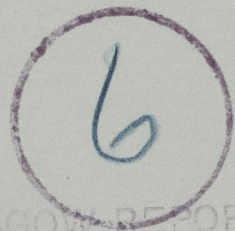

GLASGOW REPORT No.

La Hague 71815



006903-006911-0211

2.2.46



© 2021

Lloyd's Register  
Foundation