

SCREW TUG N° 144

SCALE $\frac{1}{2}'' = 1 \text{ FOOT}$


3. 8. 05





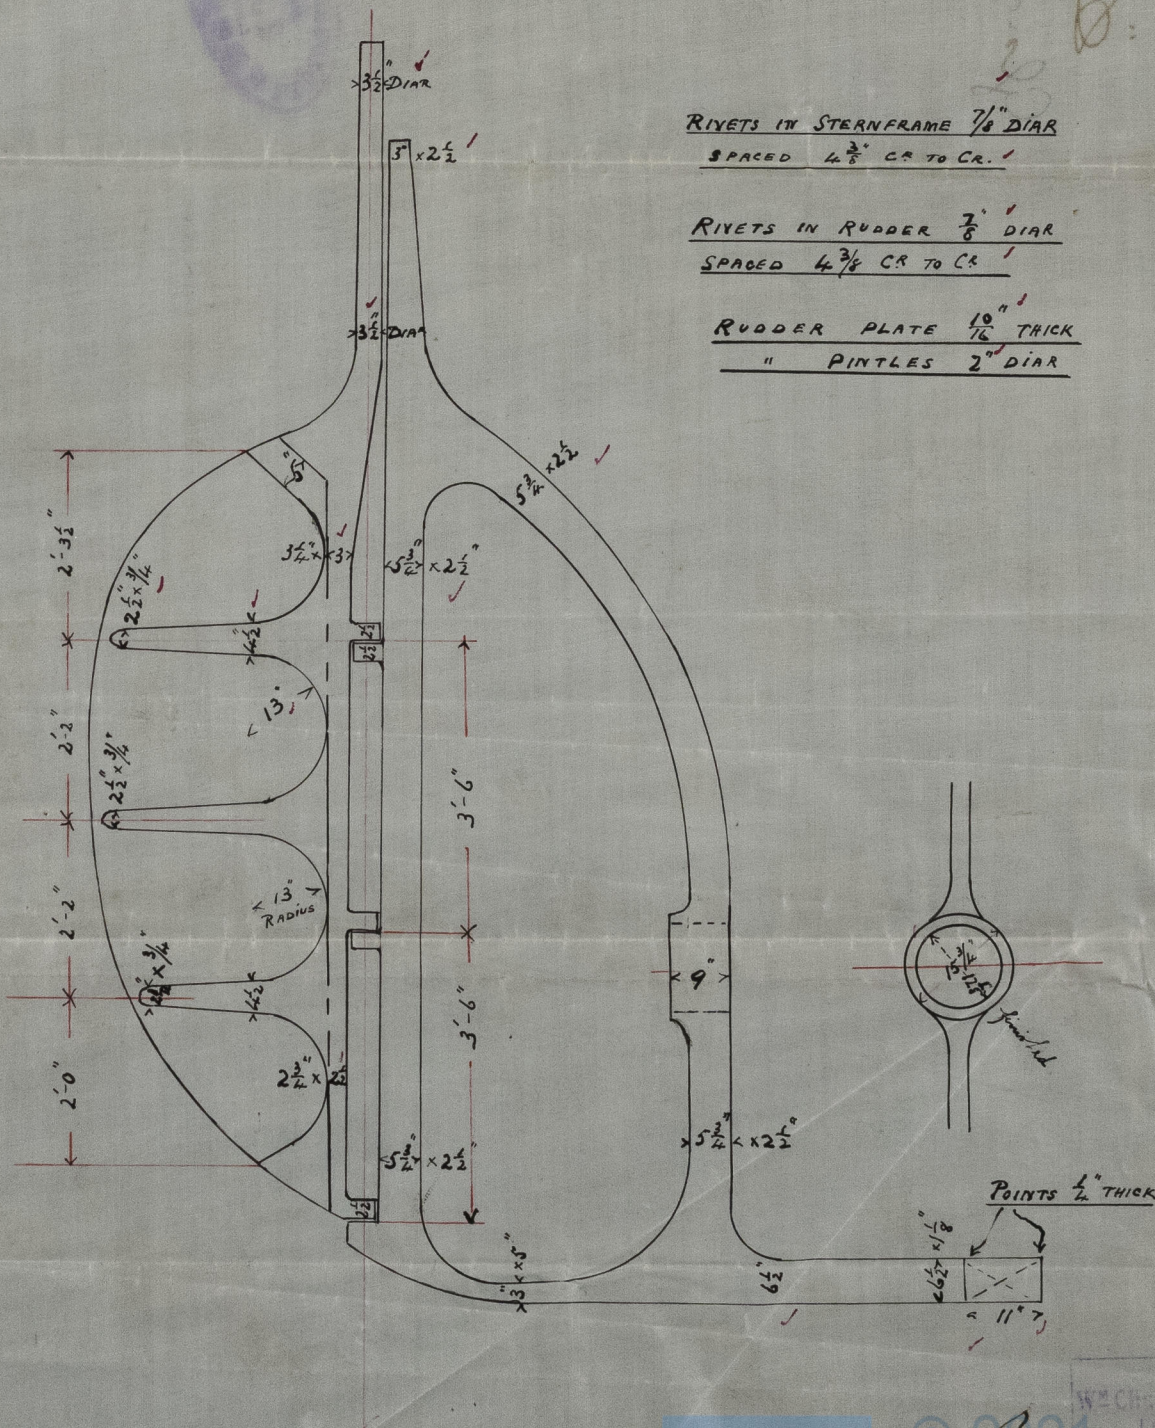

RIVETS IN STERNFRAME $\frac{7}{8}$ " DIAR
SPACED $4\frac{3}{8}$ " CR TO CR. ✓

RIVETS IN RUDDER $\frac{7}{8}$ DIAM
SPACED $4\frac{3}{8}$ CR TO CR

RUDDER PLATE $\frac{10}{16}$ " THICK
" PINTLES 2" DIAM

3.8.00

Lloyd's Register
Foundation

006942- 006953- 0156

FORGING PLAN

MESSRS W CHALMERS I G. LTD

S. T. No 144


"Douglas II"

Gls. npt. 23614

RECEIVED BY THE
MESSRS W CHALMERS I G LTD



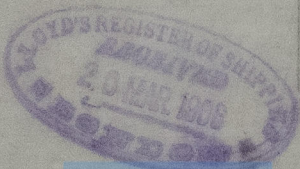

© 2021

Lloyd's Register
Foundation

006942- 006953- 0156