

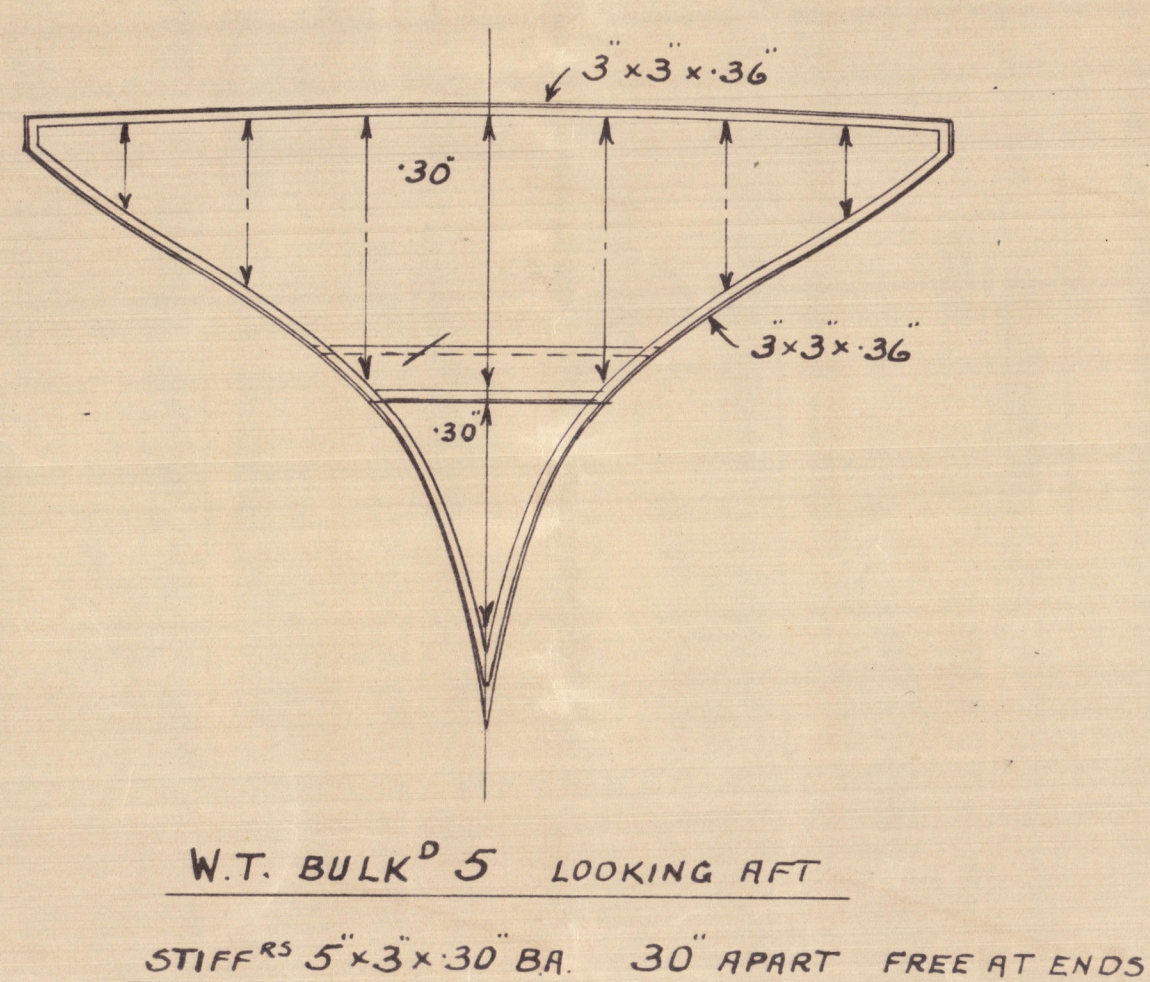
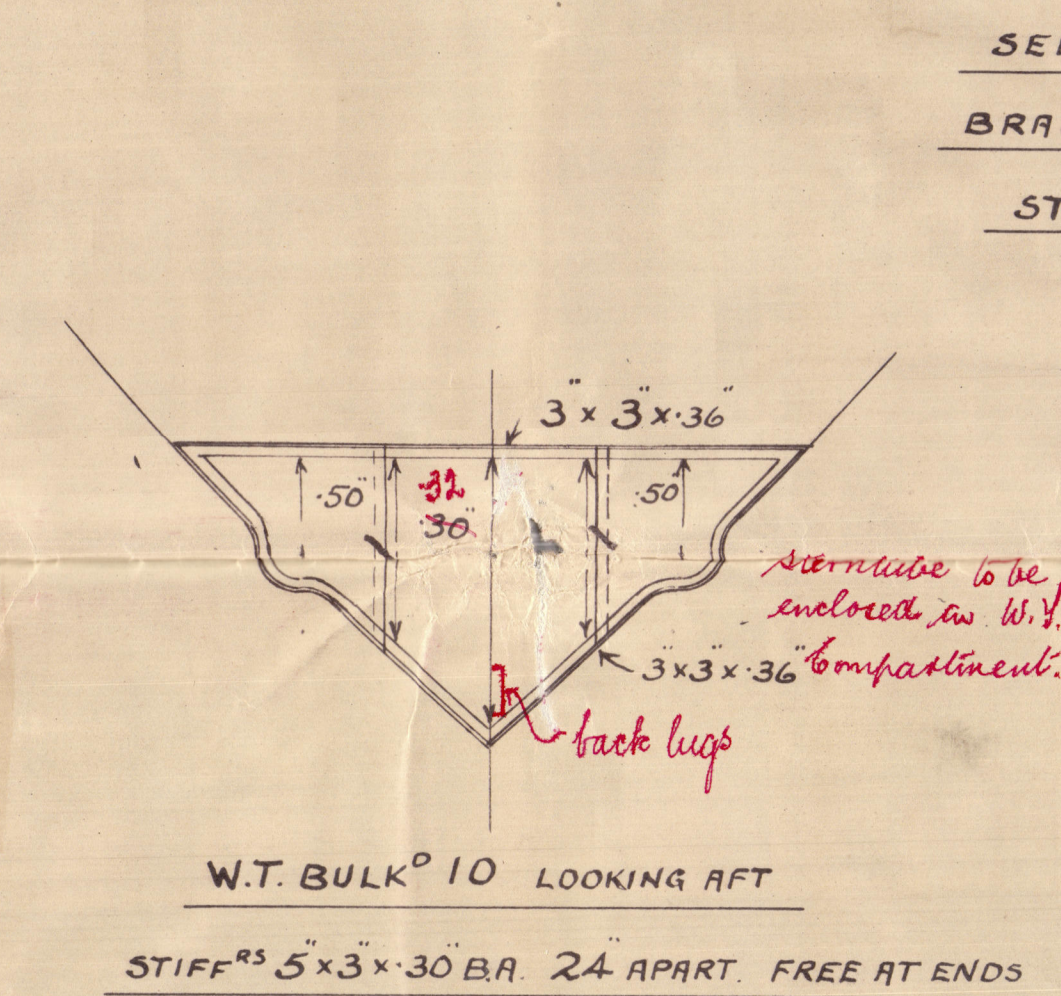
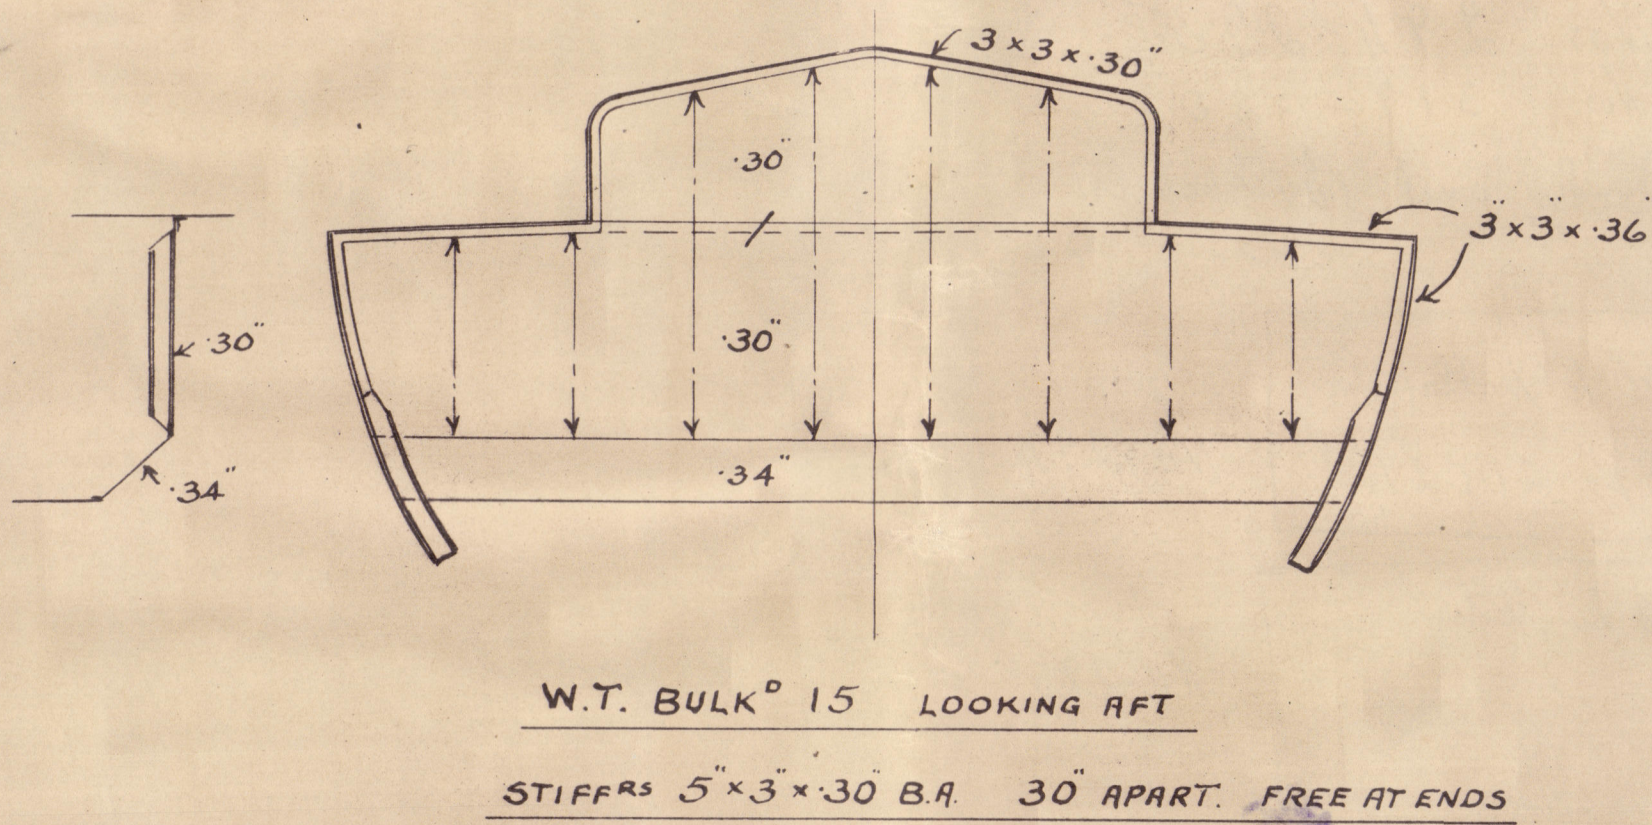
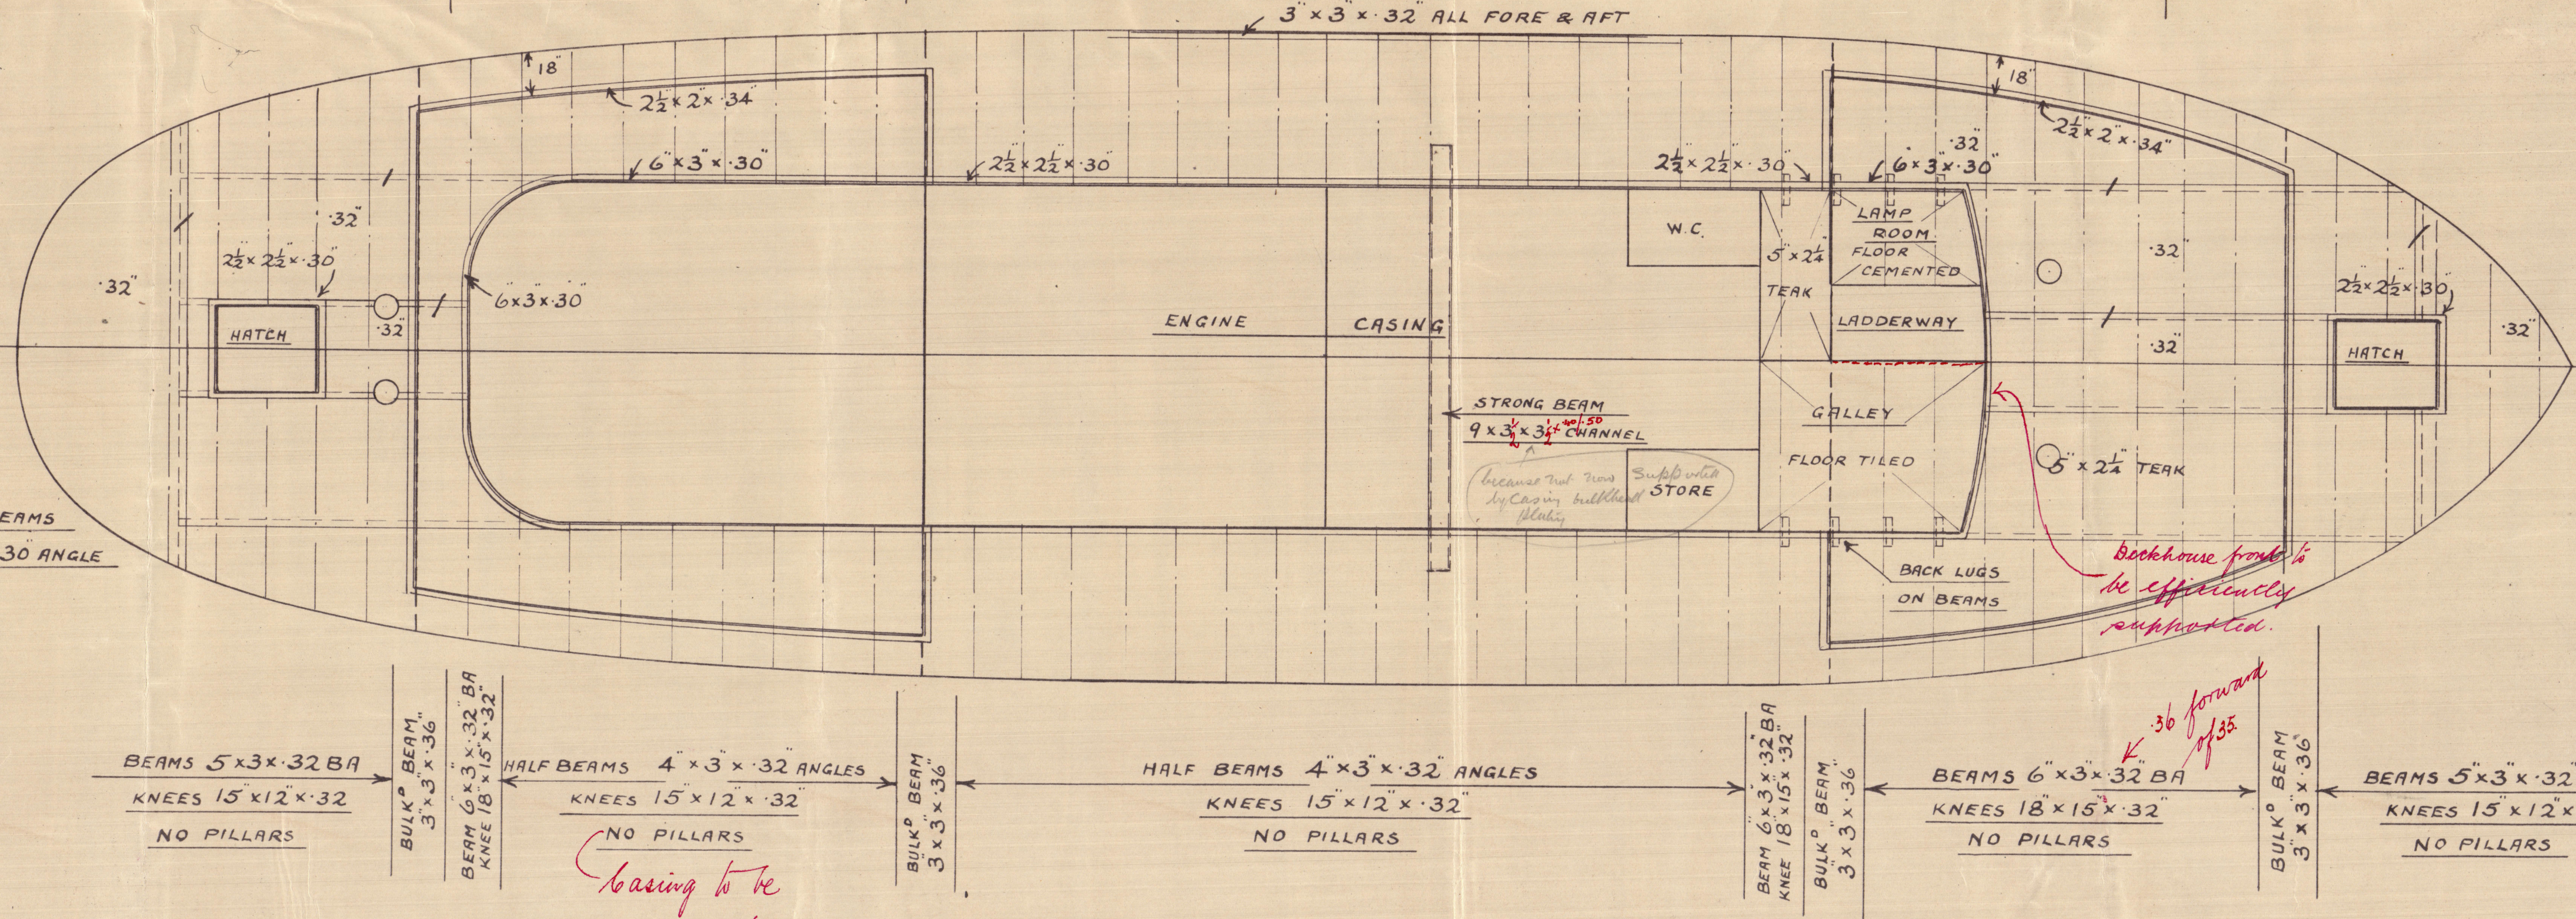
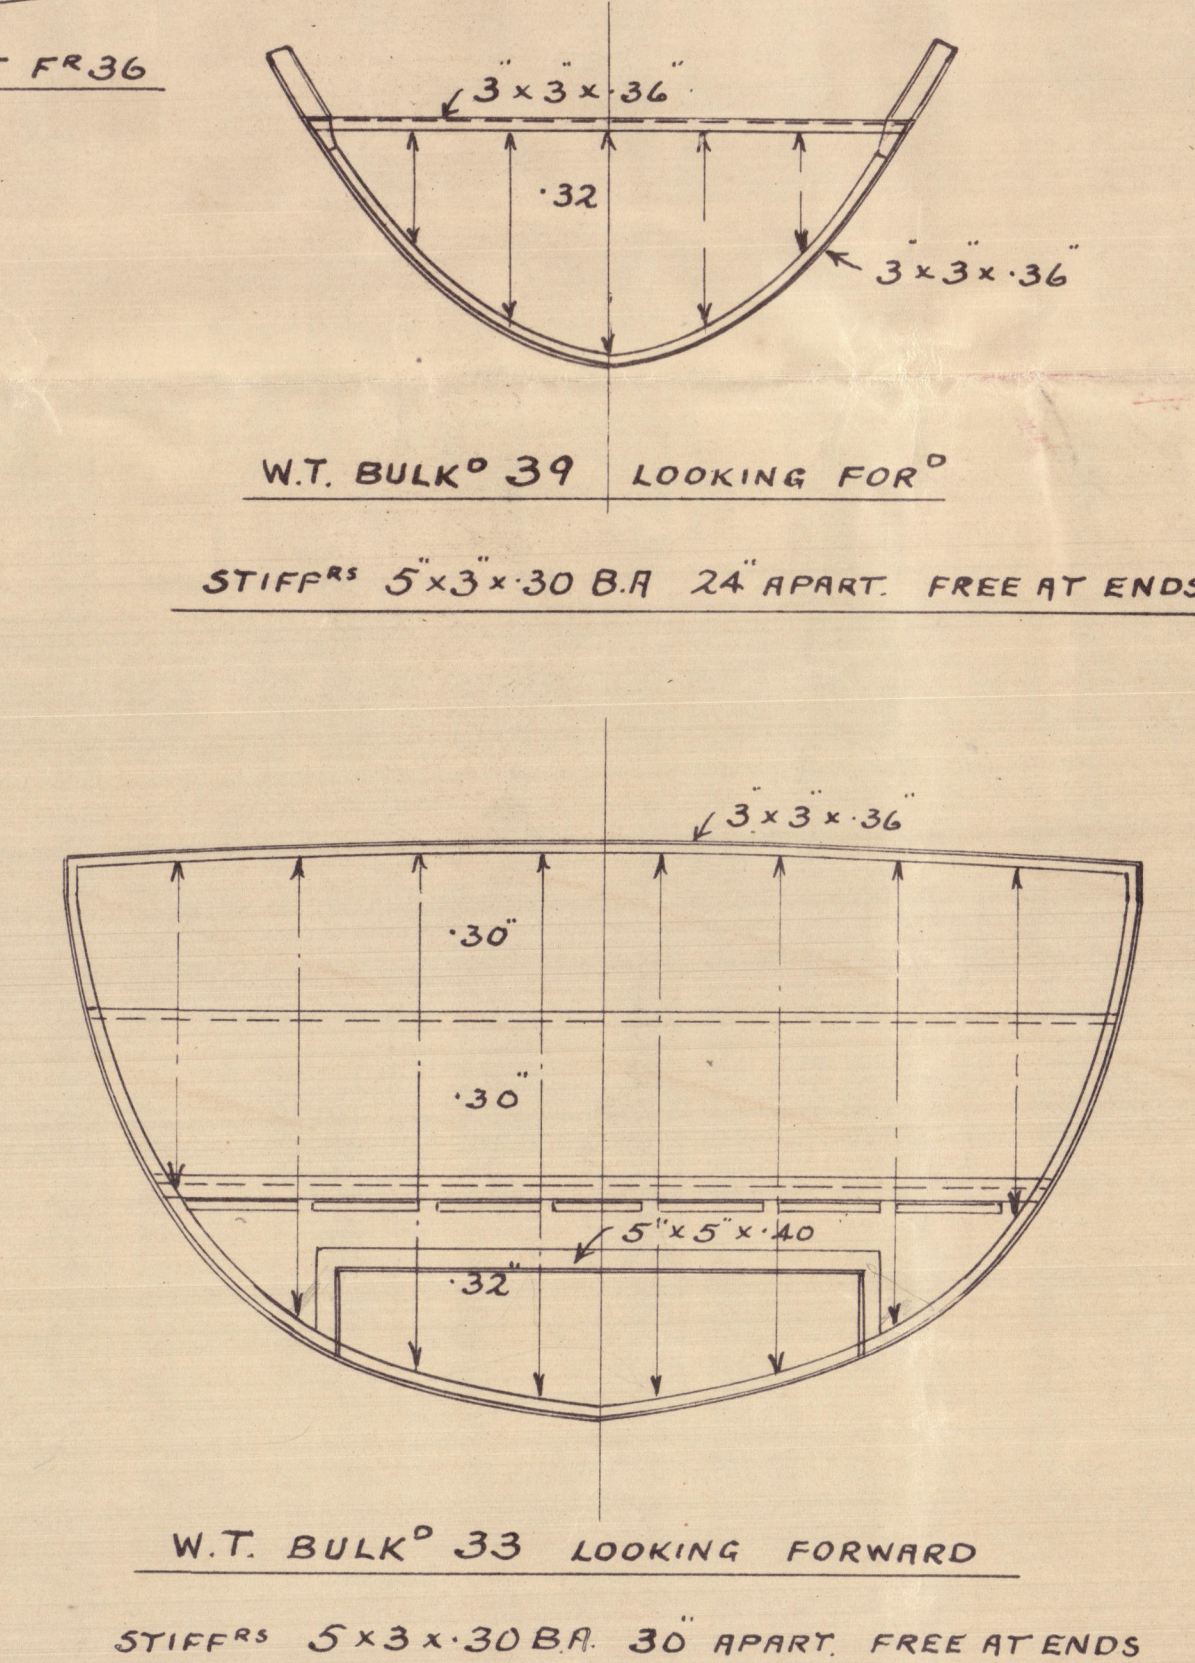
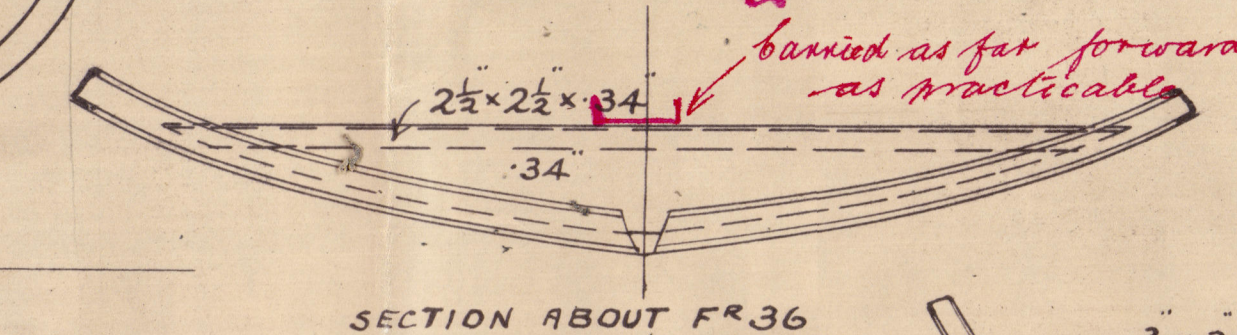
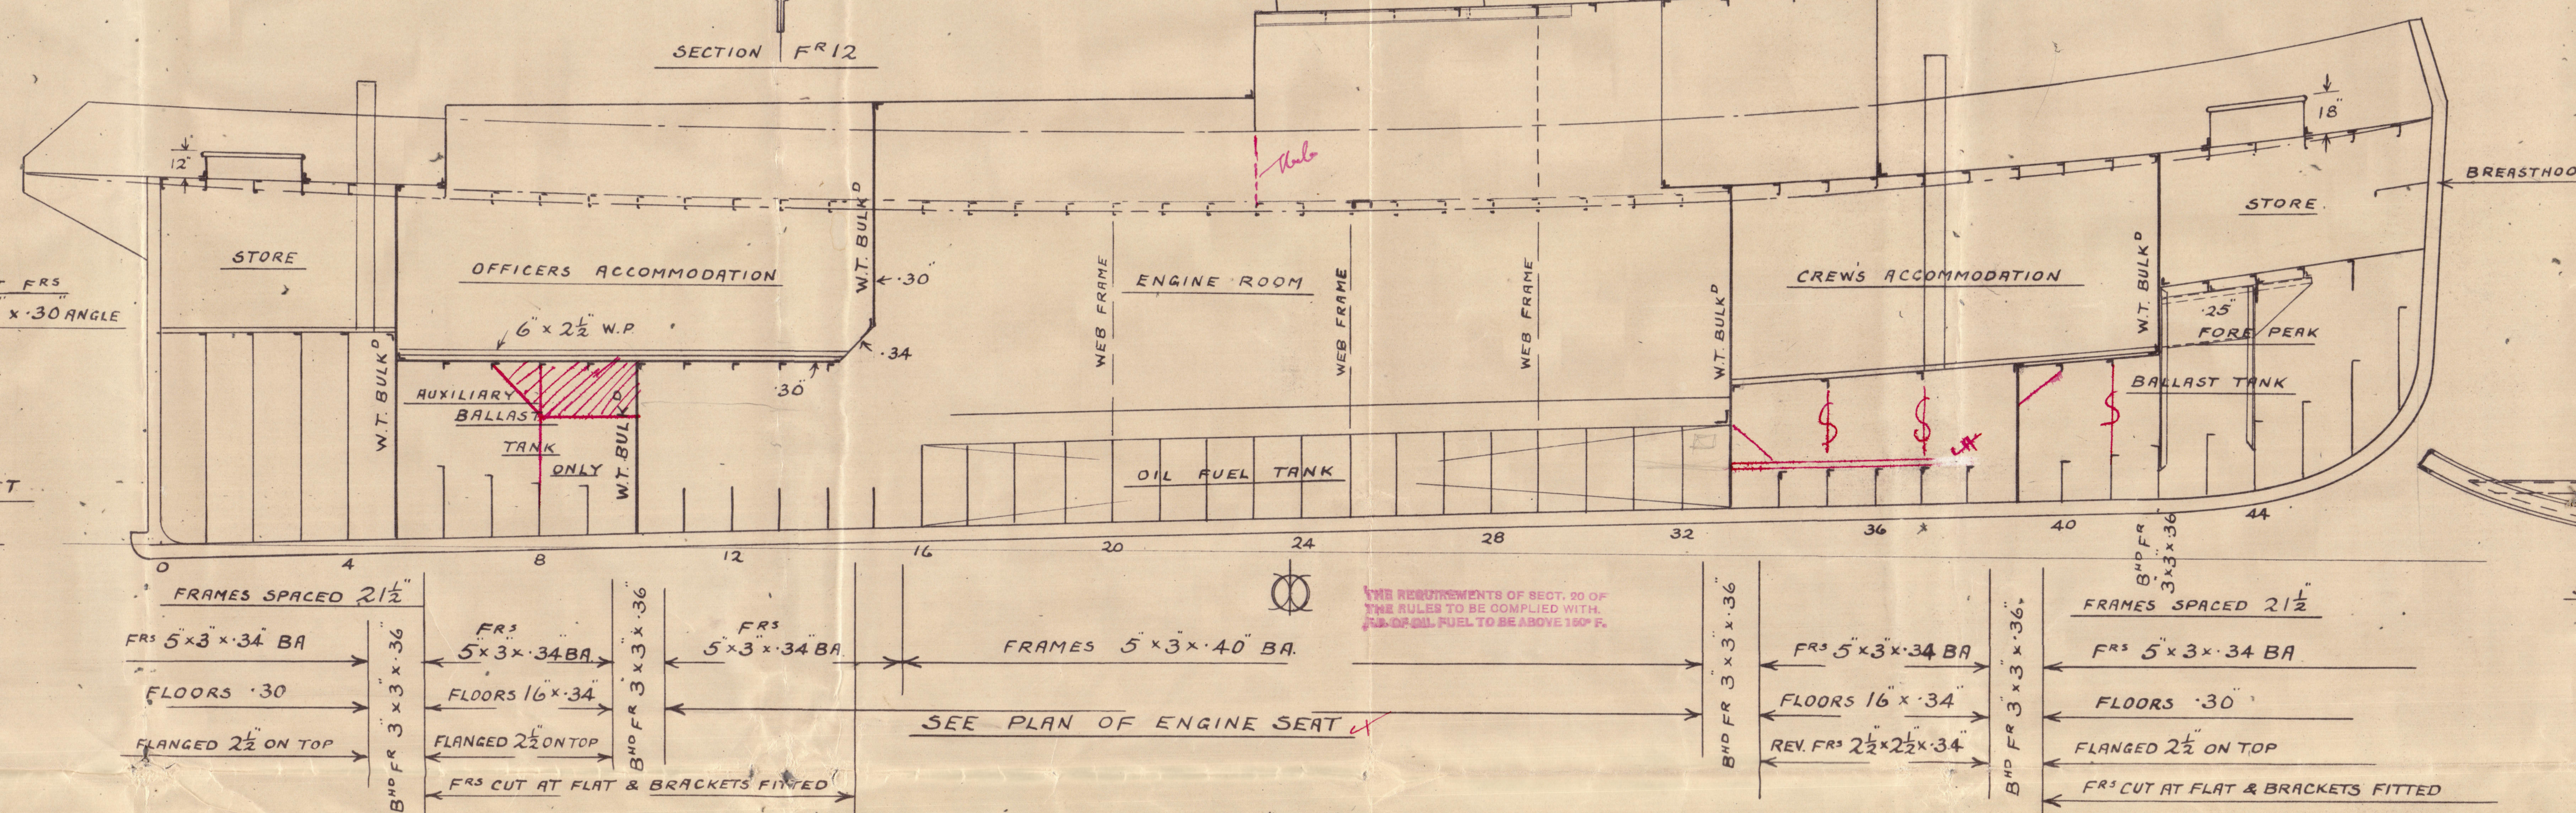


(see Blank letter)
9-5-39

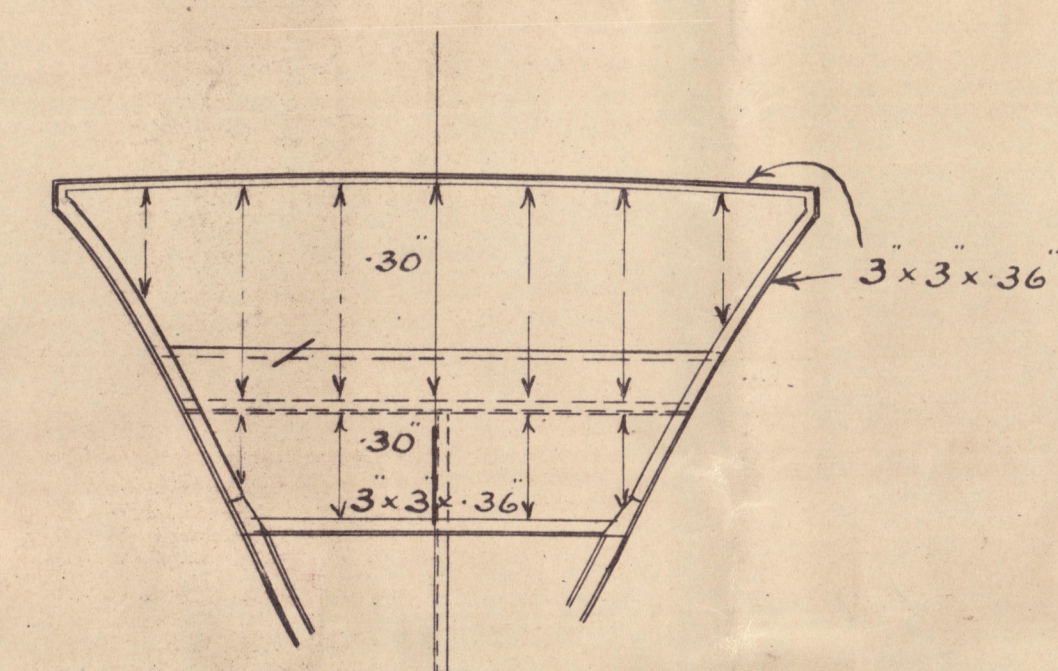

assumed not less
than 50 above deck.*

Reveting in way of Engine Seating to be submitted

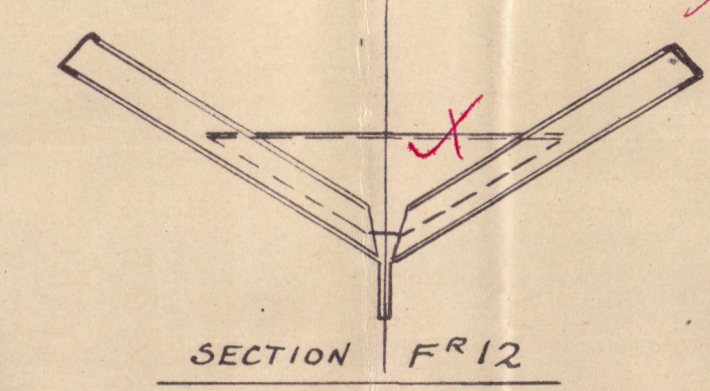

APPROVED
LLOYD'S REGISTER OF SHIPPING
H. Dickson
DATE 21.4.39

Henry Robt Det. 's

Yard Nos. 294-295
Nos. 319-320

Profile, Decks, and Bulkheads.

Jug. "M.S. b. Mallard"
Lith. Rpt. No. 20027.

No. 294

Jug "M.S. b. Merlin"
Lith. Rpt. No. 20073

No. 295

Jug "M.S.C. NEPTUNE"
Lith. Rpt. No. 20601

No 319



© 2021

Lloyd's Register
Foundation

006968-006982-0107