


2.4/12


Nos. 533 - 34

SKETCH SHEWING ALTERNATIVE CENTRE KEELSON.

PLAN No. 1390  
FOR ENCLOSURE TO  
Messrs Lloyd's Surveyors  
Hull FROM  
COCHRANE & SONS,  
SHIPBUILDERS, SELSY.  
DATE 20/3/12. Rk

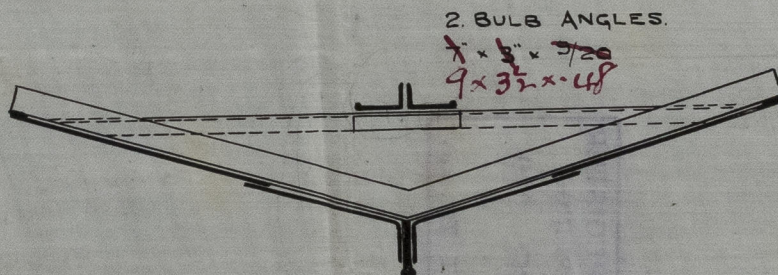

ALTERNATIVE KEELSON.

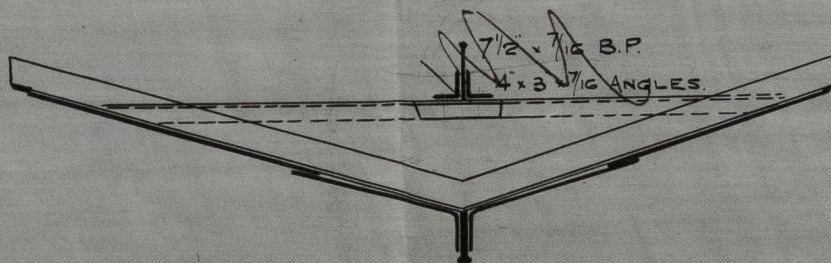

KEELSON AS APPROVED.

C.B.  
2.4.12



© 2021


Lloyd's Register  
Foundation

006968-006982-0148



Cochran & Sons  
No 533-4.  
Proposed alternative  
arrangement of Centre Keelson.

006968-006982-0148

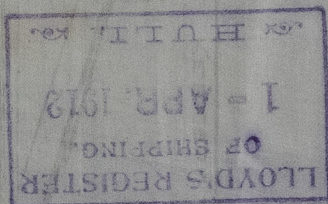

© 2021

Lloyd's Register  
Foundation