


4.10.02

SS N° 51
ELEVATION.


DIMENSIONS - 130'-0" x 21'-0" 11'-6" MOULDED.

SCALE 1/4" = 1 FOOT.

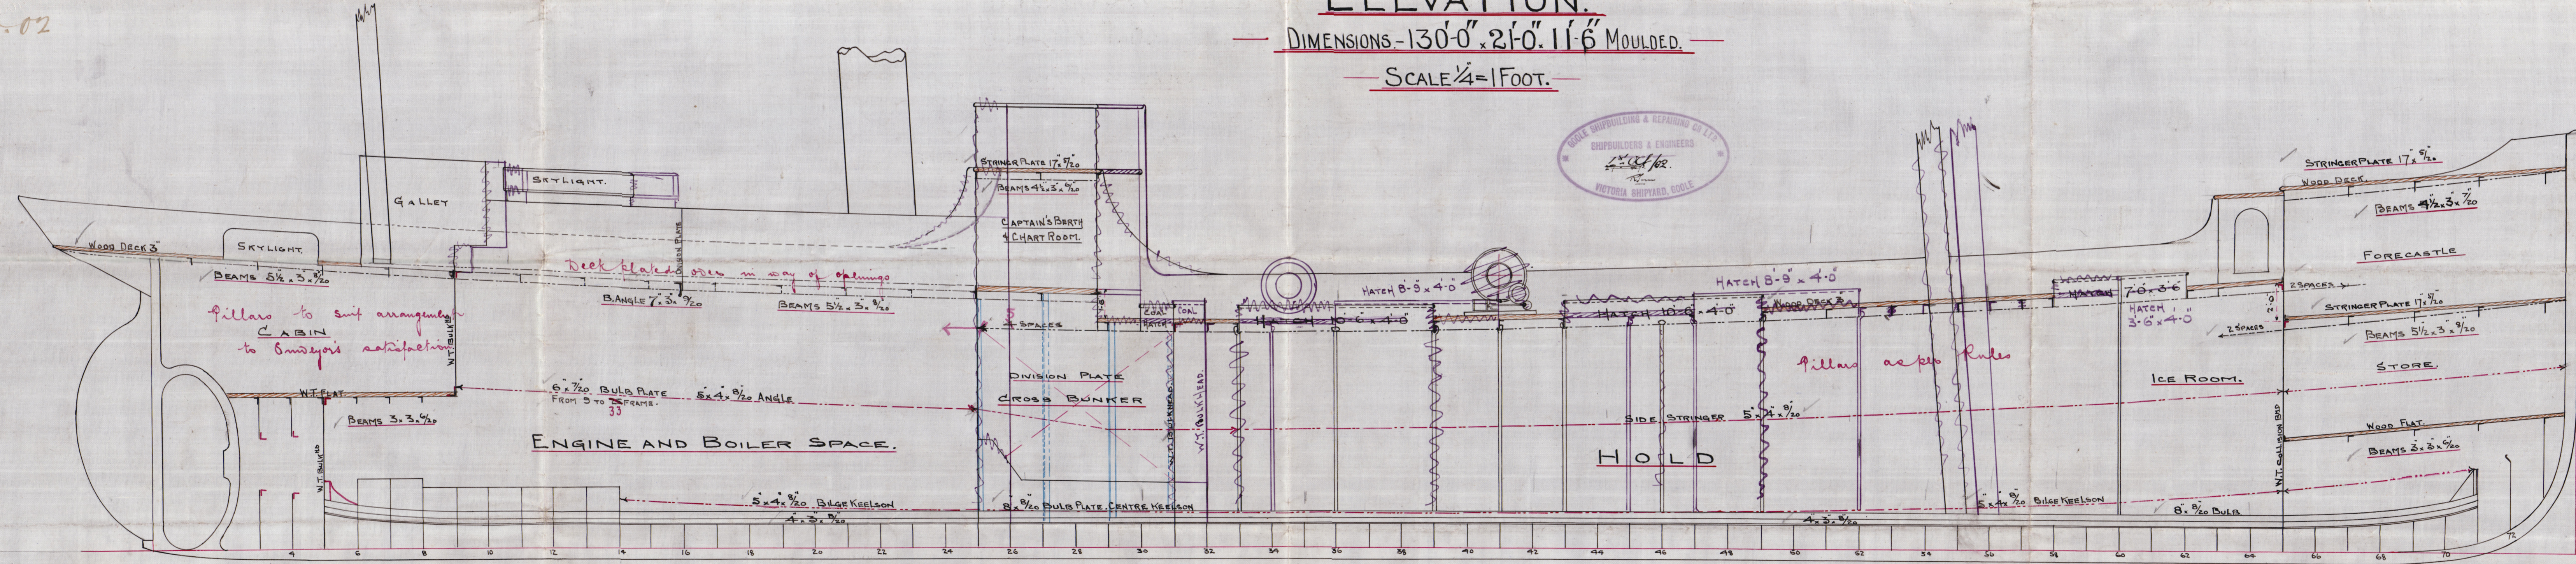

4.10.02

Profile
Goole S & R. Co's No. 51
% Jackdaw

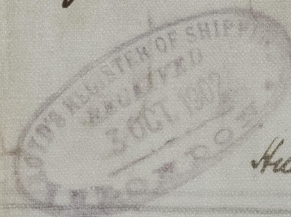

Hull Report No. 15190



© 2021

Lloyd's Register
Foundation

006983-006995-0017