

7.4.14

O.S.S 68

Hinterstegen und Ruderrahmen

Maßstab 1:10, 1:20

Speed under 18 knots. (Builded after 3/2/14)



Section of stock at this point to be increased to 7 in for combined twisting and bending stresses, tapering at A-B to the side gun.

Material:


Ruderrahmen: Stahlguss
Hinterstegen: Siemens-Martin Stahlgeschmiedet oder Stahlguss

bbf
7.4.14




15

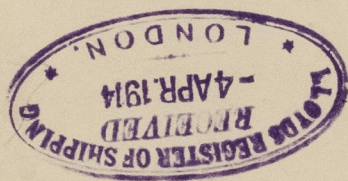

Lloyd - Register

Approved
Stempost & Rudder frame

Gen Box no 44

"Jugoslaviya"
Sok 470.

89



© 2021

Lloyd's Register
Foundation

006496-007007-0137



© 2021

Lloyd's Register
Foundation