


18-2-914
UC2

Approved by design
6/11/914

PROFILE

T.S.S. No 68

Scale $\frac{1}{8}$ " = 1 Foot

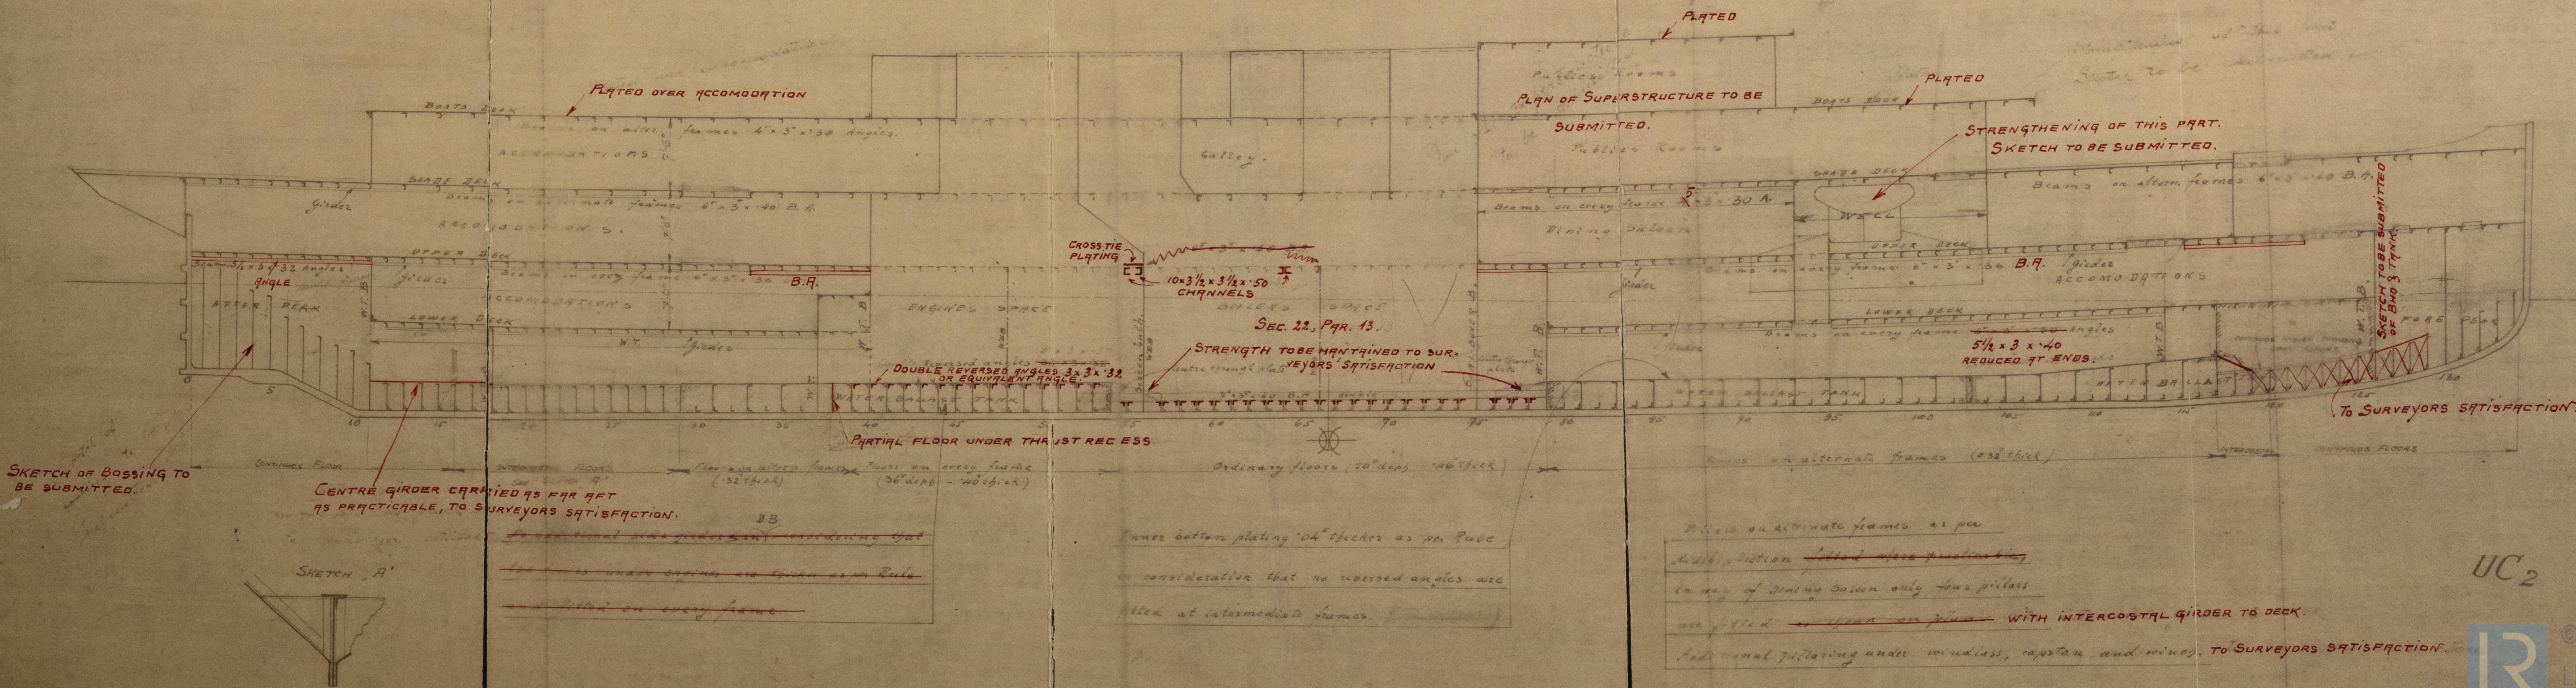

UC2

Profile (Copy)

S/S. №68

"Jugoslavija"

Sok 470.




© 2021

Lloyd's Register
Foundation

006996-007007-0138

3

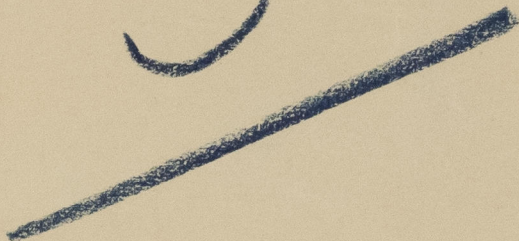

006996-007007-0138



© 2021

Lloyd's Register
Foundation