



# T.S.S. N°68. MIDSHIP SECTION (ALTERNATIVE)

CLASS LLOYDS REGISTER 100A1

SHADE DECK WITH REEFED 2' 9" FROM UPPER D.

ADAPTIVE SERVICE ONLY.


DIMENSIONS L 253'-0" BT B.M. 34' 2" D.M. 15' 6"

TRANSVERSE No (B+D) = 49.66 - LONGIT. No (B+D) L = 125.64

SCALE  $\frac{1}{2}$ " = 1 FOOT

## EQUIPMENT

- 1 KEDGE 4 $\frac{1}{4}$  "
- 240 FMS 1 $\frac{1}{8}$ " stud chain cable
- 75 " 3 $\frac{1}{4}$ " steel wire for steam.
- 90 " continue 3 $\frac{1}{4}$ " steel wire
- 2 WARPS each 90 FMS 6" size
- 2 HANSERS 90 " 5"

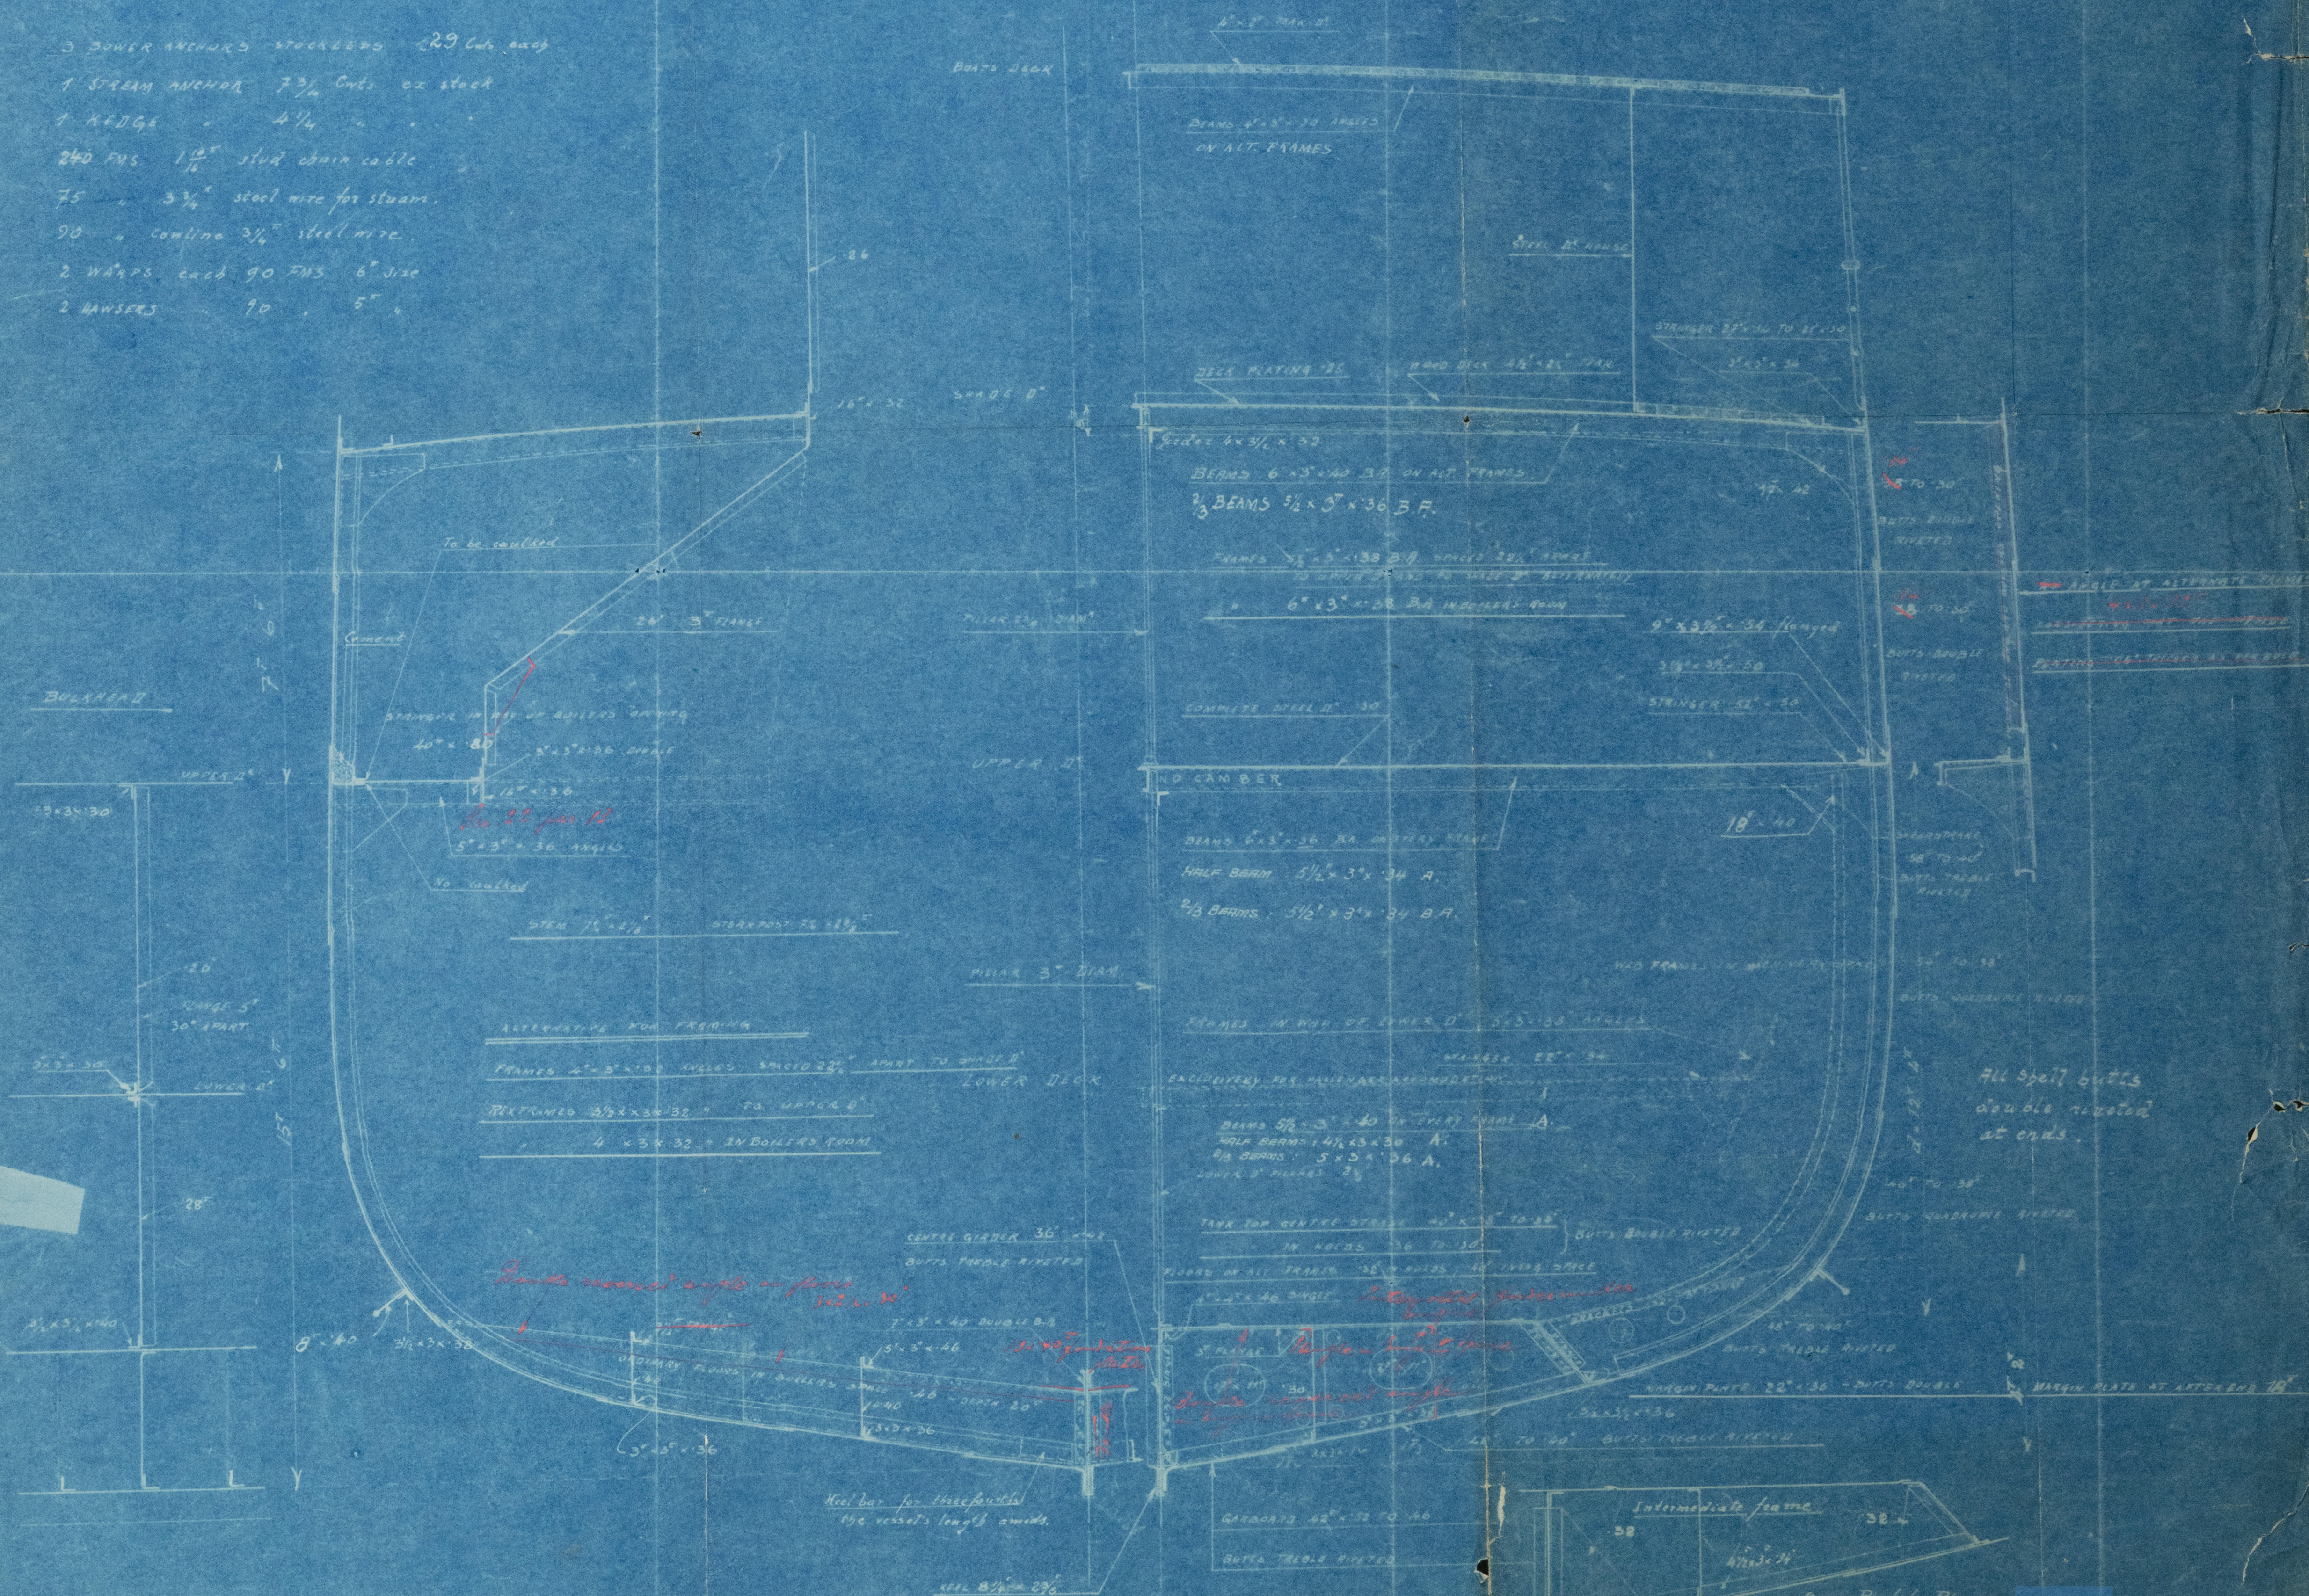



Midship Section

1a

"Jugoslaviya"

Sok 470.



© 2021

Lloyd's Register  
Foundation

006996-007007-0140