

30-1-03


# PROFILE AND DECK PLANS. S.S. N<sup>o</sup> 497.

DIMENSIONS.  
348' x 45' 11" x 29' 6"  
SCALE 1/8" = 1 FOOT.

## LLOYD'S NUMERALS

PER DECK NUMERALS  
FRAME NO. 84-9  
EQUIPMENT NO. 114-56  
PLATING NO. 308-244  
DEPTH TO LENGTH 18-40

3 DE NUMERALS  
FRAME NO. 98-02  
PLATING NO. 312-8-01  
DEPTH TO LENGTH 11-39

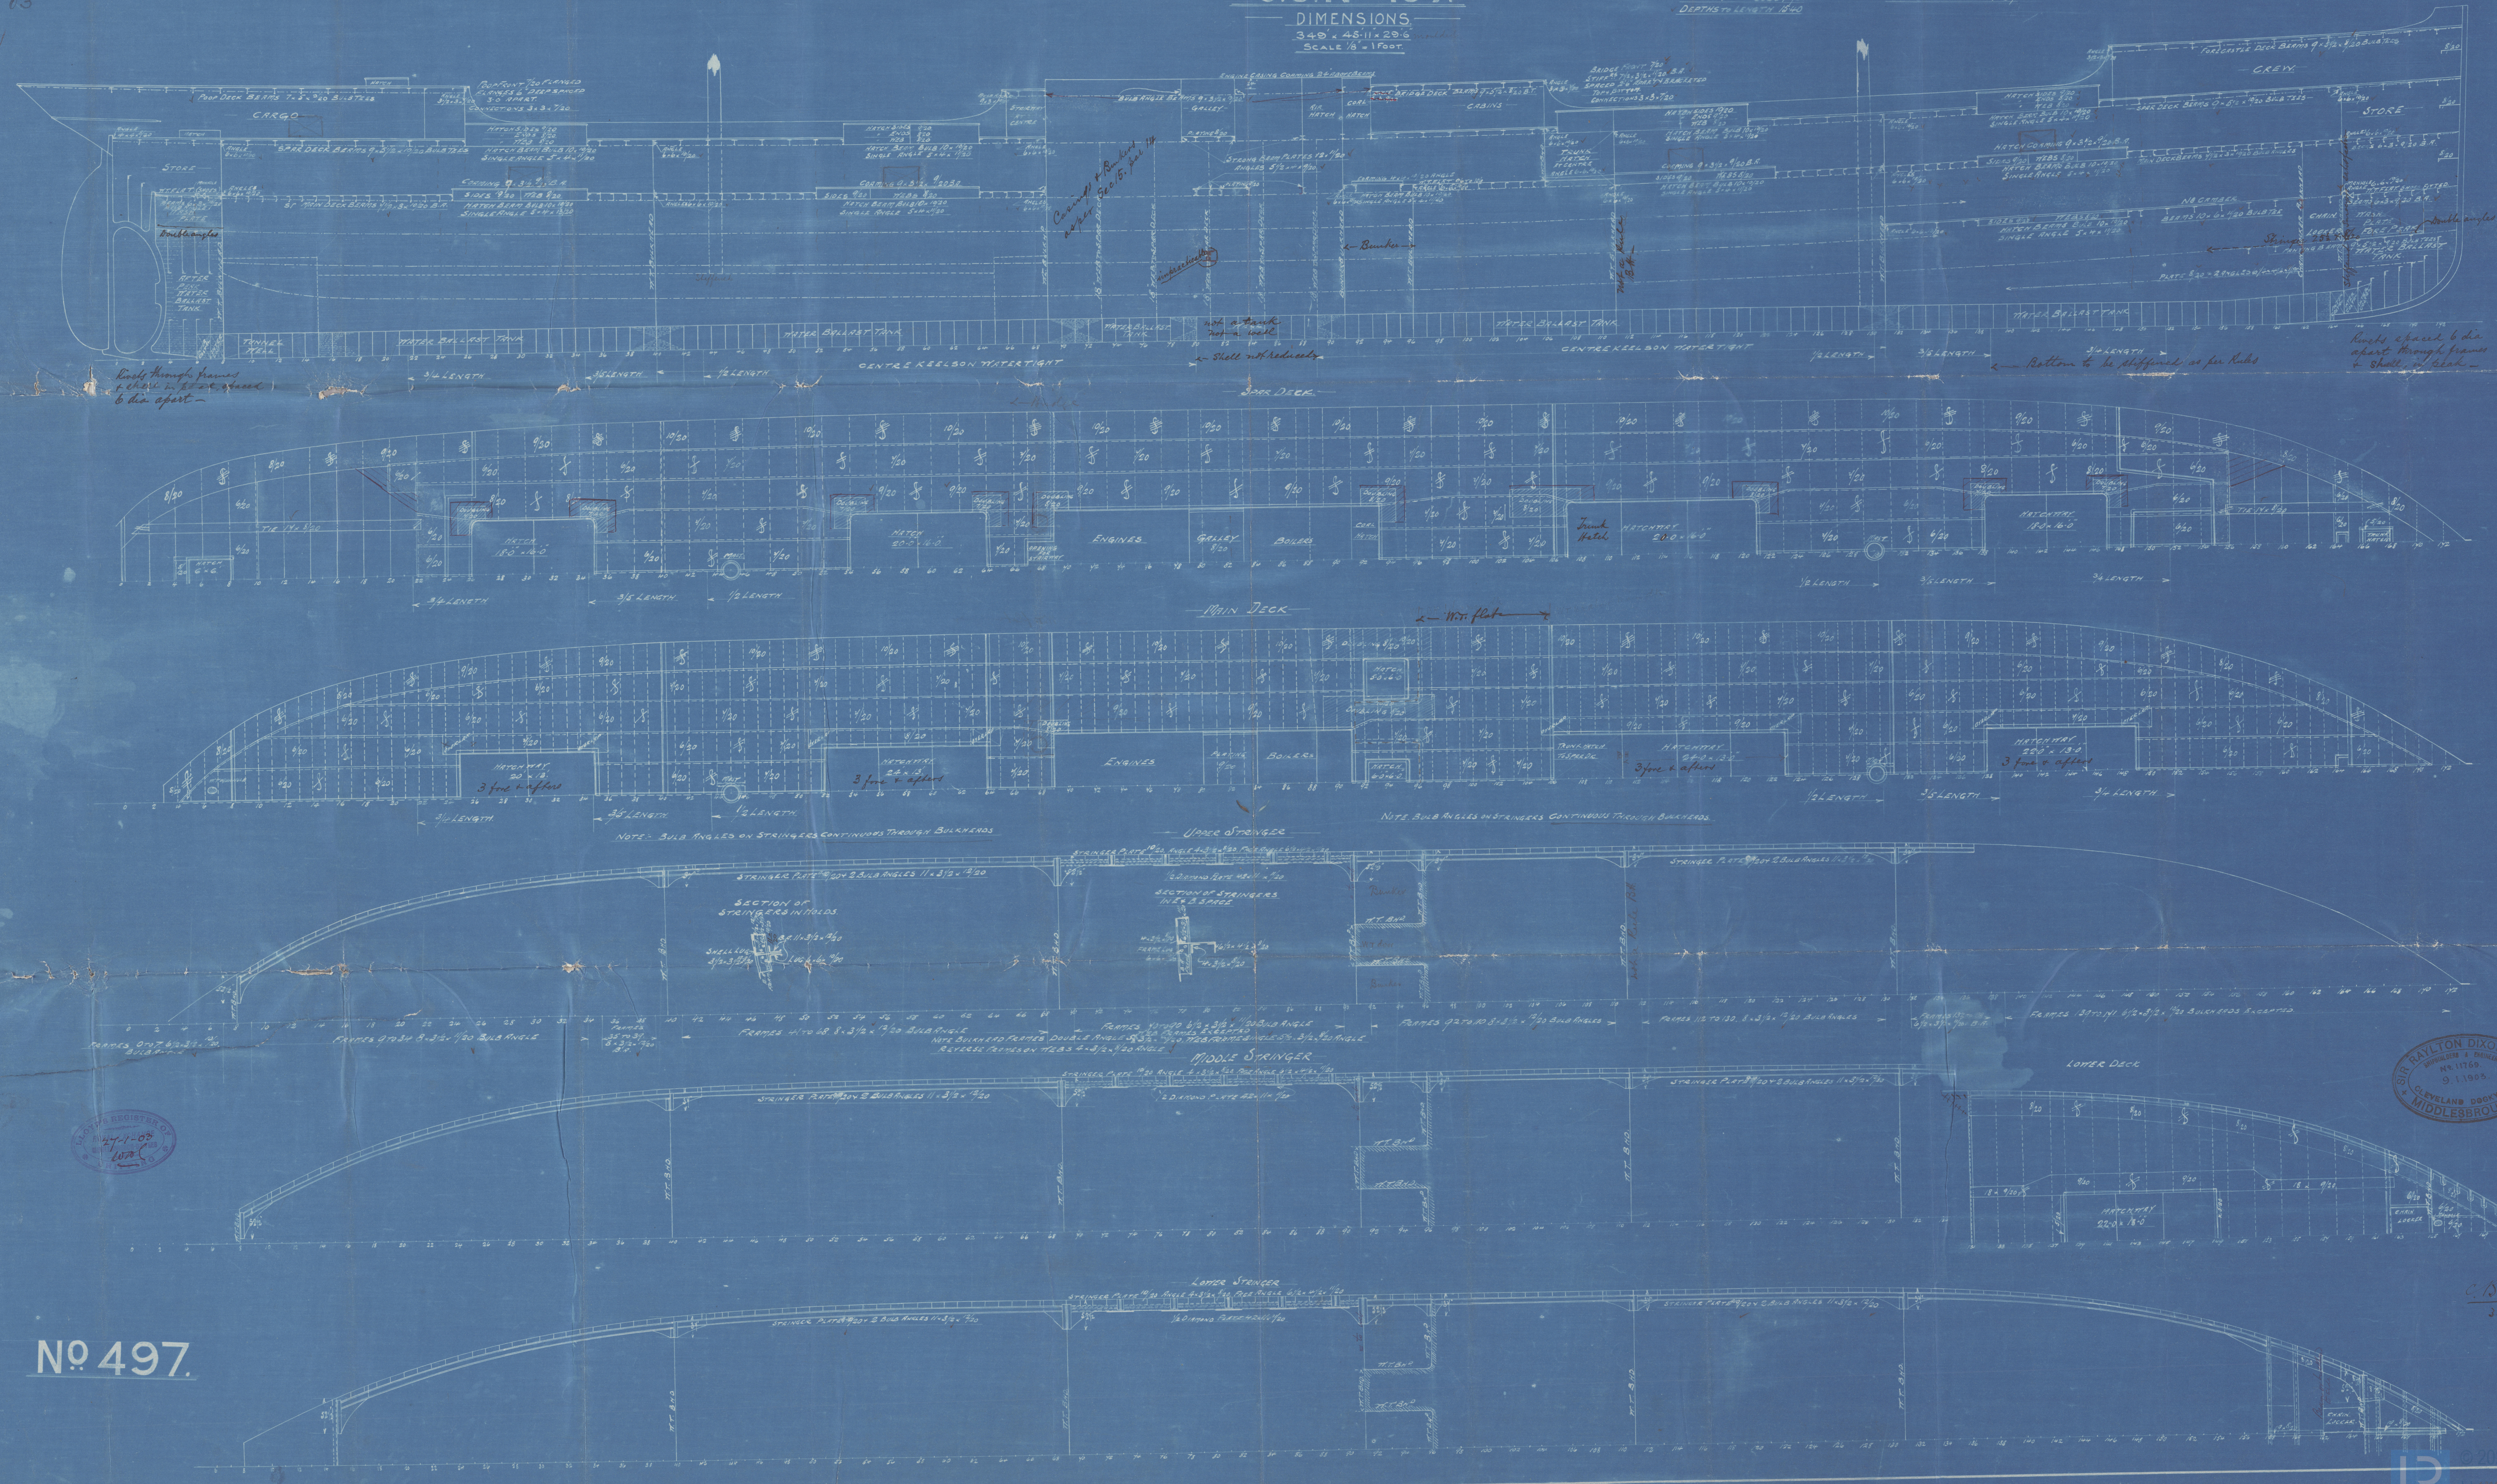

N<sup>o</sup> 497.

R. W. DIXON  
ENGINEER  
9.11.03  
CLEVELAND DOCKWORKS  
MIDDLEBROUGH



Sir R. Dixon & Co

No 499

Amended  
Profile & Deck plans



Ys "TJILATJAP".

Sub Report. No <sup>3644</sup>~~3618~~ (711).



© 2021

Lloyd's Register  
Foundation

006996-007007-0162