









Sir R. Dixon & Co



Nº 497

Amended  
Midship Section

S/S "TJILATJAP"  
Mableport. N<sup>o</sup> ~~3644~~ <sup>3644</sup> (H)

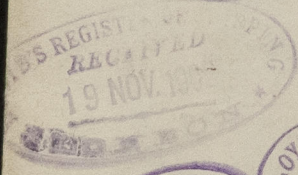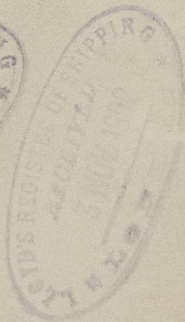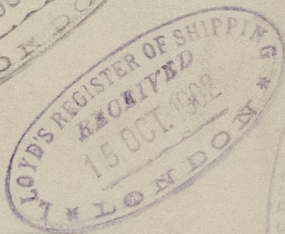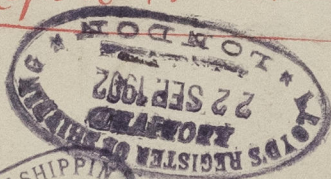

1208

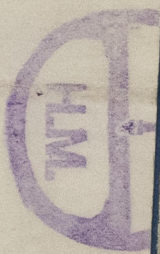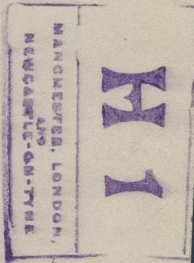


© 2021

Lloyd's Register  
Foundation

006996-007007-0163



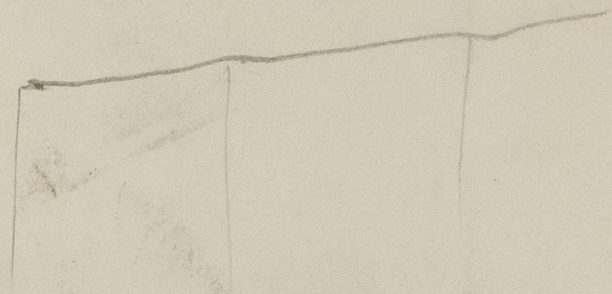

1 - 2 - 1

2 C

1 - 2

006496 - 007007 - 0163



© 2021

Lloyd's Register  
Foundation