



21.11.13.

# MIDSHIP SECTION STEEL SCREW TRAWLER No 597

123.4 B.P. x 22.6 EX. x 13.0 MOULDED


1/2 IN. SCALE

✓ BULWARK RAIL  $6\frac{1}{2} \times 3 \times \frac{7}{16}$  13.A.  
✓ SOLID 2 ROUND BEAD  $3 \times \frac{1}{2}$

✓ BULWARK PLATING  $\frac{5}{16}$

✓ SHEER STRAKE  $36 \times \frac{1}{16}$   
✓ FOR 1/2 LEN. TO  $\frac{9}{16}$

ROLLING CHOCK FOR 40' 0"  
9x50 BULB - 6x4x50 TEE

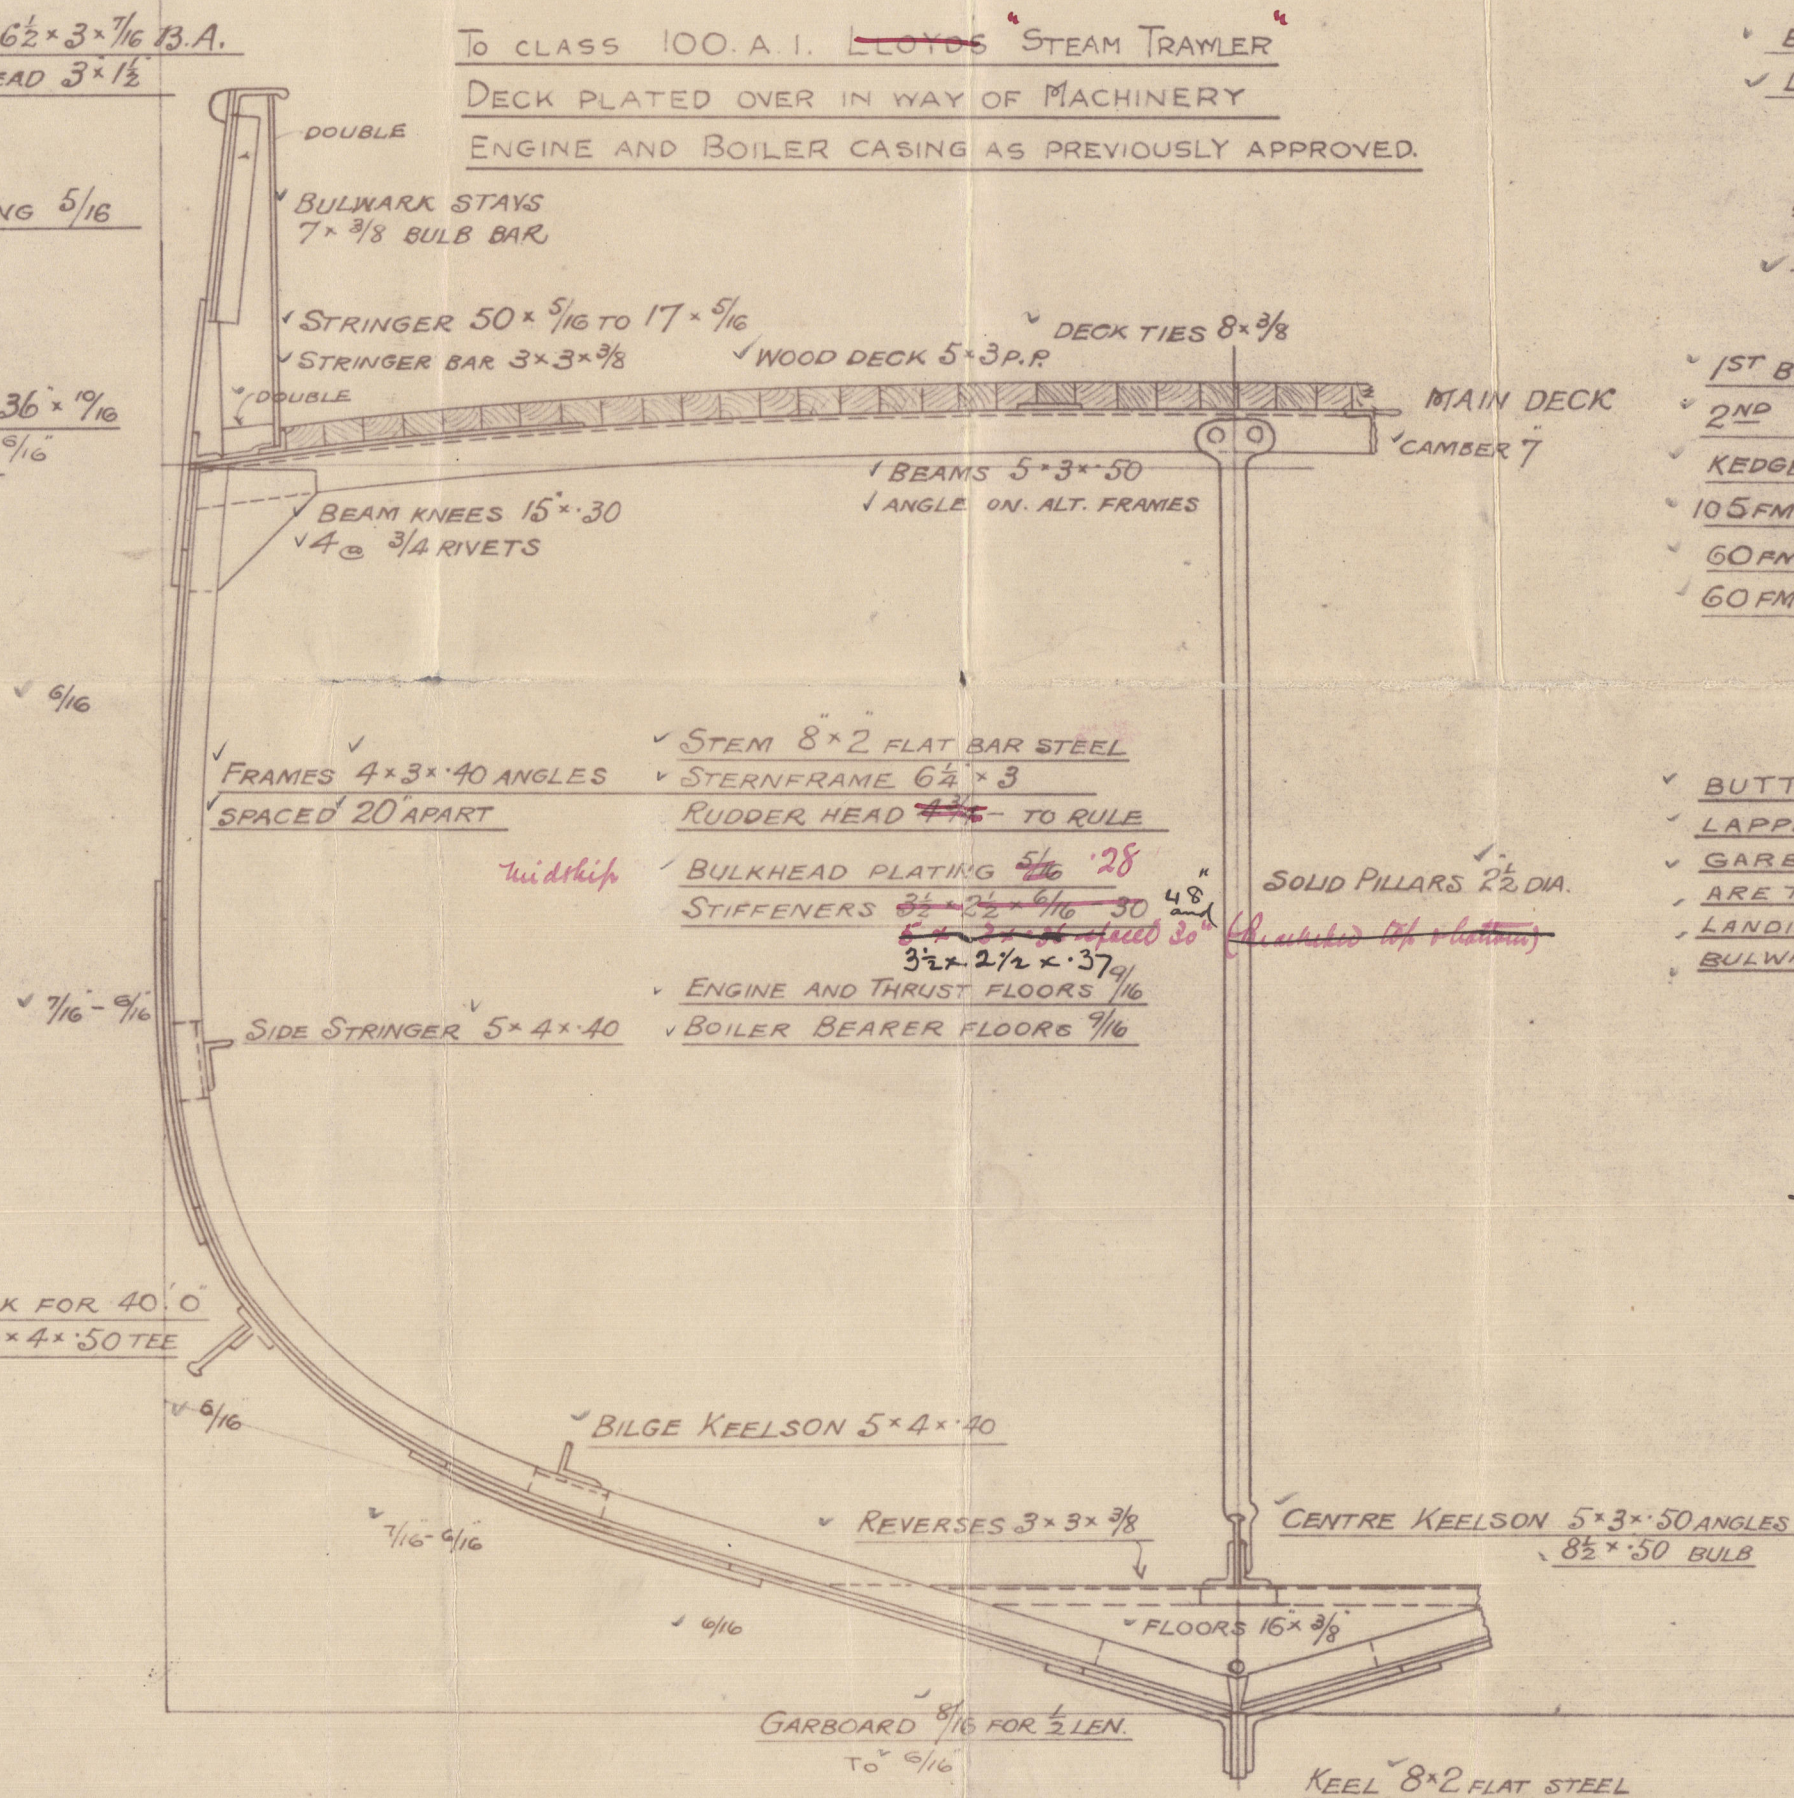

TO CLASS 100.A.1. LLOYD'S STEAM TRAWLER  
DECK PLATED OVER IN WAY OF MACHINERY  
ENGINE AND BOILER CASING AS PREVIOUSLY APPROVED.

PLAN No. 3601  
FOR ENCLOSURE TO  
Messrs Lloyd's Surveyors  
Hull FROM  
COCHRANE & SONS, LTD.  
SHIPBUILDERS, SELBY  
DATE 15/11/13

## NUMERALS

✓ B+D = 35.37 TRANS N°  
✓ L x (B+D) = 4362.18 LONG N°

## PROPORTIONS

$\frac{L}{B}$  5.5  
 $\frac{L}{D}$  9.48

## EQUIPMENT

✓ 1ST BOWER ANCHOR 7 CWTs - STOCKLESS  
✓ 2ND D° D° 6 1/4 D° D°  
✓ KEDGE ANCHOR 2 1/4 CWTs EX. STOCK  
✓ 105 FMS. 1 1/16" STUD CHAIN CABLE  
✓ 60 FMS 6" HAWSER  
✓ 60 FMS 4 1/2" WARP.

## RIVETING

✓ BUTTS OF SHELL PLATING TO BE  
✓ LAPPED & DOUBLE RIVETED EXCEPT  
✓ GARBOARD & SHEER STRAKE WHICH  
✓ ARE TO BE STRAPPED  
✓ LANDINGS DOUBLE RIVETED  
✓ BULWARKS SINGLE RIVETED.

*BBP*  
21.11.13.



© 2021

Lloyd's Register  
Foundation

006996-007007-0260



Cochrane & Sons

Nº 597

Midship Section

Virginian  
ex

S/S "Prince Palatine"

Hull report No:



© 2021

Lloyd's Register  
Foundation

006996-007007-0260





© 2021

Lloyd's Register  
Foundation