

21/12/15
30.12.15

PLAN No. 6254
FOR ENCLOSURE TO
Messrs. Lloyd's
Hull. FROM
COCHRANE & SONS, LTD.
SHIPBUILDERS, SELWICK
DATE 15/12/15

MIDSHIP SECTION.

STEEL SCREW TRAWLER

- No 700 -

- DIMENSIONS -

112.0 B.P. x 21.6 EX. x 12.3 MOULDED

CLASS 100.A.1.

- 1/2 IN. SCALE -

DECK PLATED OVER IN WAY OF MACHINERY SPACE


ENGINE AND BOILER CASING AS PREVIOUSLY APPROVED

NUMERALS

TRANSVERSE = $21.37 + 12.25 = 33.62$
LONGITUDINAL = $33.62 \times 112 = 3765$
DEPTHS TO LENGTH = 9.14
BREADTHS TO LENGTH = 5.24
DEPTH "CL" = 10.92


EQUIPMENT

- 1ST BOWER $4\frac{3}{4}$ CWTs. EX STOCK
- 2ND BOWER $4\frac{1}{4}$ CWTs. EX STOCK
- KEDGE $2\frac{1}{2}$ CWTs. EX STOCK
- 90 FMS $\frac{15}{16}$ STUD LINK CABLE
- 60 FMS $5\frac{1}{2}$ HAWSER
- 60 FMS 4" WARP

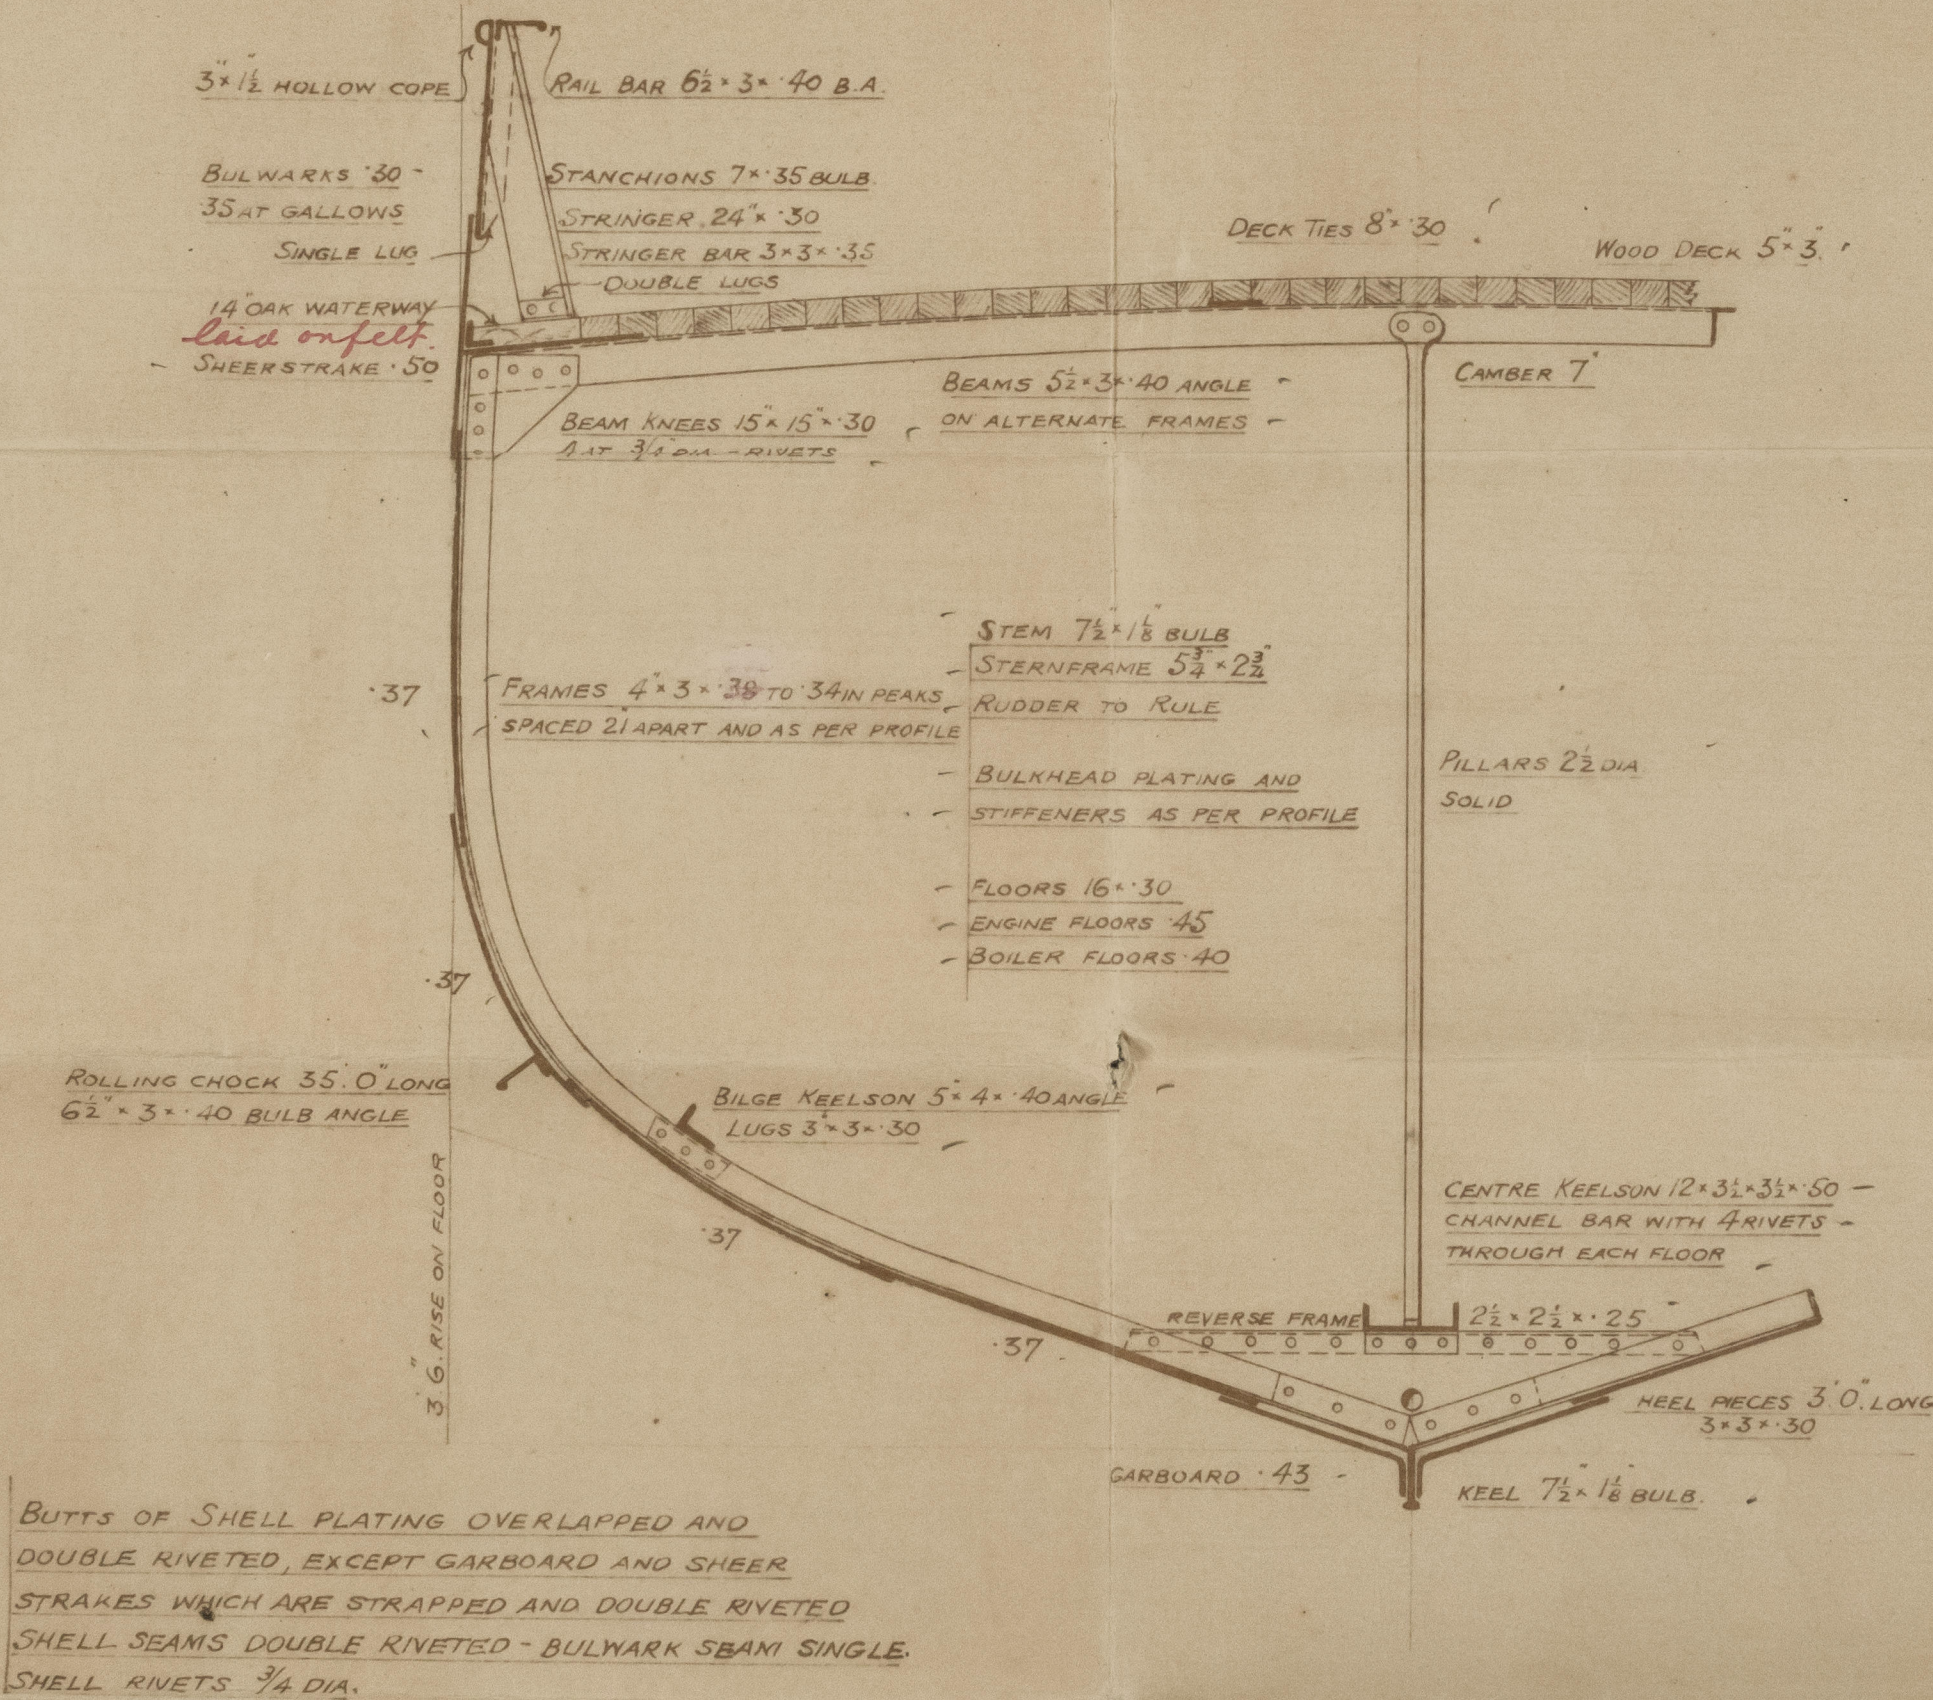


Jan 20.12.15

MIDSHIP SECTION
COCHRANE & SONS LTD
Nº 700

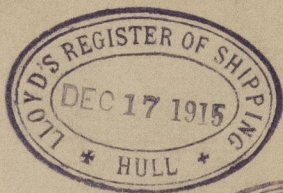

⁵/₈ "SERFIB" Hull Regt No. 29633.

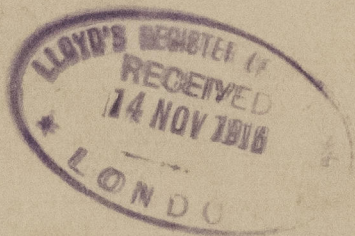

© 2020

Lloyd's Register
Foundation

007008-007020-0215