

MIDSHIP SECTION STEAM FERRY N^o 187

LENGTH 187'-0" BREADTH 35'-6" DEPTH 14'-0" MLD.


SCALE 1/4" = 1 FOOT

CLASS LLOYDS 100 A - FOR FERRY SERVICE IN SYDNEY, N.S.W.

NUMERALS
L x D = 187' x 14' = 2618
L x (B + D) = 187' x 49'6" = 9256.5
PROPORTIONS L/D = 13.35
B/D = 12.37

RIVETING
BUTTSTRAPS OF SHEERSTRAKE TR 3/8 L DR ENDS
BUTTSTRAPS OF STRAKE BELOW TR 3/8 L DR ENDS
BUTTS - STRINGER TR 1/2 L DR ENDS
BUTTSTRAPS - BOSS PLATES TR
BUTTSTRAPS - GARBOARD STRAKE TR 3/8 L DR ENDS
BUTTSTRAPS - OUTSIDE PLATING TR 3/8 L DR ENDS
BUTTS OF DECK PLATES DR 1/2 L SR ENDS
EDGES OF DECK PLATES SR

EQUIPMENT
1 - 3CWT ANCHOR ON STOCK
60 FATHOMS 3/8 CRANE CHAIN
60 FATHOMS 5 MANILLA TOW ROPE

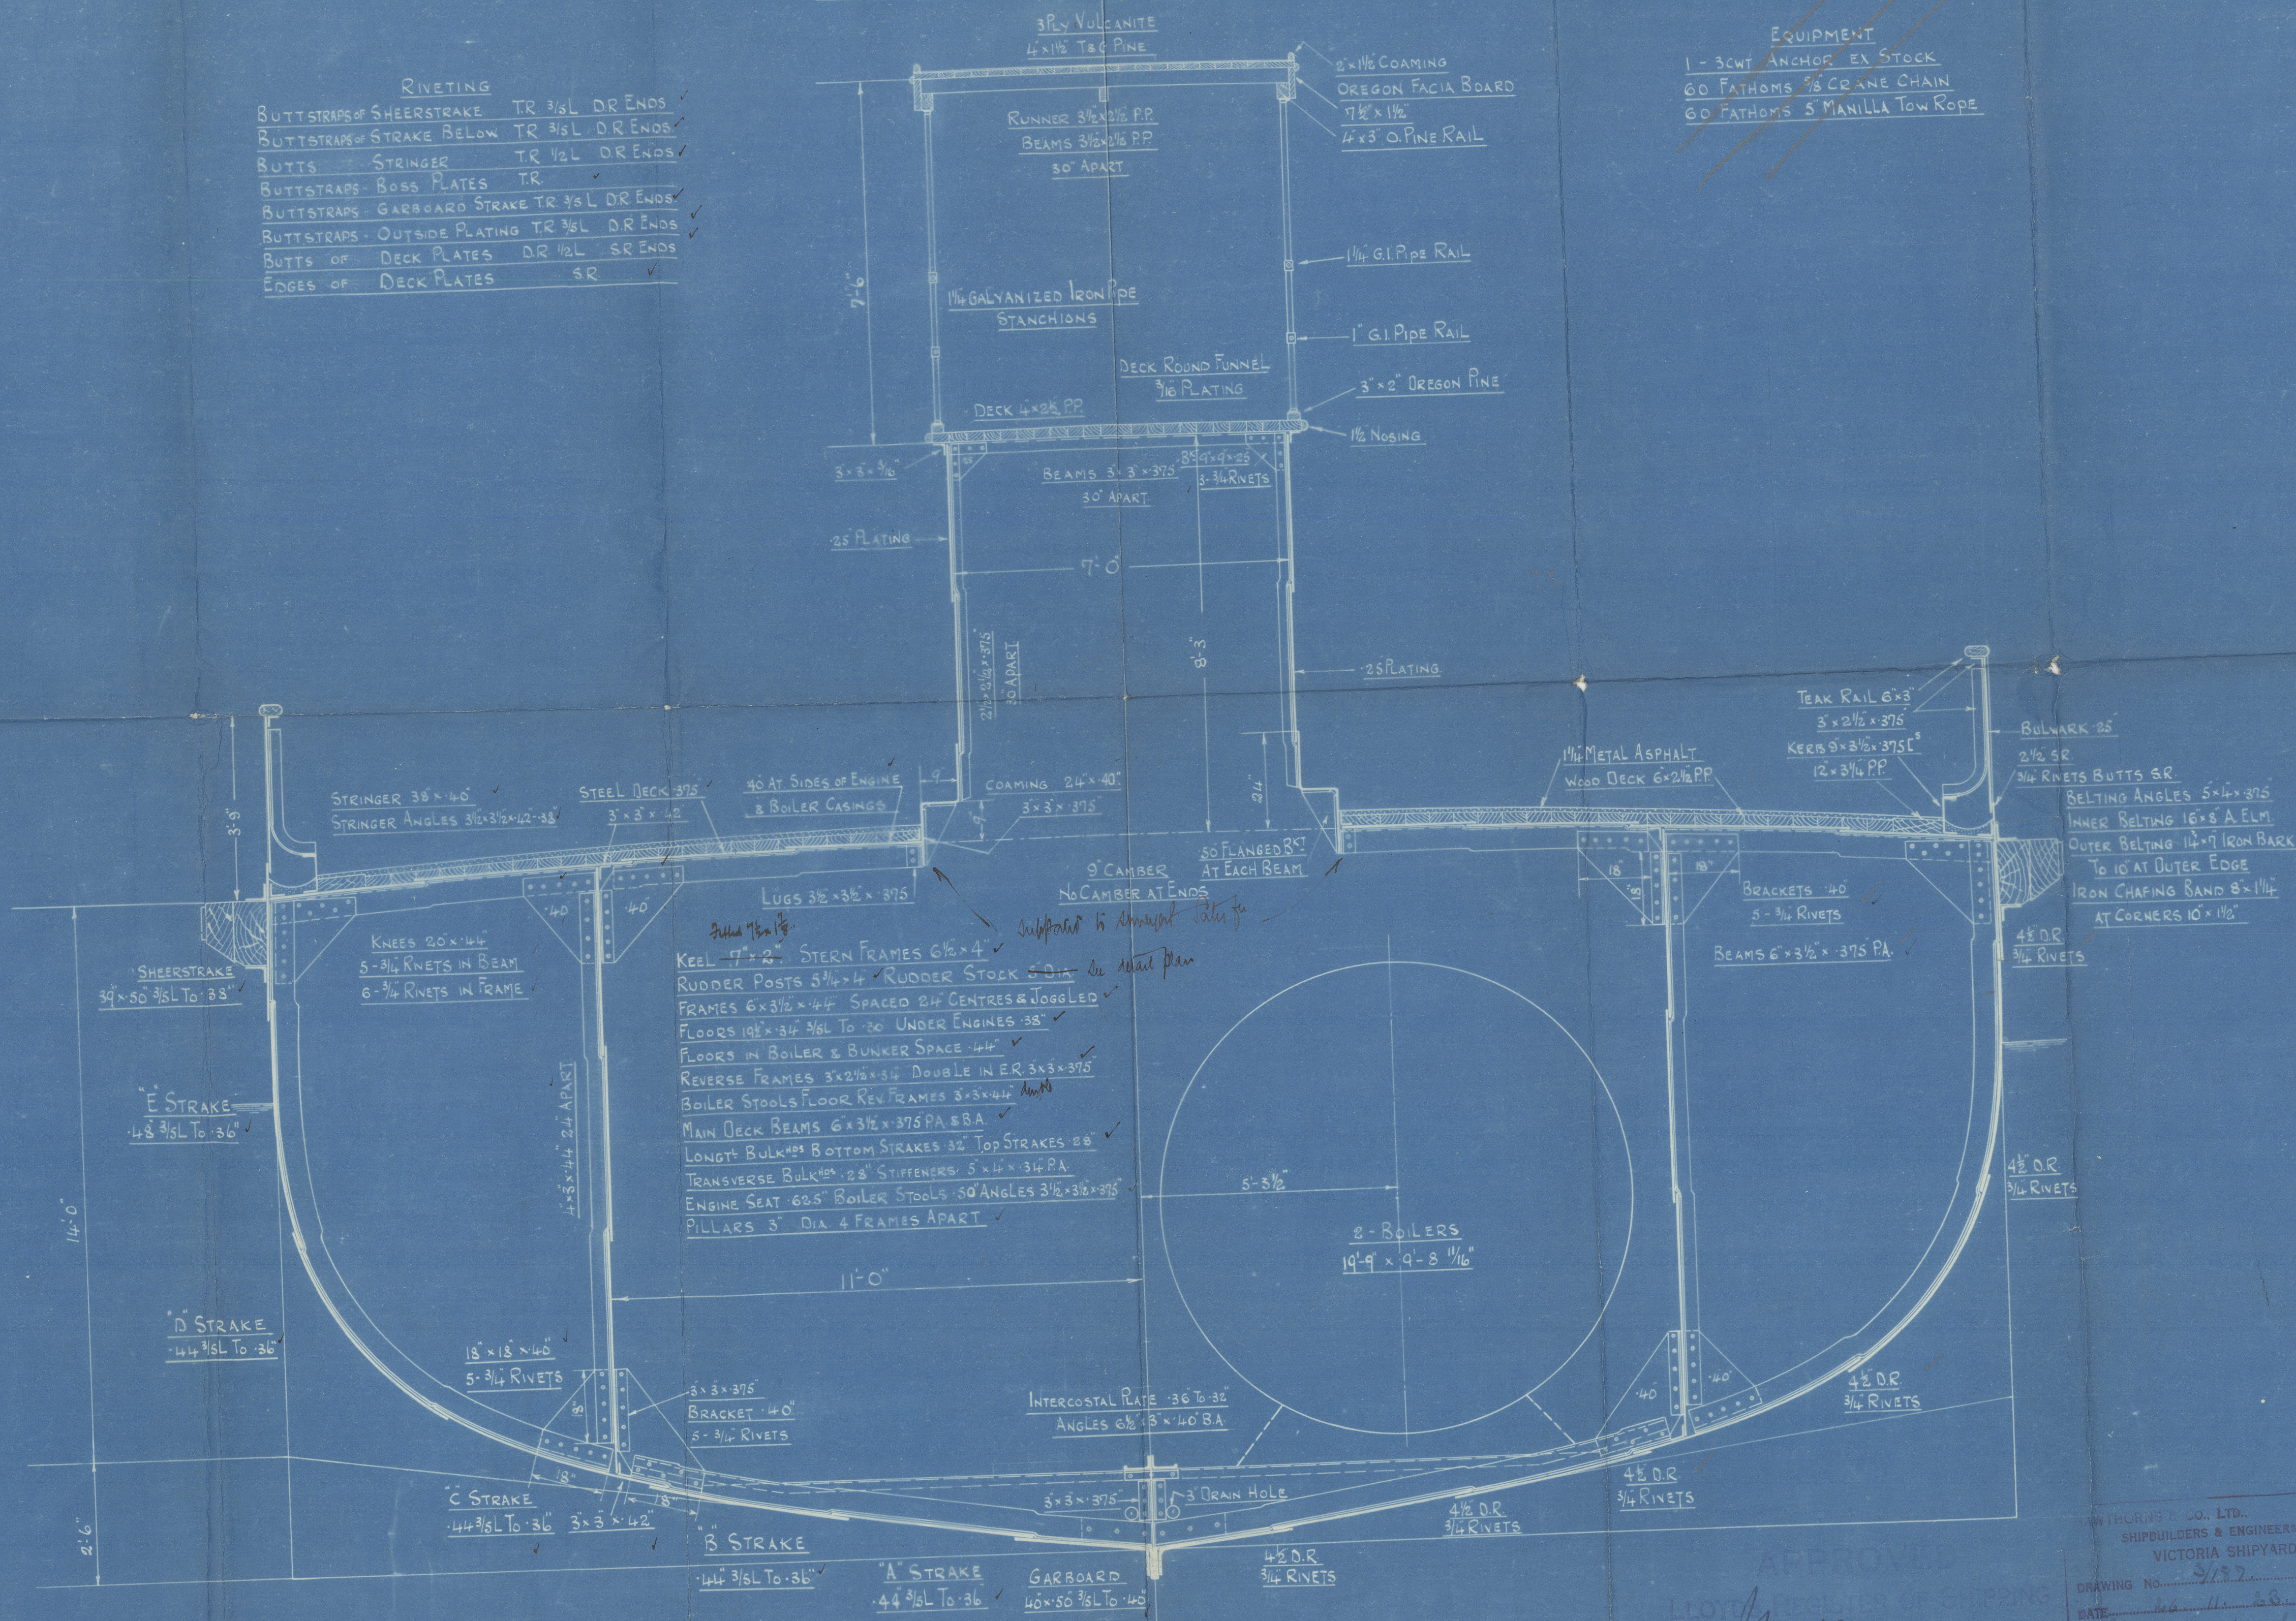

DRAWING N^o 3/187

APPROVED
LLOYD'S REGISTER OF SHIPPING

5-12-23

DATE 1.11.23

THORNHILL & CO., LTD.
SHIPBUILDERS & ENGINEERS
VICTORIA SHIPYARD, LEITH
DRAWING No. 3/187
DATE 1.11.23
TO: Lloyd's Register of Shipping

Hawthorn Ho. Rd.

Us. 187.

Midship Section.

St. "Kaondooloo"

Lh. 16503.

Lh.

007008-007020-0227



© 2020

Lloyd's Register
Foundation