


PROFILE & DECK PLAN  
OF  
STEEL TWIN SCREW ICE BREAKER

DIMENSIONS



LENGTH B.P. 120 FT. 0 IN.  
BREADTH MLD 30 FT. 0 IN.  
DEPTH MLD 11 FT. 6 IN.

SCALE 1/4 IN. = 1 FOOT.



25.5.14

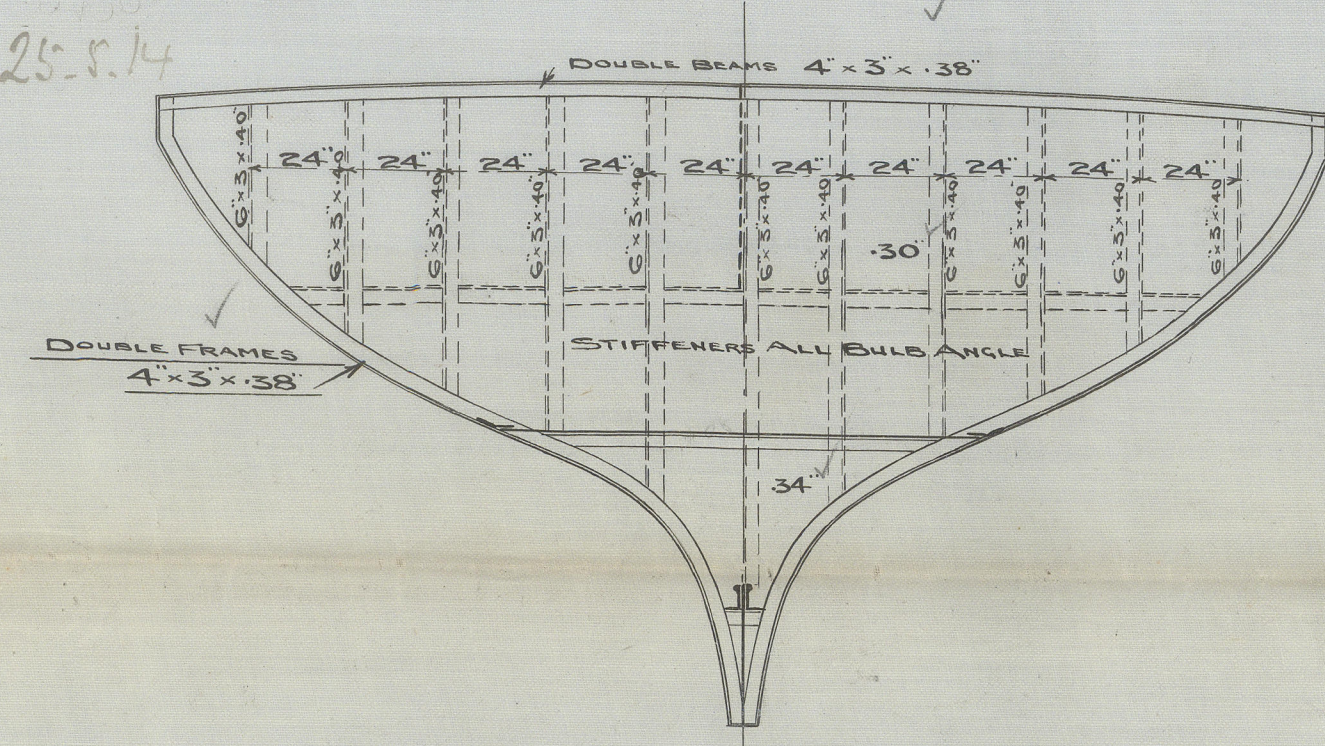


AFT PEAK BULKHEAD NO 5.  
LOOKING AFT.

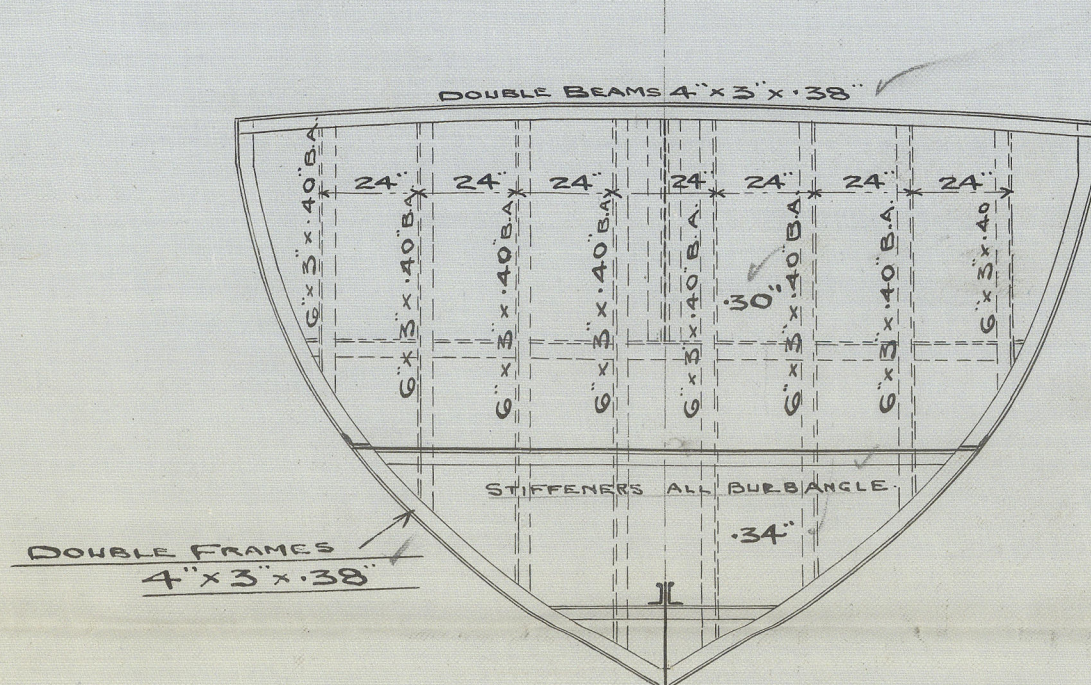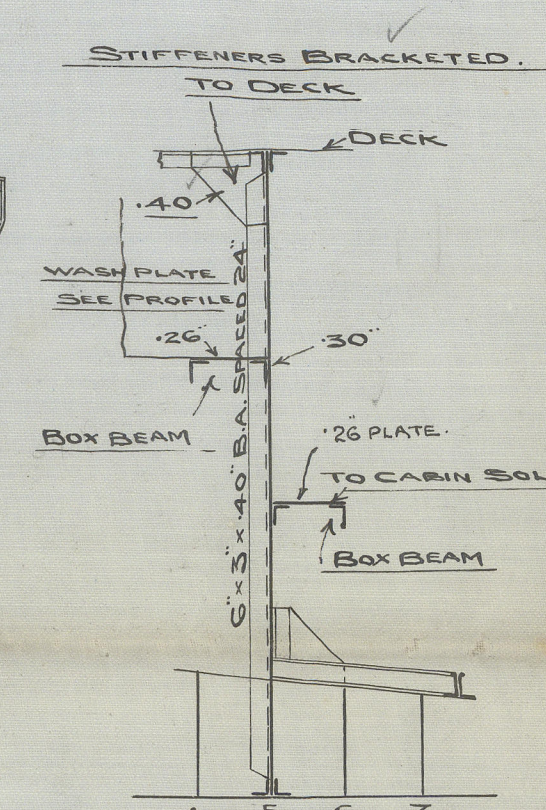

FORE PEAK BULKHEAD NO 59.  
LOOKING FORWARD.

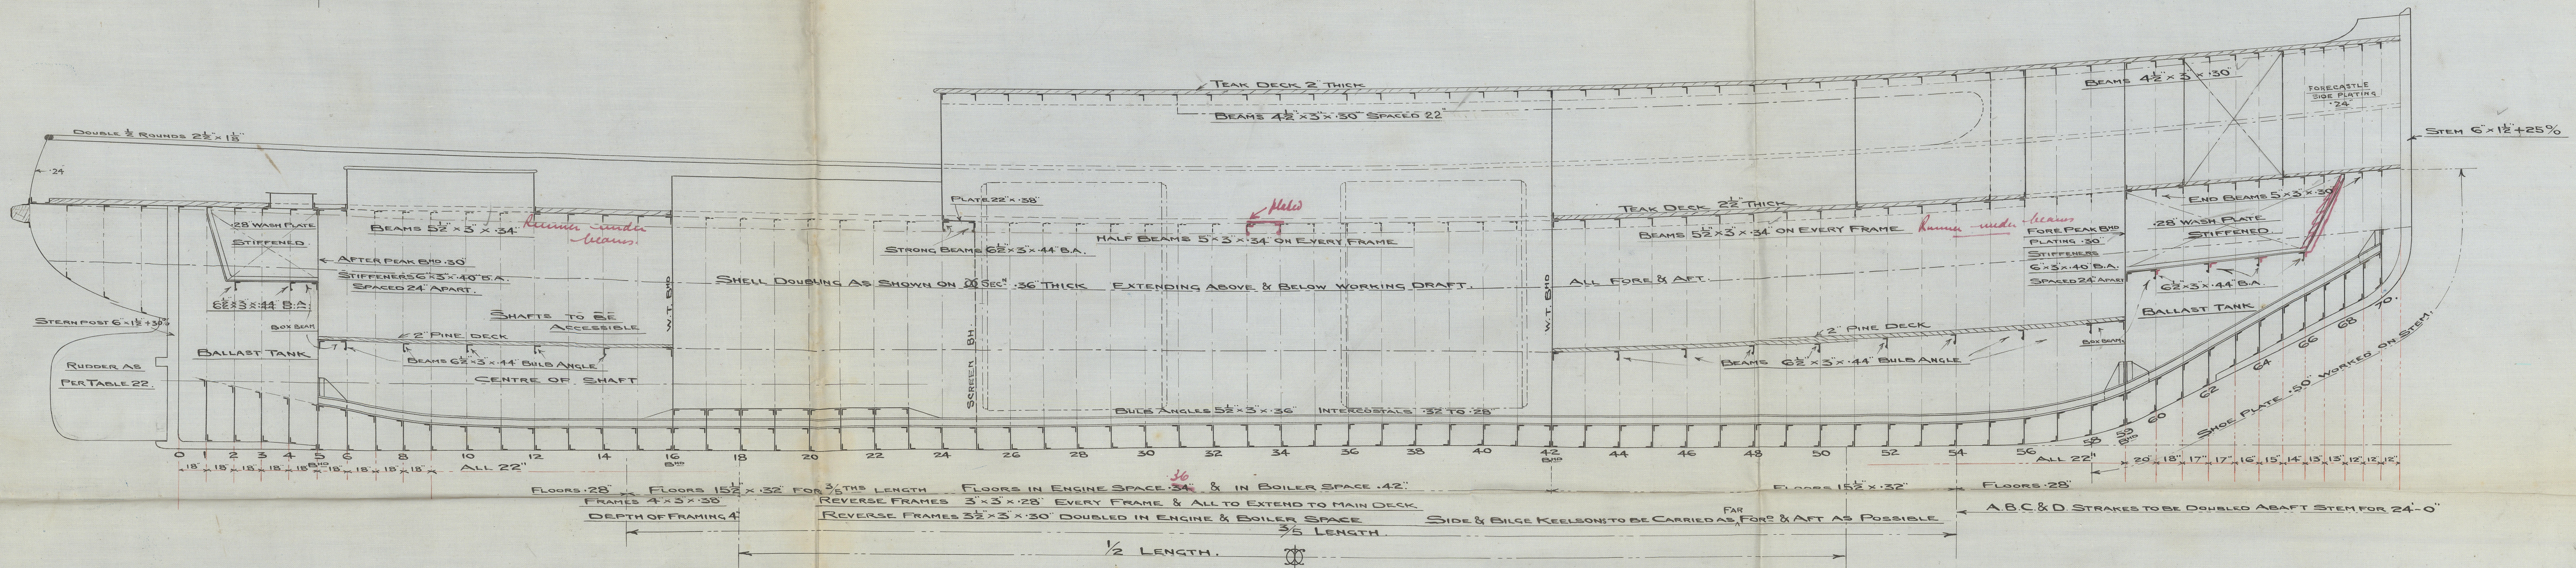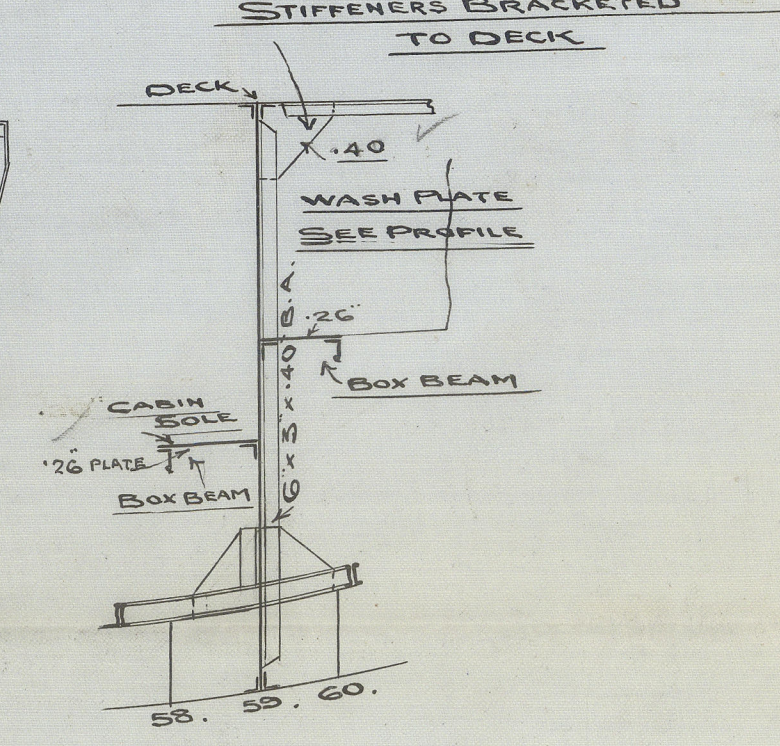

MAIN DECK

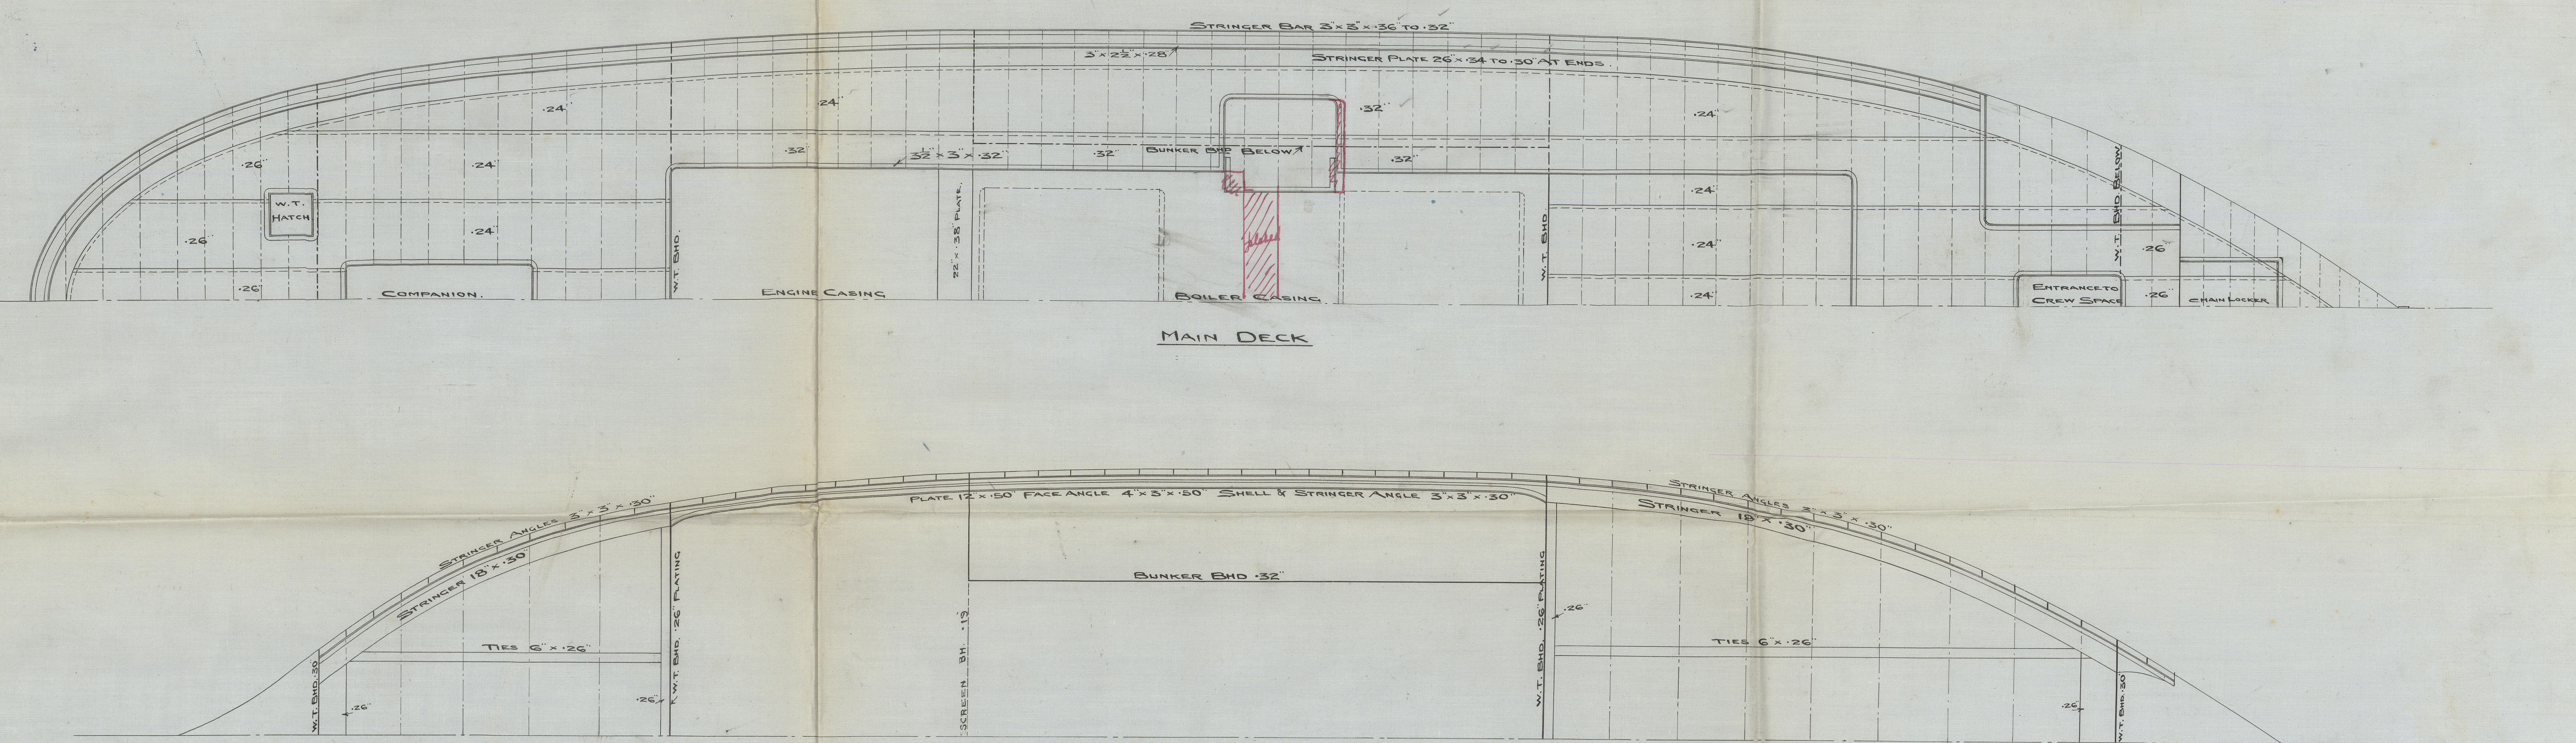

HOLD PLAN

5-5-14

DRAWING NO 4129

