

D.O.N. 1

Nº 101

STERNPOST & RUDDER

SCALE 1" = 1 FOOT

A x D NOT EXCEEDING 40

SPEED " 10 KNOTS

ALL TO LLOYDS REQUIREMENTS & TESTS

SPECIFICATION:-

STERNPOST COMPLETE, BOSS ROUGH BORED ENDS

OF BOSS MACHINED

RUDDER STOCK AND ARMS COMPLETE WITH PINTLES

BUSH AND LOCKING PINDAS SHOWN BUSH TO BE

FITTED TO FRAME

1" EYEBOLT TO BE SUPPLIED


STOCK TO BE MACHINED AT HEAD

DEC 18 1919



DEC 19 1919

J.H.B.

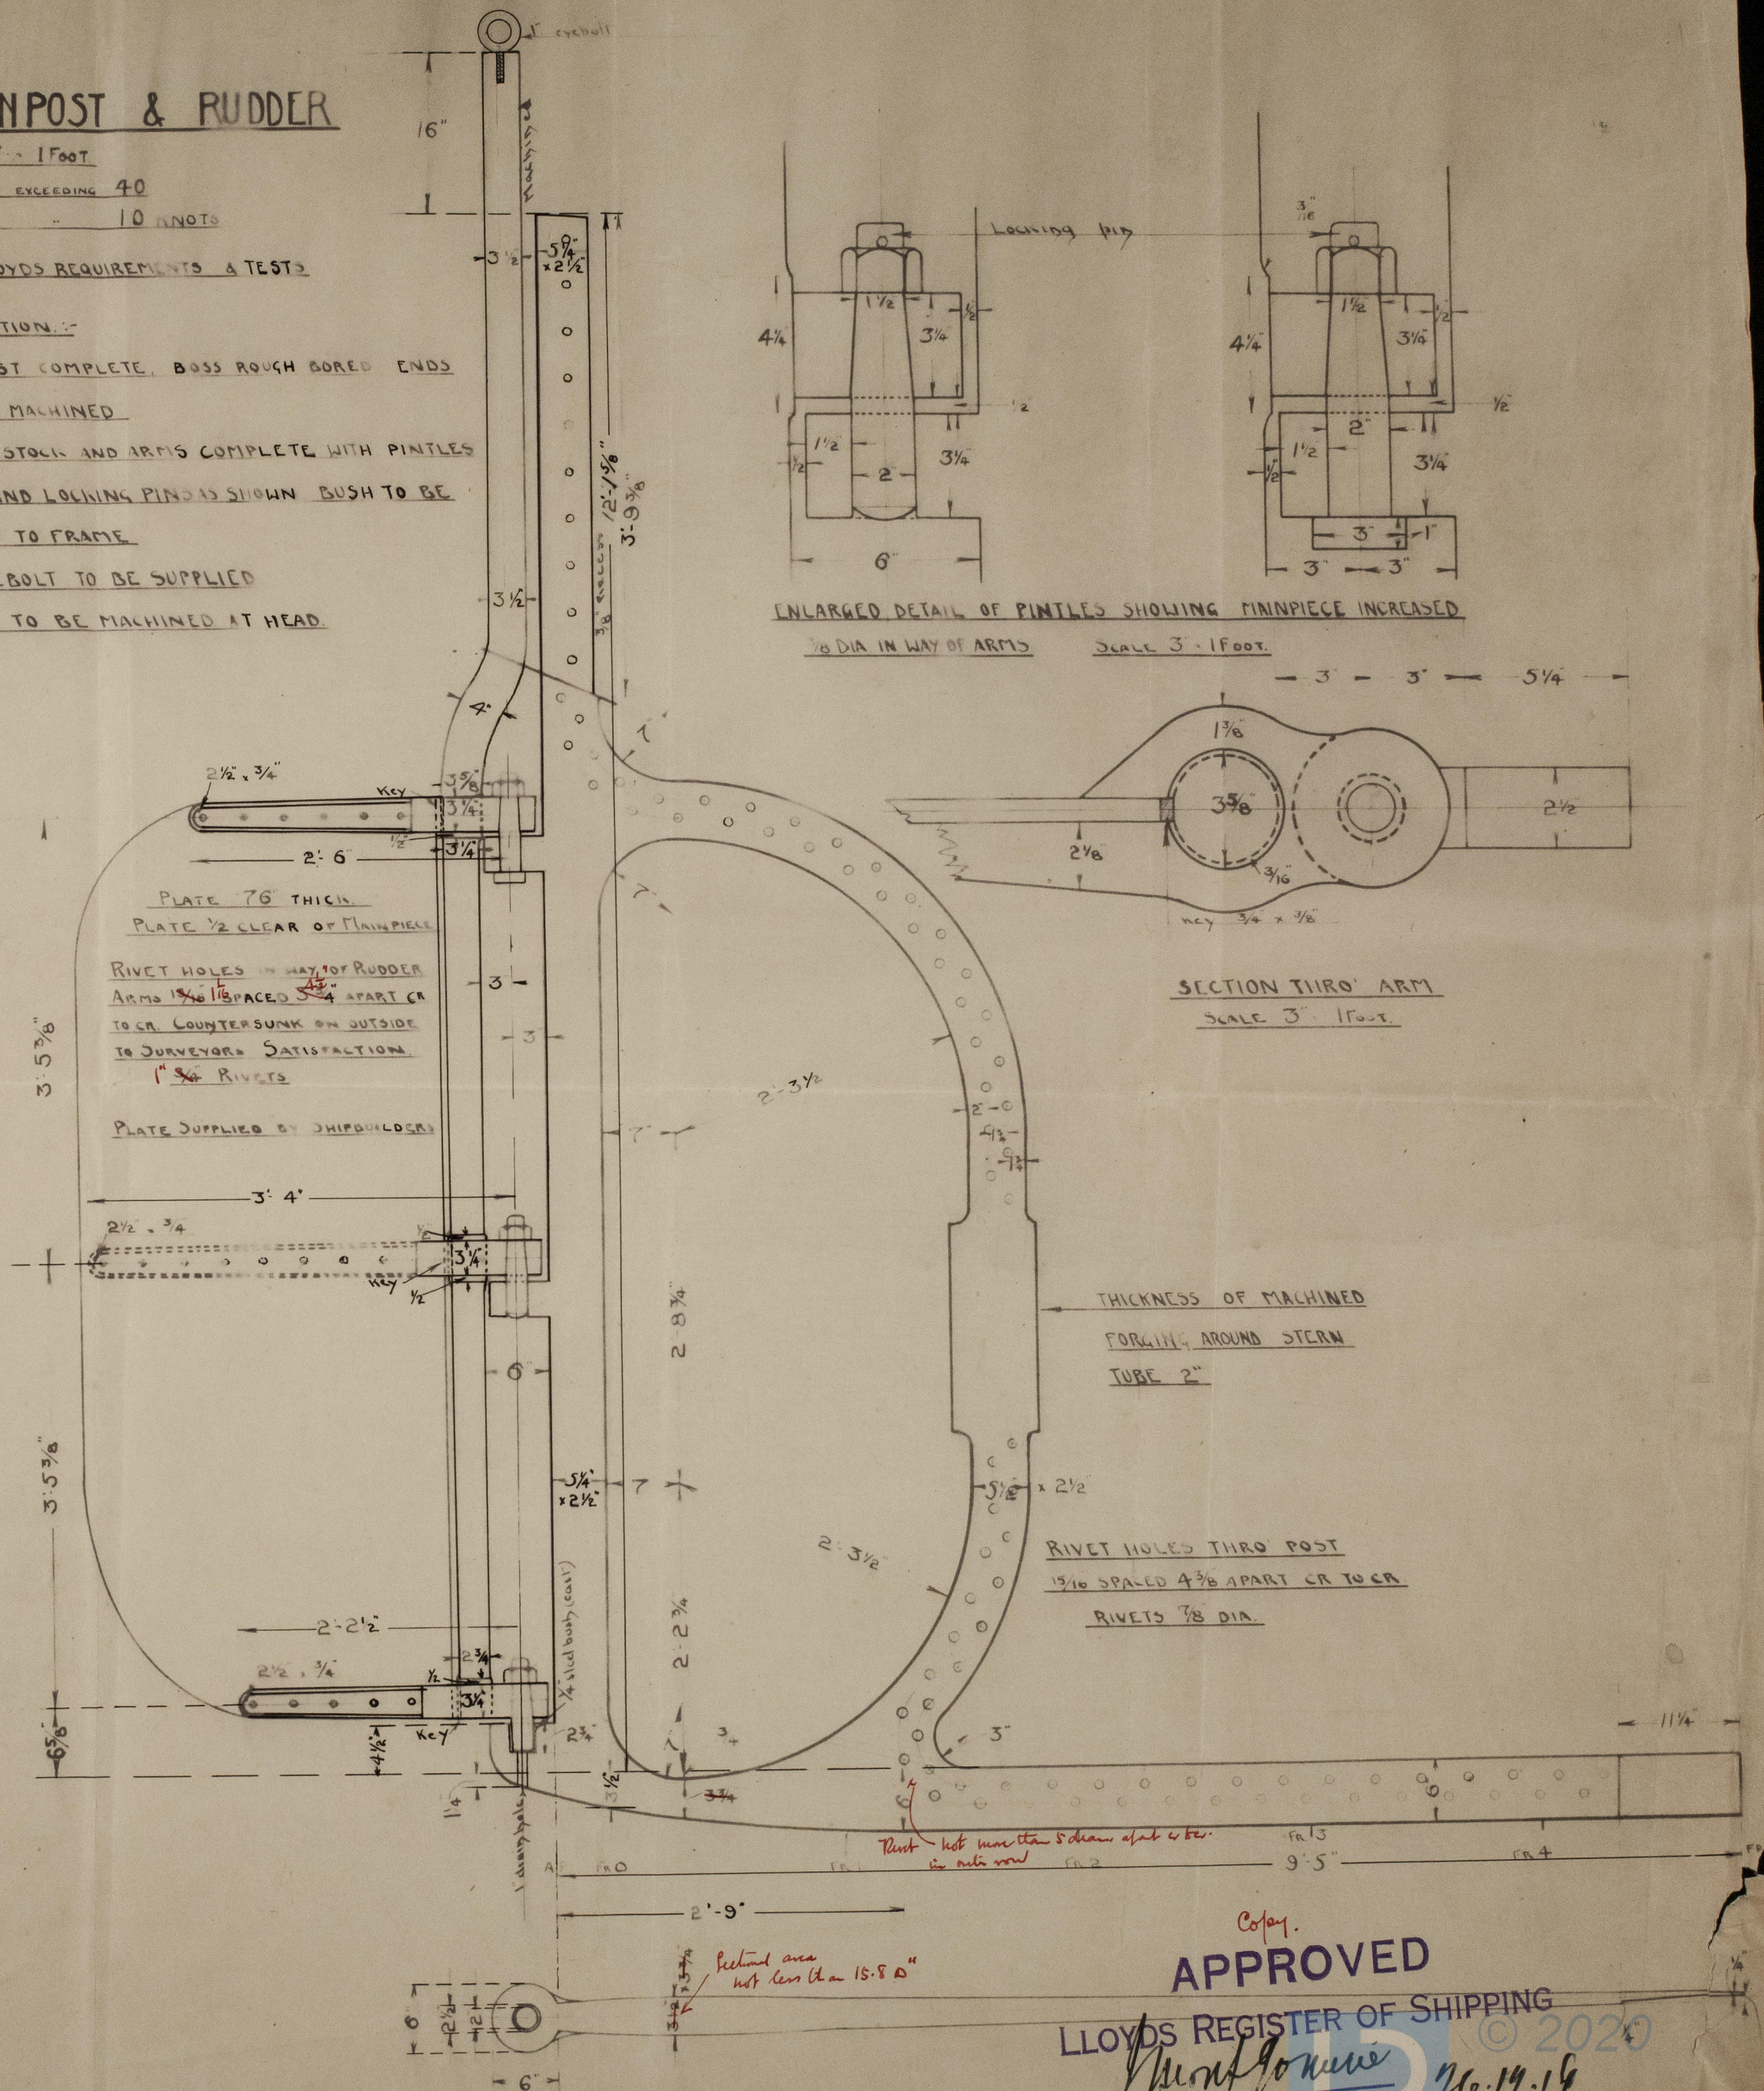

APPROVED

LLOYDS REGISTER OF SHIPPING

Montgomery

DATE 26.12.19

© 2020

Lloyd's Register Foundation

007045-007058-0124

STERN & RUDDER PLAN

COASTER CONSTRUCTION CO. LD.,

Yo. No. 101.

S.S. "MANSSONA"

DUN. RPT. No. 8354

3/4 "Elise Lassen."

Stem port & Rudder

No 101

Coaster Construction Co. Ltd.

100 00 000

007045-007058-0124



© 2020

Lloyd's Register
Foundation