

3.3.14

PROFILE & DECK PLAN



STEEL SCREW TRAWLERS

DIMS 129'-8" BP x 22'-0" EXT x 13'-4" MLP

SCALE 1/4" INCH

Nº 610-11-12-13

PLAN No. 4015
FOR ENCLOSURE TO
Messrs Lloyd's Register
FROM
COCKING & SONS, LTD.
SHIPBUILDERS, 89
DATE 28/1/14

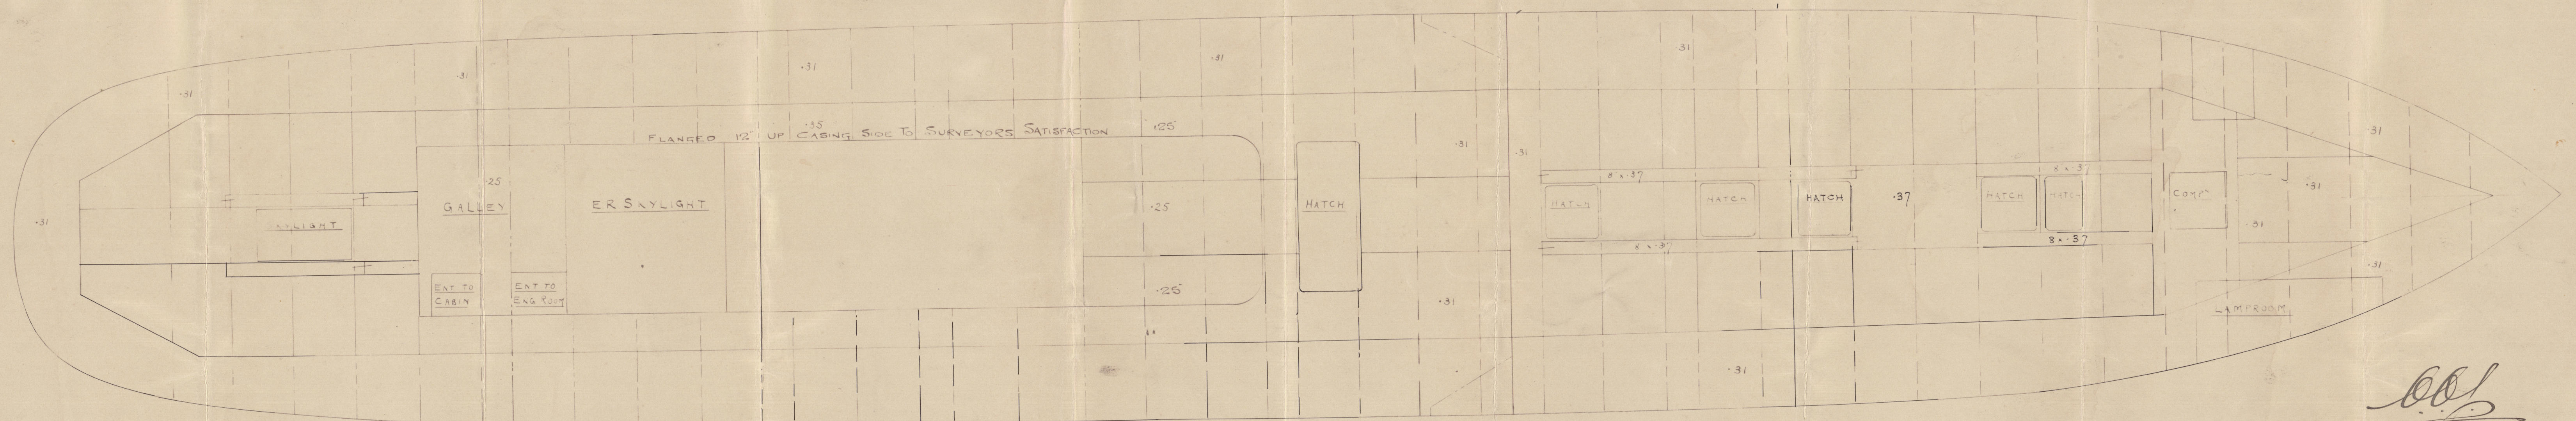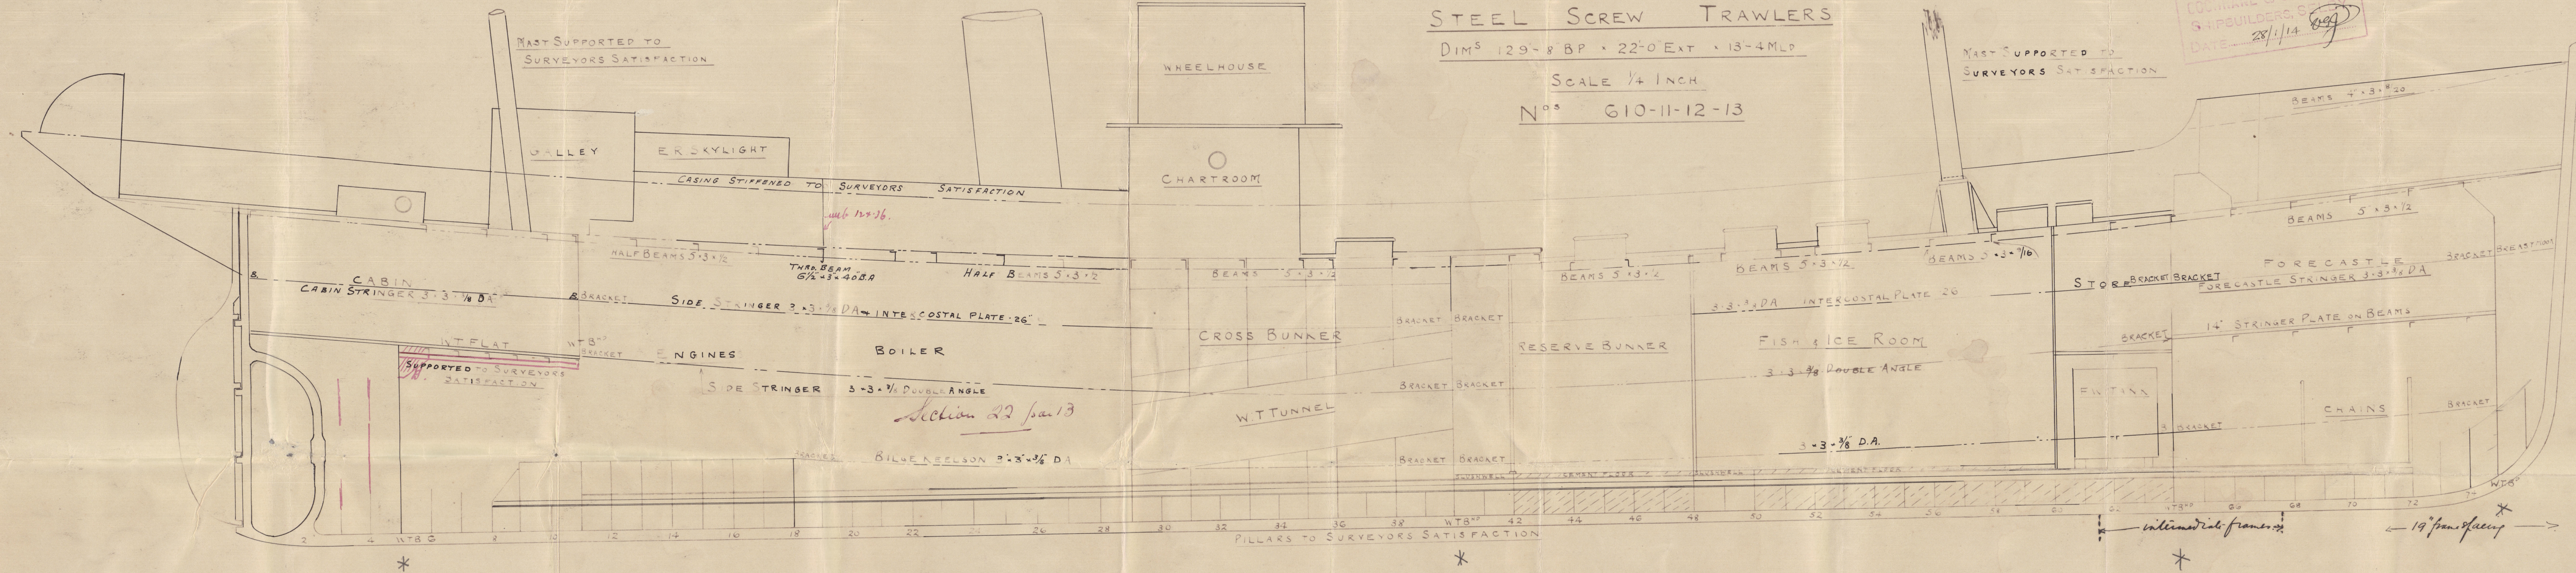

3.3.14.

Cochran & Sons
Nos 610, 11, 12 and 13.
Profile & Wecks.
Dimensions

129.66 x 21.87 x 13.33.

s/s Amanda Hull Rpt No 27921 610


s/s Viernoe Hull Rpt No 27977 611

s/s Lemberg " " 28122 612

s/s Longset- 28142 613



Transferred to Viernoe Dis Sec

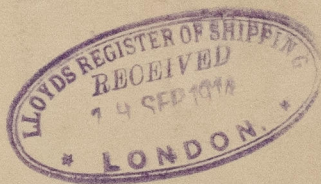

337

