


S.S. N^o 401.

2. 12. 01
12. 2. 02
3. 3. 02
10. 3. 02
28. 5. 02
4. 6. 02

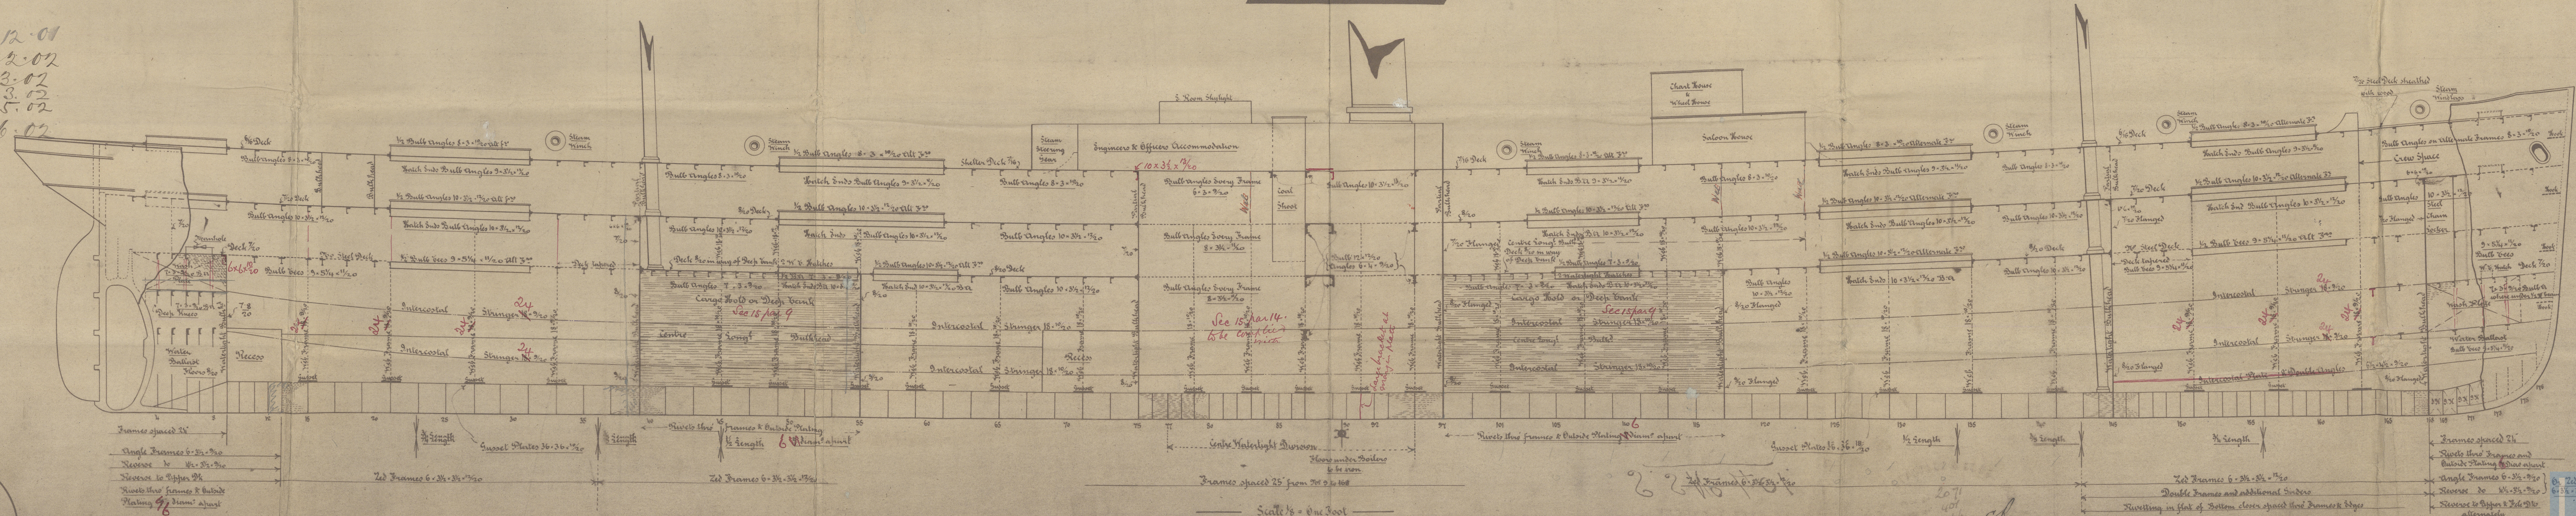





2094
401
26/11/05

PROFILE

Mr. J. L. Thompson & Co.

No 401

~~S.S. "MEDAN"~~ No 21098

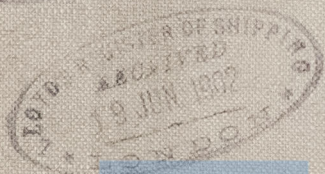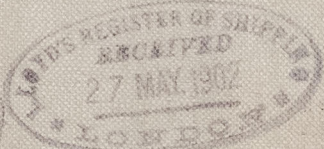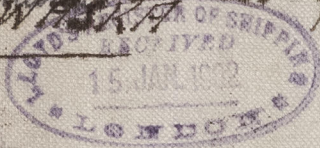 

© 2021

Lloyd's Register
Foundation

007059-002031-0156